


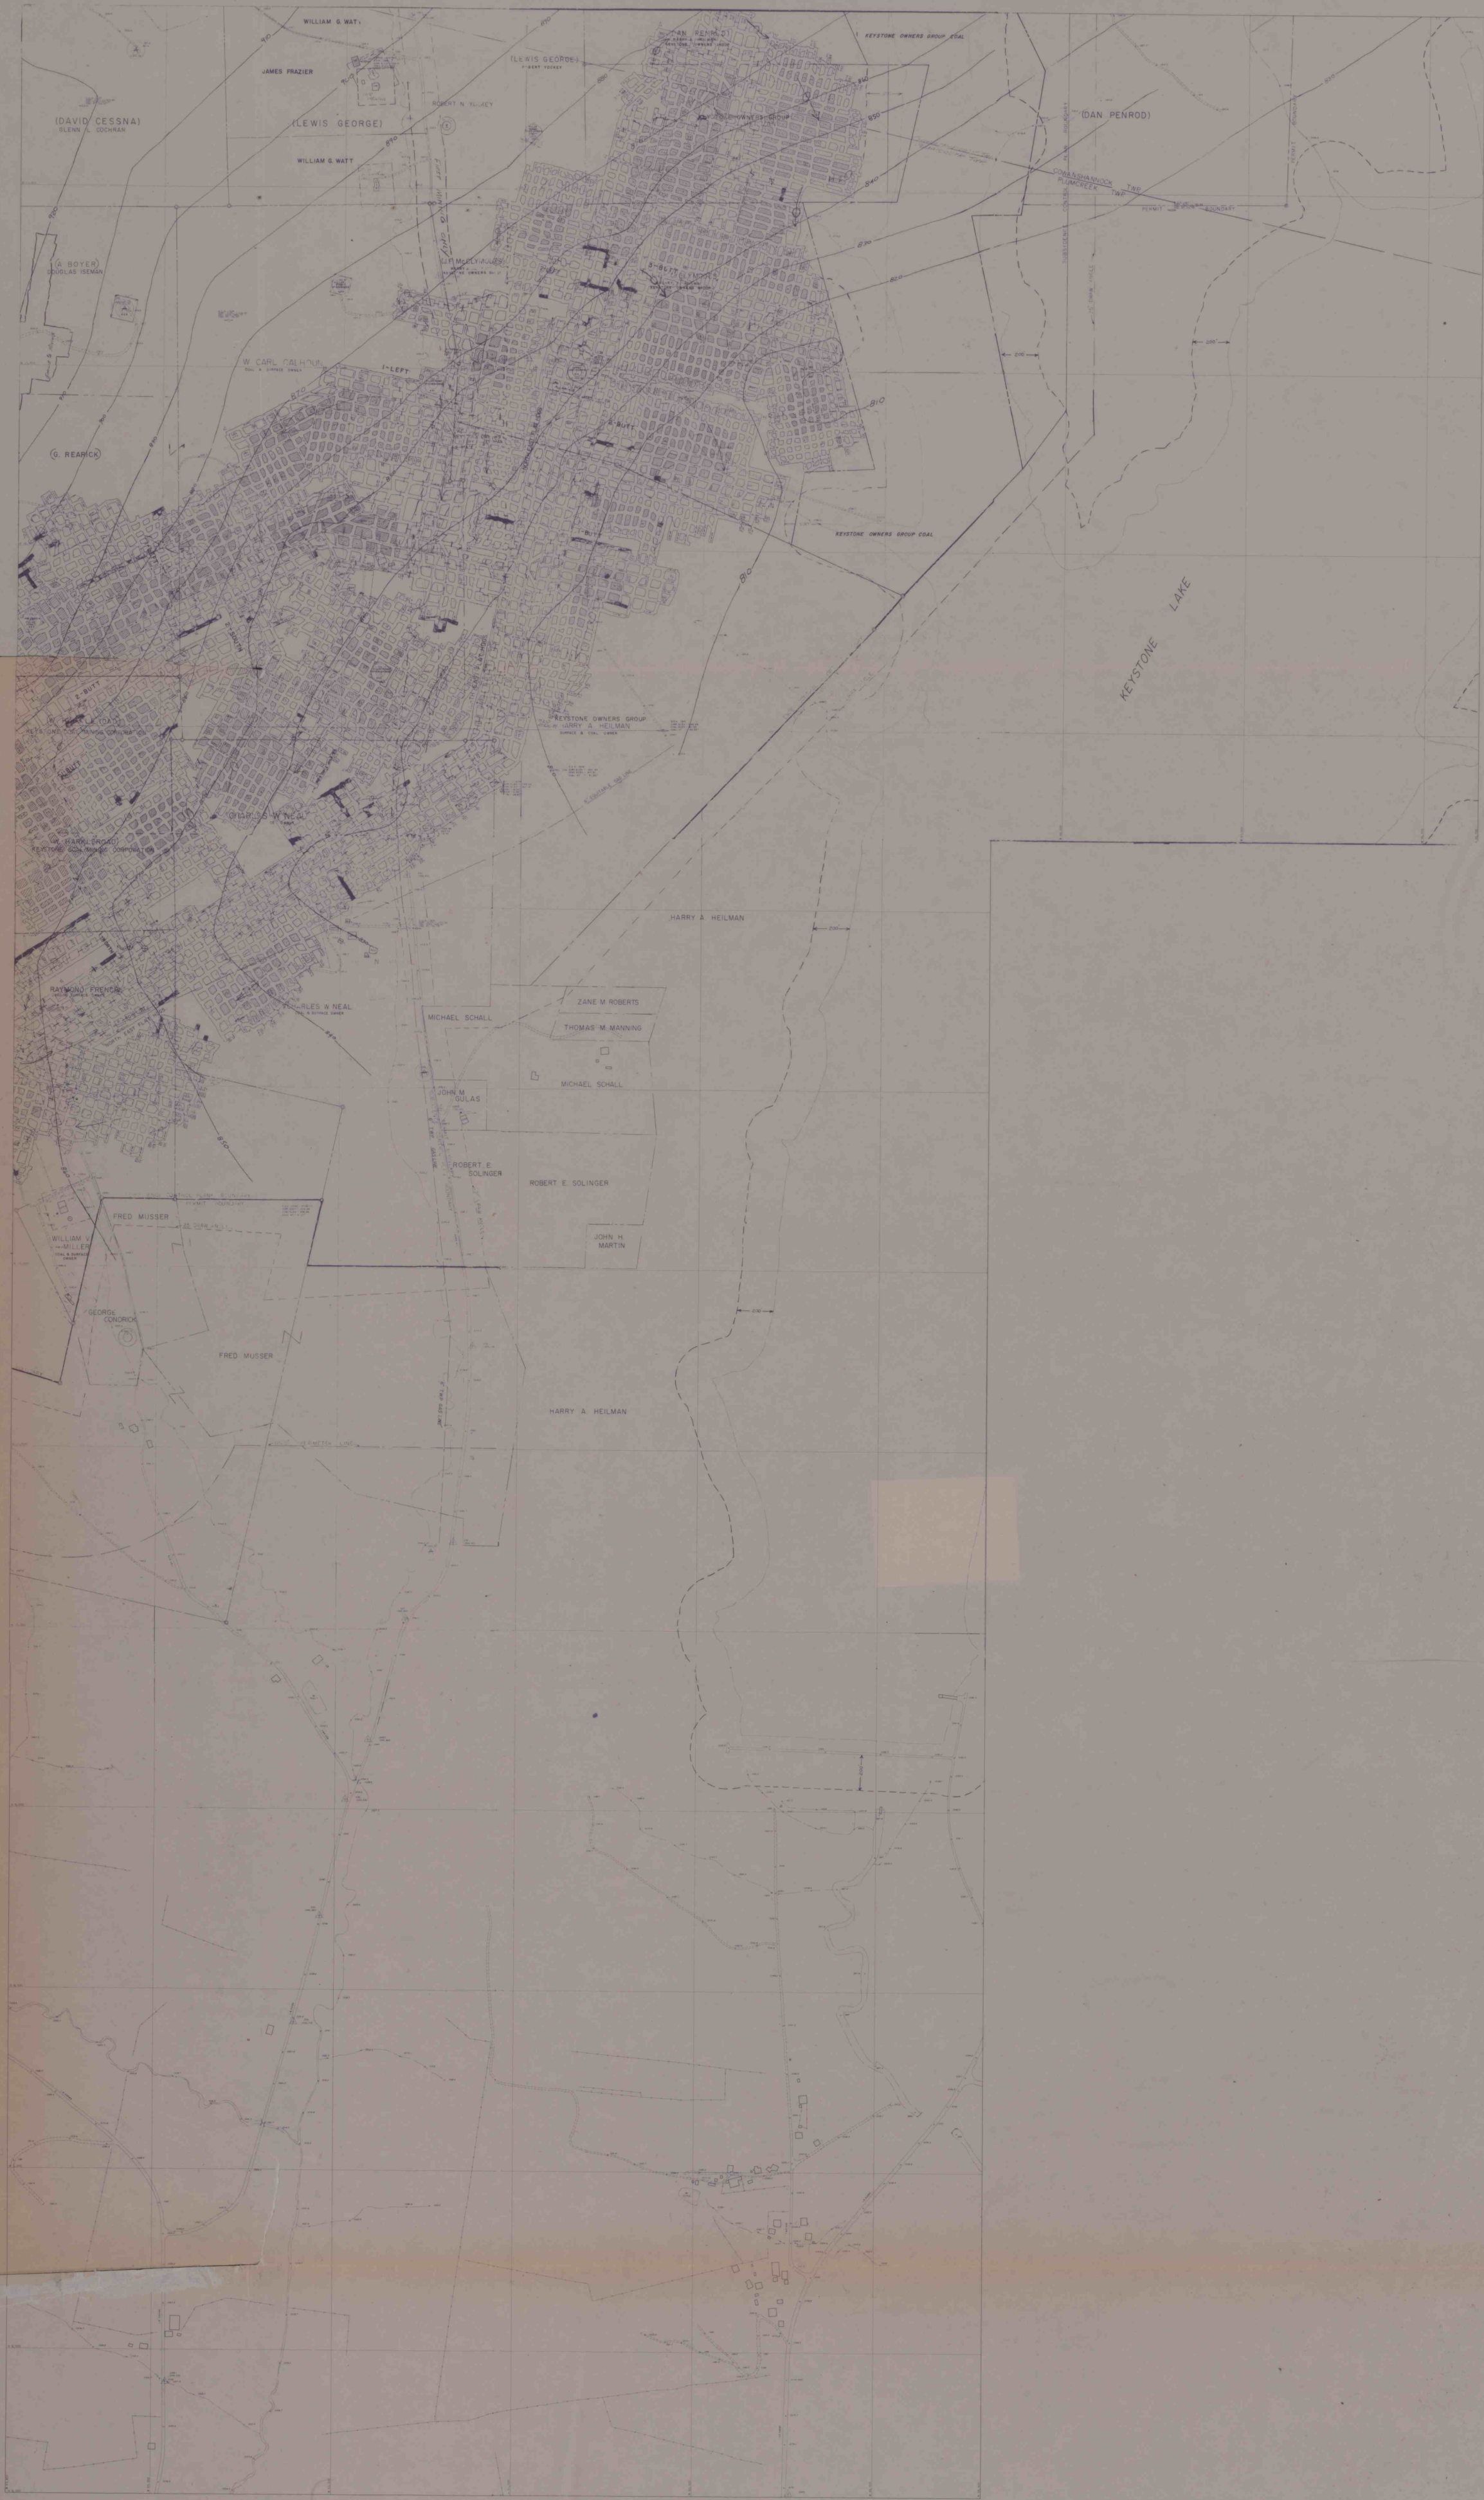

MATCH TO SHEET 2



David A. Cobalish


**KEYSTONE COAL MINING CORP.
JANE MINE**

PLUMCREEK & COWANSHANNOCK TWP.
ARMSTRONG CO.
PERMIT NO. 03831305
FINAL MINING
SCALE 1"=400'

JANE MINE (MSHA) No. 3600823
JANE MINE PERMIT (DER) No. 03831305

(COAL SEAM)
LOWER FREEPORT

JANE MINE Sheet 7 of
KEYSTONE COAL MINING CORP. Permit Maps
PLUMCREEK & COWANSHANNOCK TWP. ARMSTRONG CO.
JME-400-07

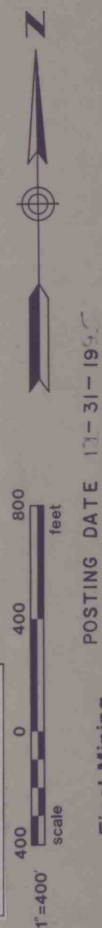

Final Mining