

MATCH

LINE

TO

SHEET

D-26

D-34

MATCH

LINE

TO

SHEET

D-35

MATCH

LINE

TO

SHEET

D-42

MATCH

LINE

TO

SHEET


D-42

MICROFILMED

POSTED
JAN 15 1973

RECEIVED
DIVISION OF
MINE REGULATION
FEB 1973
MAMURRAY
PENNSYLVANIA

LEGEND	
Contemplated Mining 1-15-73 To 7-15-73	[Red outline box]
Support Area	[Dashed line box]
Protected Structure	[Red solid box]
Mining Completed Area	[Blue solid box]

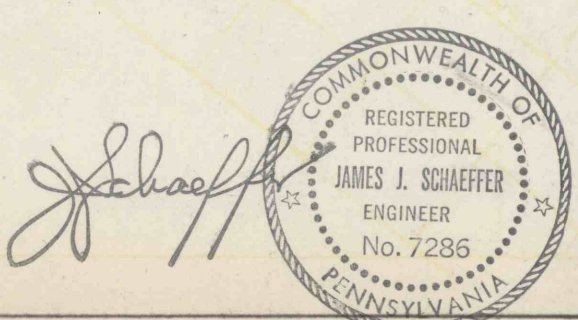

JANE MINES - R.B.P. COAL CO.
PLUM CREEK TWP - ARMSTRONG CO.

W. T. ANK

J. B. SHOTWELL

W. T. ANK

J. B. SHOTWELL

POINT OWN

POINT OWN