


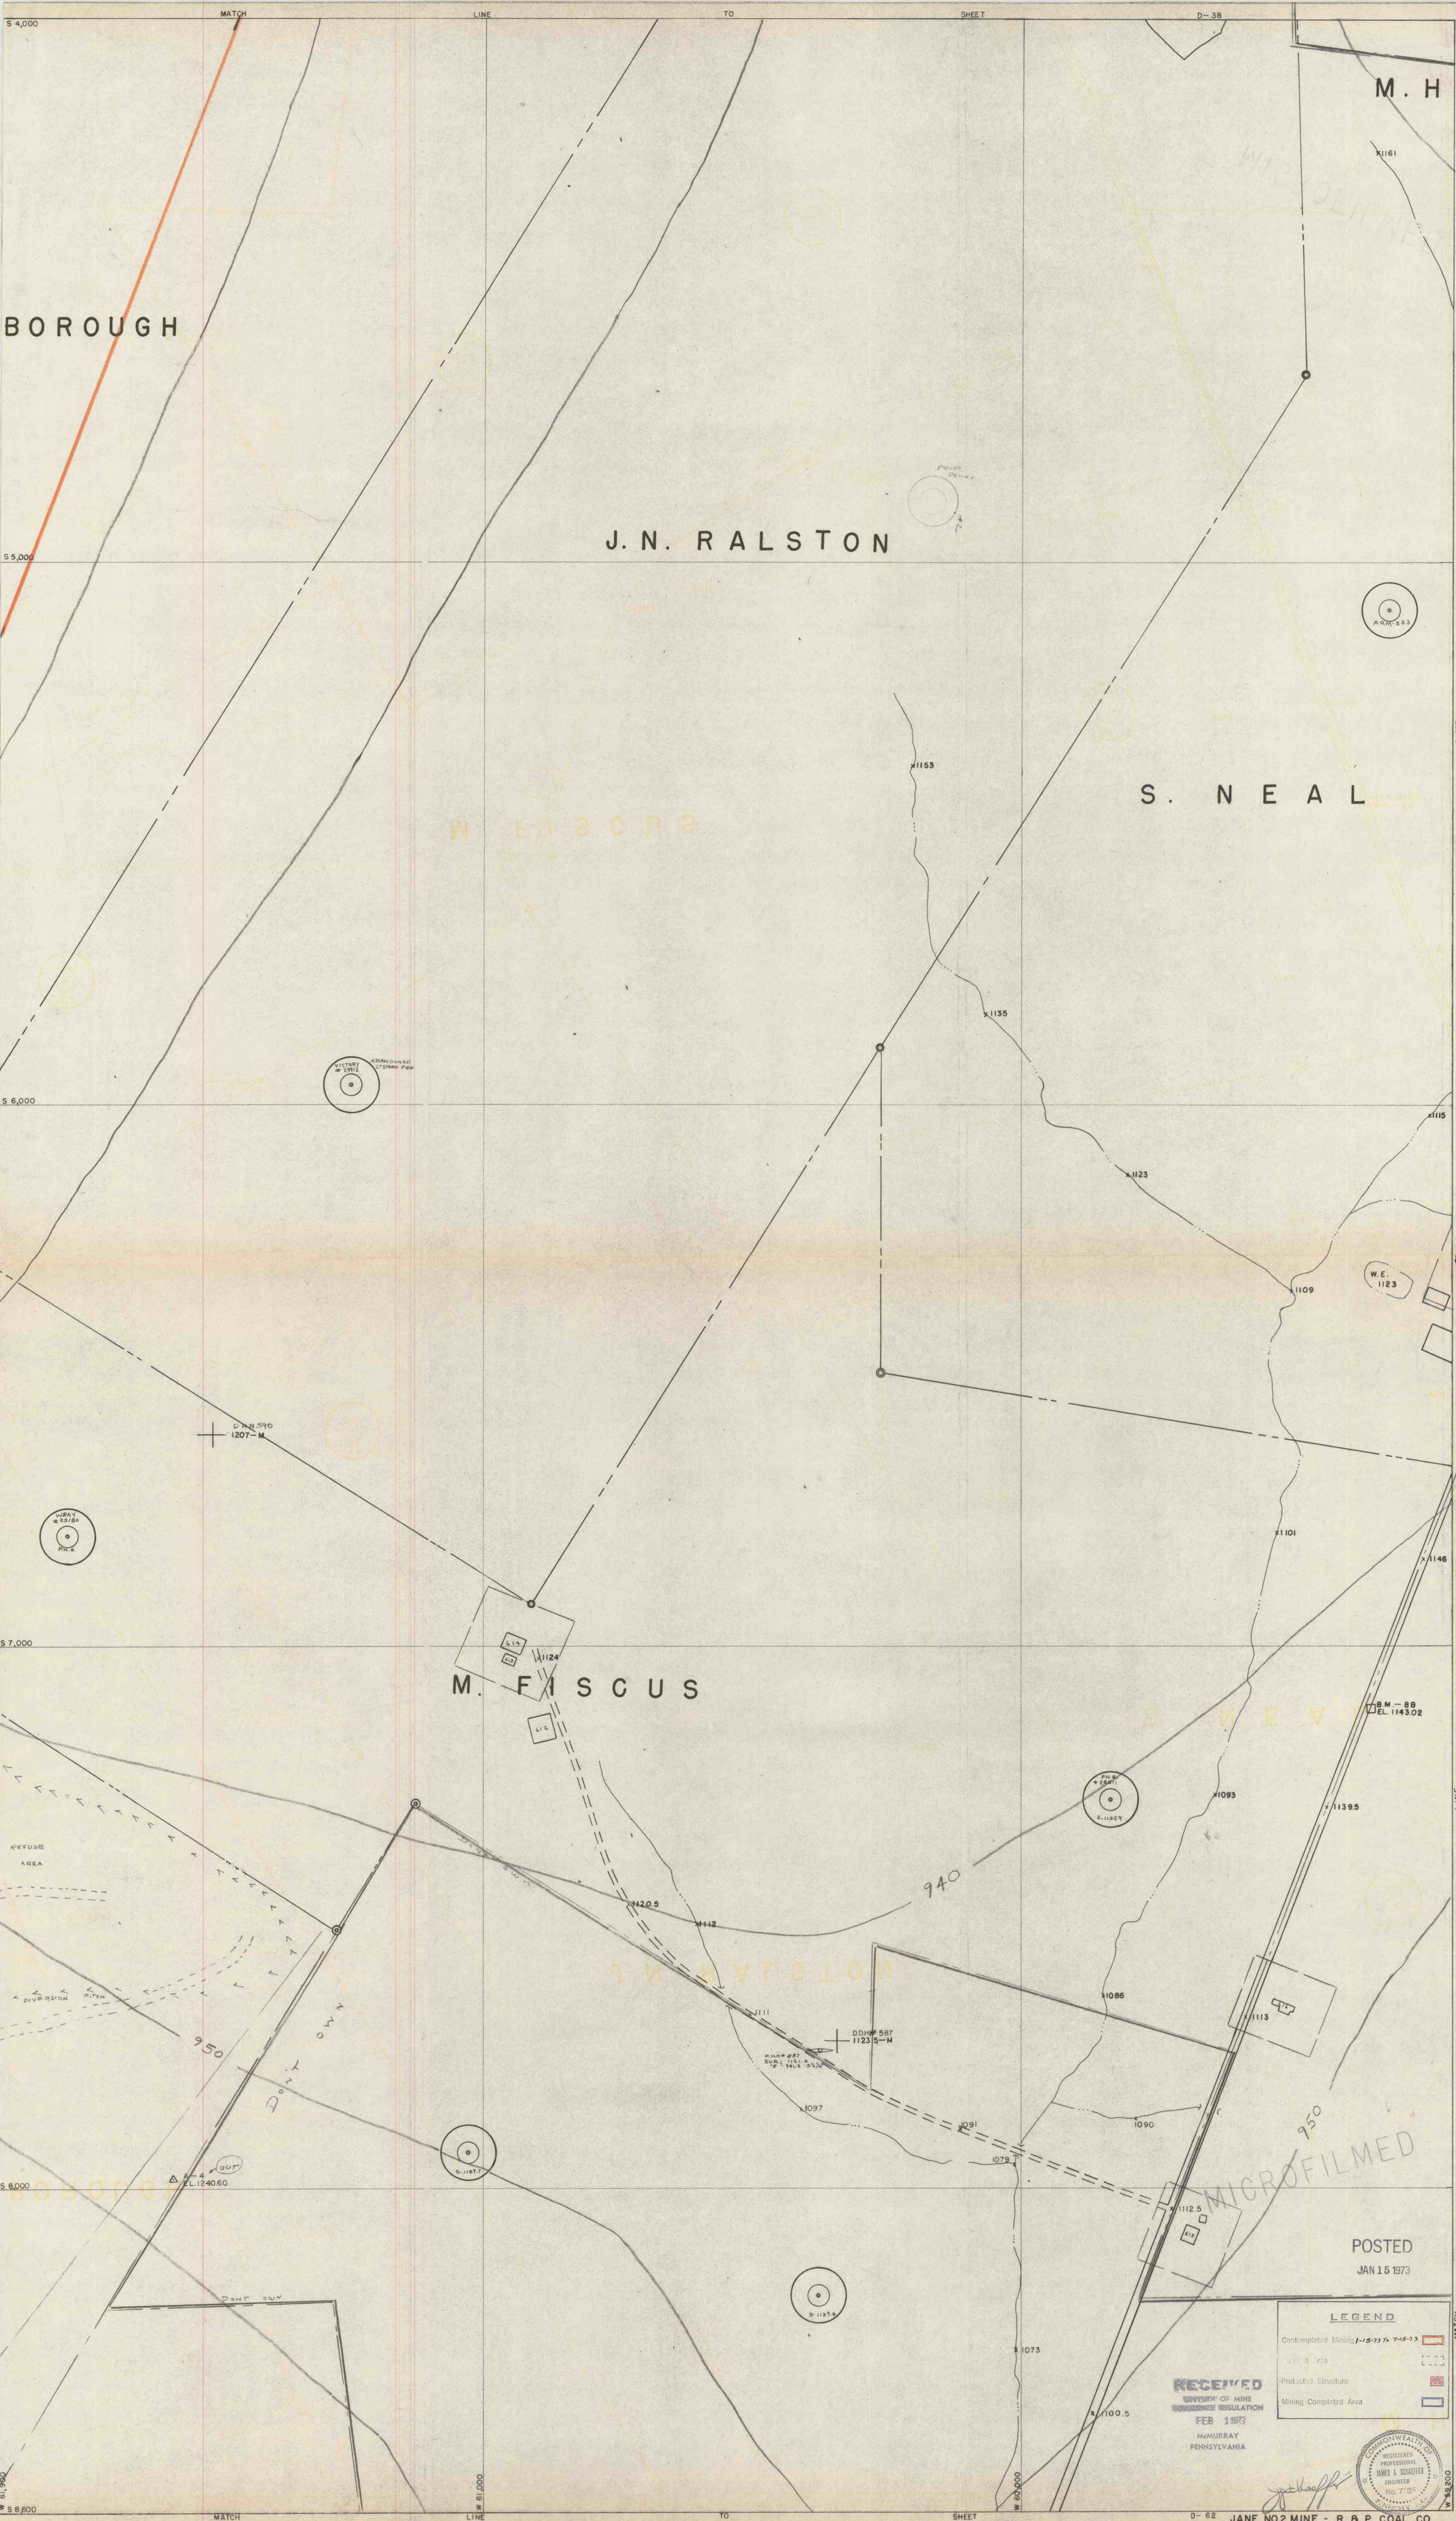

TRACING D46

DRAWER

D-46

POSTED
JAN 15 1973

LEGEND	
Contemplated Mining 1-15-73 to 7-15-73	
Refuse Area	
Protected Structure	
Mining Completed Area	

RECEIVED
UNIVERSITY OF MINE
SAFETY REGULATION
FEB 1 1973
McMURRAY
PENNSYLVANIA

COMMONWEALTH OF
PENNSYLVANIA
REGISTERED
PROFESSIONAL
ENGINEER
JAMES L. QUINN
No. 7785

JANE NO2 MINE - R. & P. COAL CO.
PLUM CREEK TWP - ARMSTRONG CO.