


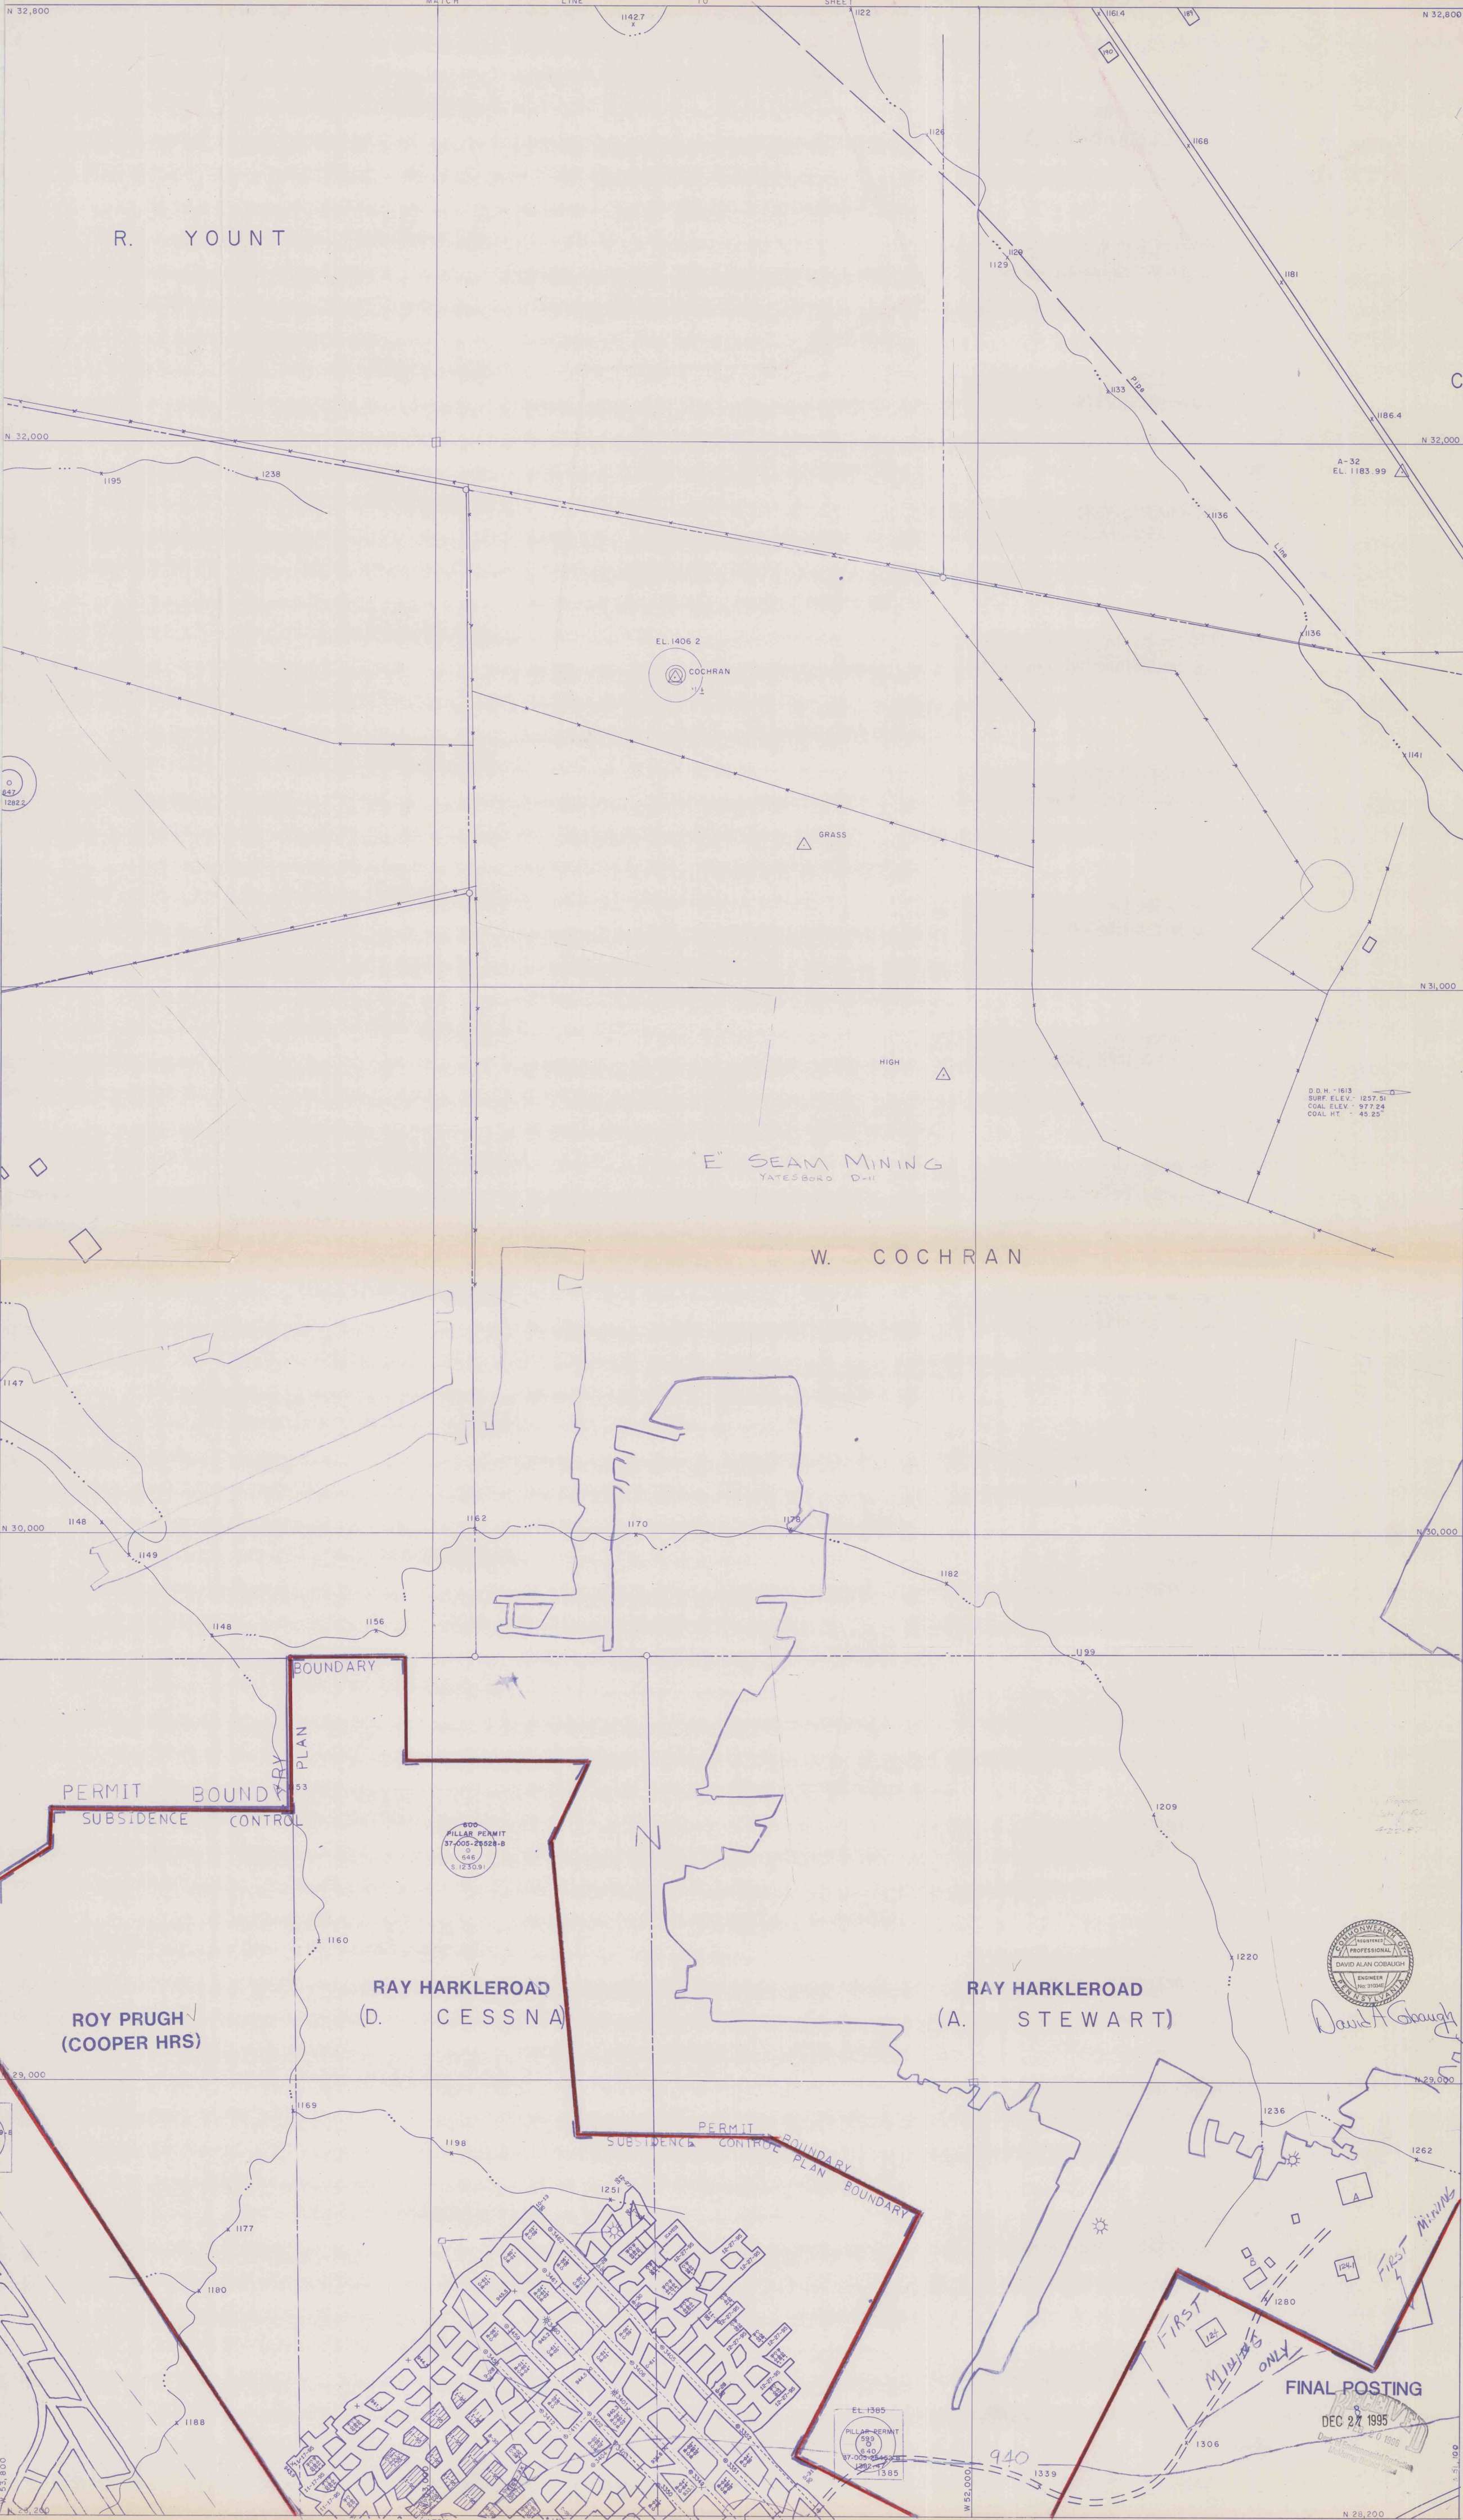

D-114

DRAWER 74

LOWER FREEPORT SEAM



FINAL POSTING
DEC 27 1995

