



KEYSTONE COAL
MINING CORP.

R & P COAL CO.

JANE 9A 5

JANE 9A 6

GLENN L. COCHRAN

JANE MINE (MSHA) No. 36C0823
JANE MINE PERMIT (DER) No. 03831305

JOHN L. SHAW

H. HARKLEROAD

ROBERT S. REARDON

(JOHN BELL)

JOHN L. SHAW

LEWIS GEORGE


WILLIAM G. WATT POSTED

JUL 24 1995

ROBERT YOCKEY

COWANSHANNOCK TWP.
PLUMCREEK TWP.

Contemplated Mining
From T-31-95 To APPROXIMATE SECTION
EST. SURF. ELEV. - 1110
EST. COAL ELEV. - 904.42
COAL HT. - 35.5'

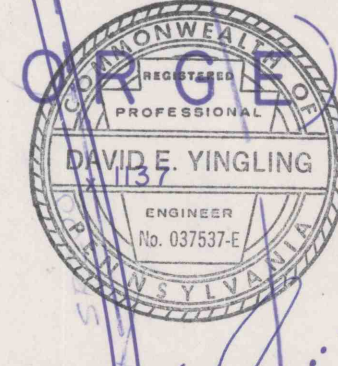

AUG 24 1995
Dept. of Environmental Protection
Mining Permit Office

LOWER FREEPORT SEAM

D-126