




JANE NO. 5 SHAFT DATA
2 COMPARTMENT INTAKE & RETURN FAN
JEFFREY 8H96 DIRECT DRIVE
FAN SPEED 715 R.P.M.
BLADE POSITION NO. 4
MOTOR 300 H.P.
MOTOR LOAD 377 AMPS.
MOTOR VOLTAGE 460-CYCLE 60
COPING ELEV. 1223.4
BOTTOM OF COAL "E" SEAM 1026.48
BOTTOM OF COAL "D" SEAM 963.68
DEPTH 259.72

VOLUMES
INTAKE _____
RETURN _____
CH4% _____
WATER GAGE _____

RECEIVED
FEB 21 1989
Dept. of Environmental Resources
McMurray District Office

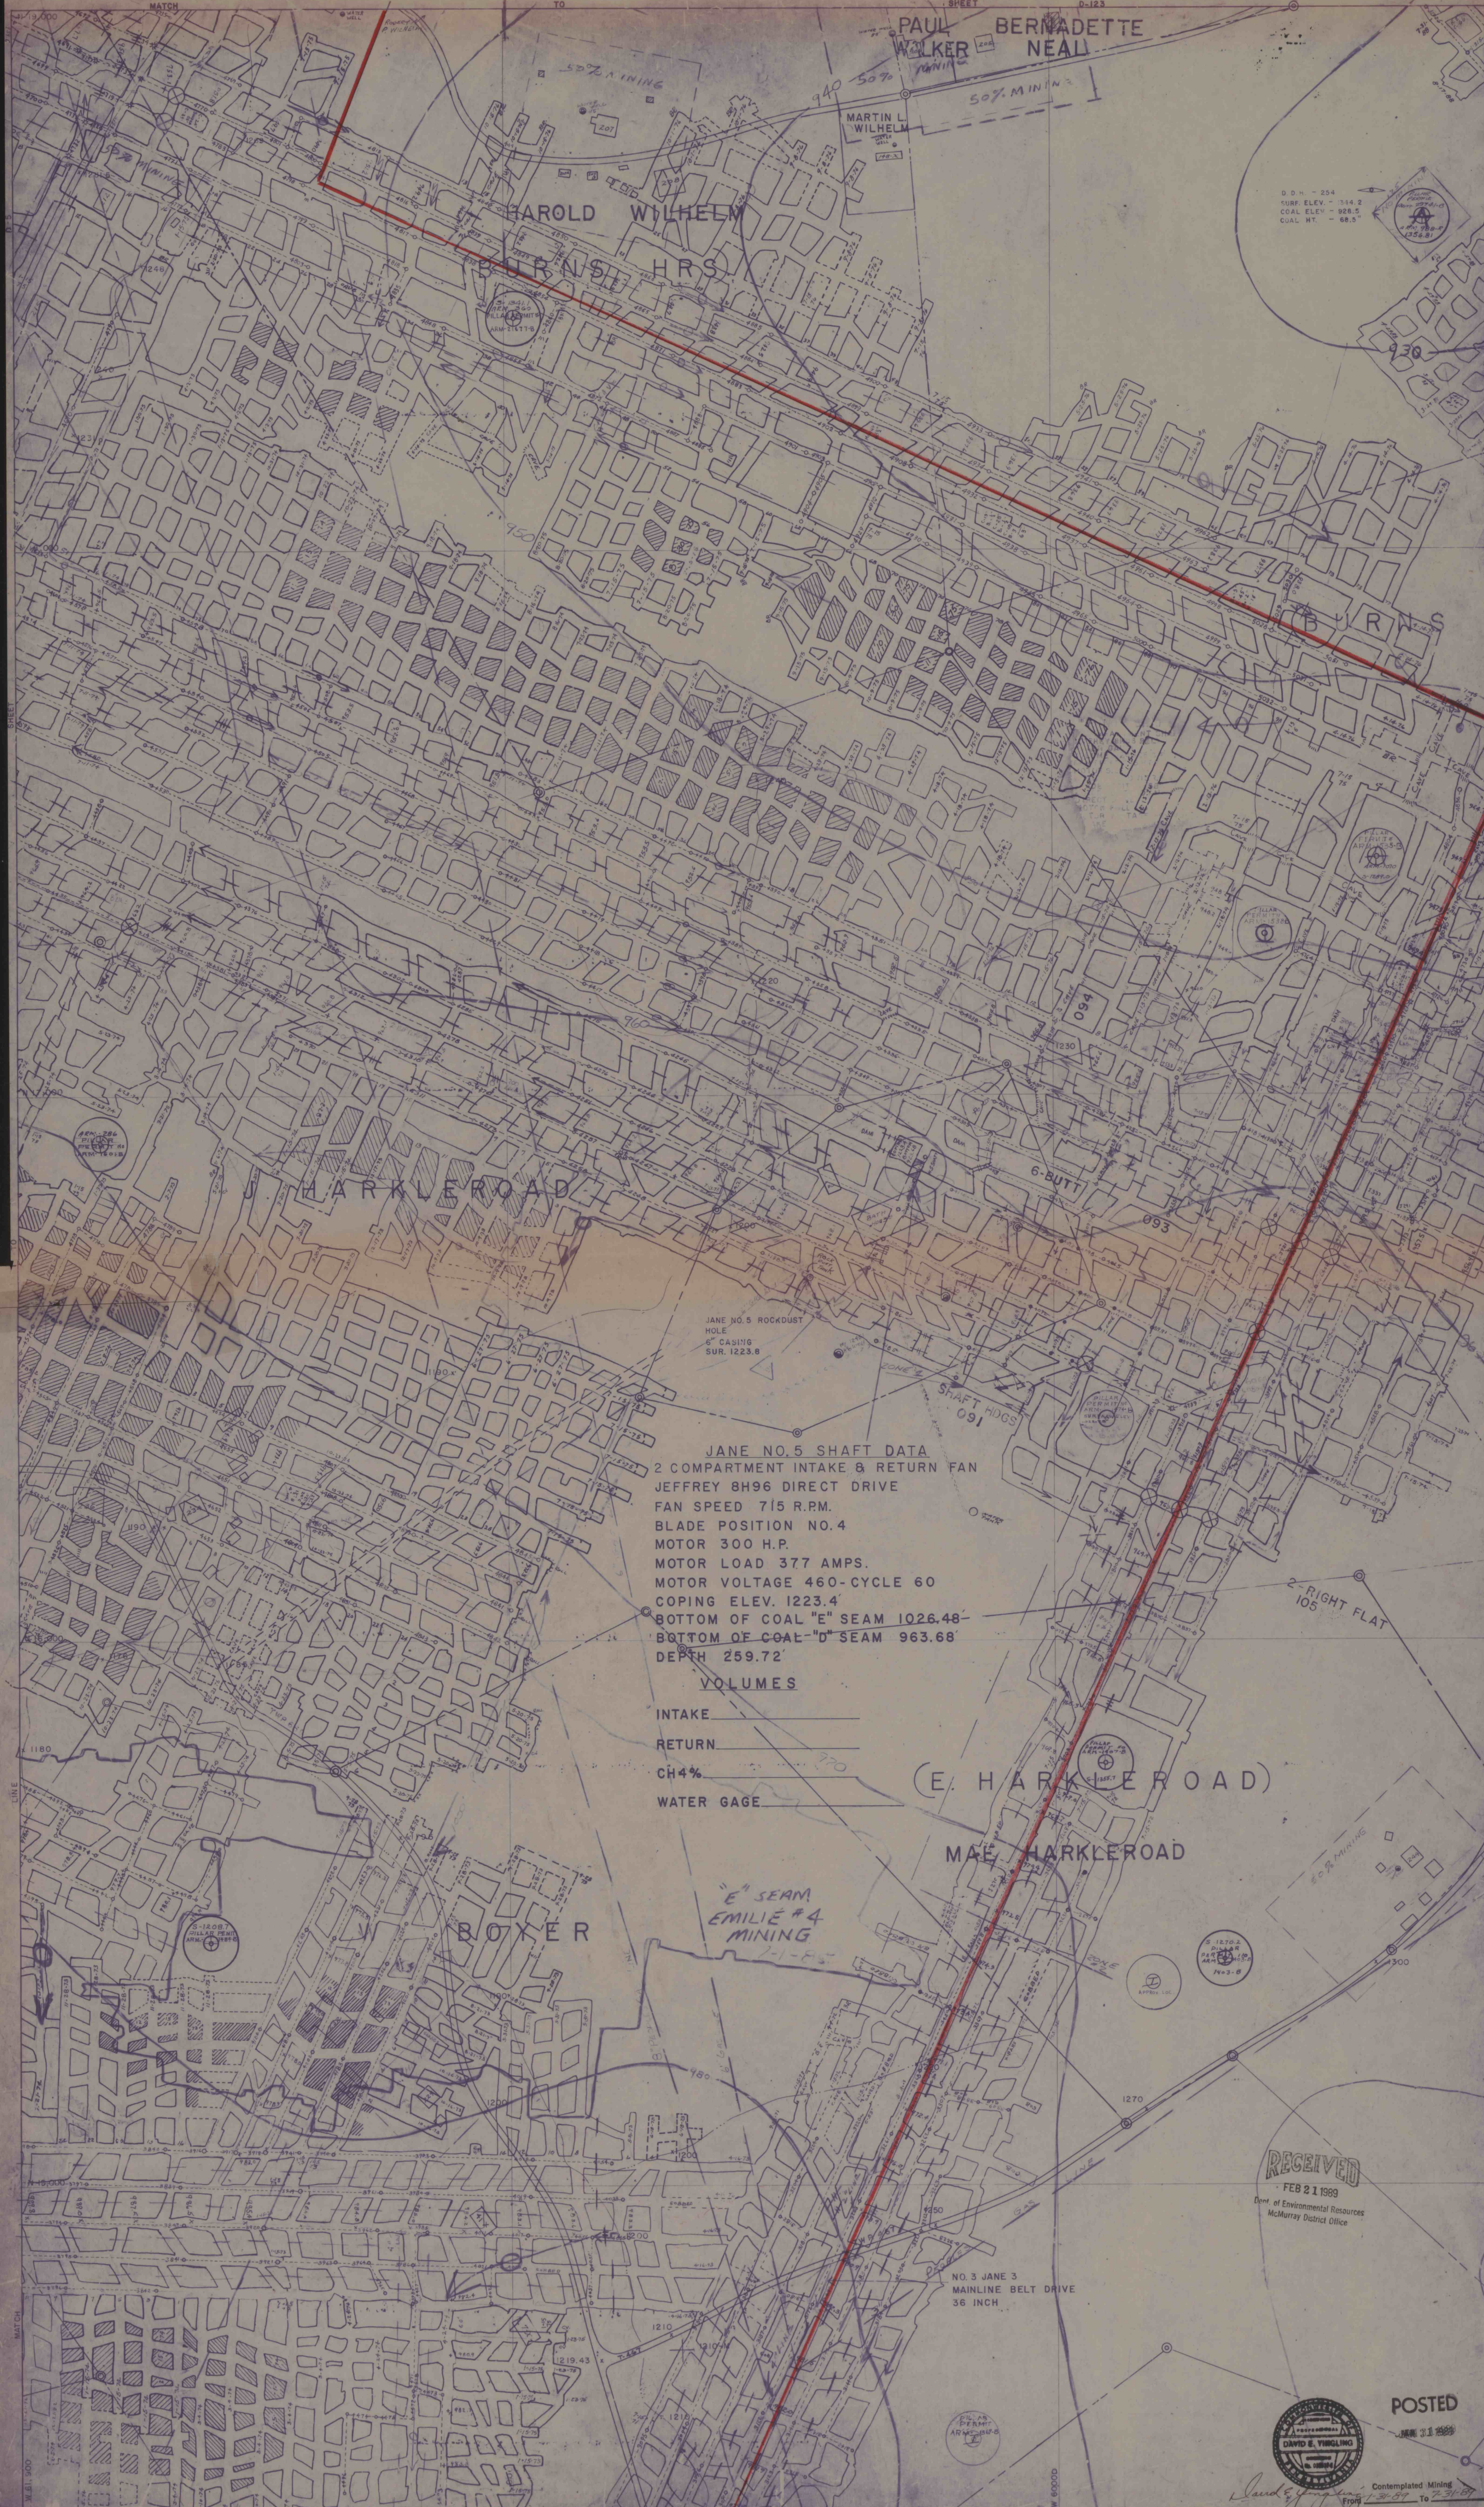

POSTED
JAN 31 1989