


MATCH TO SHEET 4


MATCH TO SHEET 21

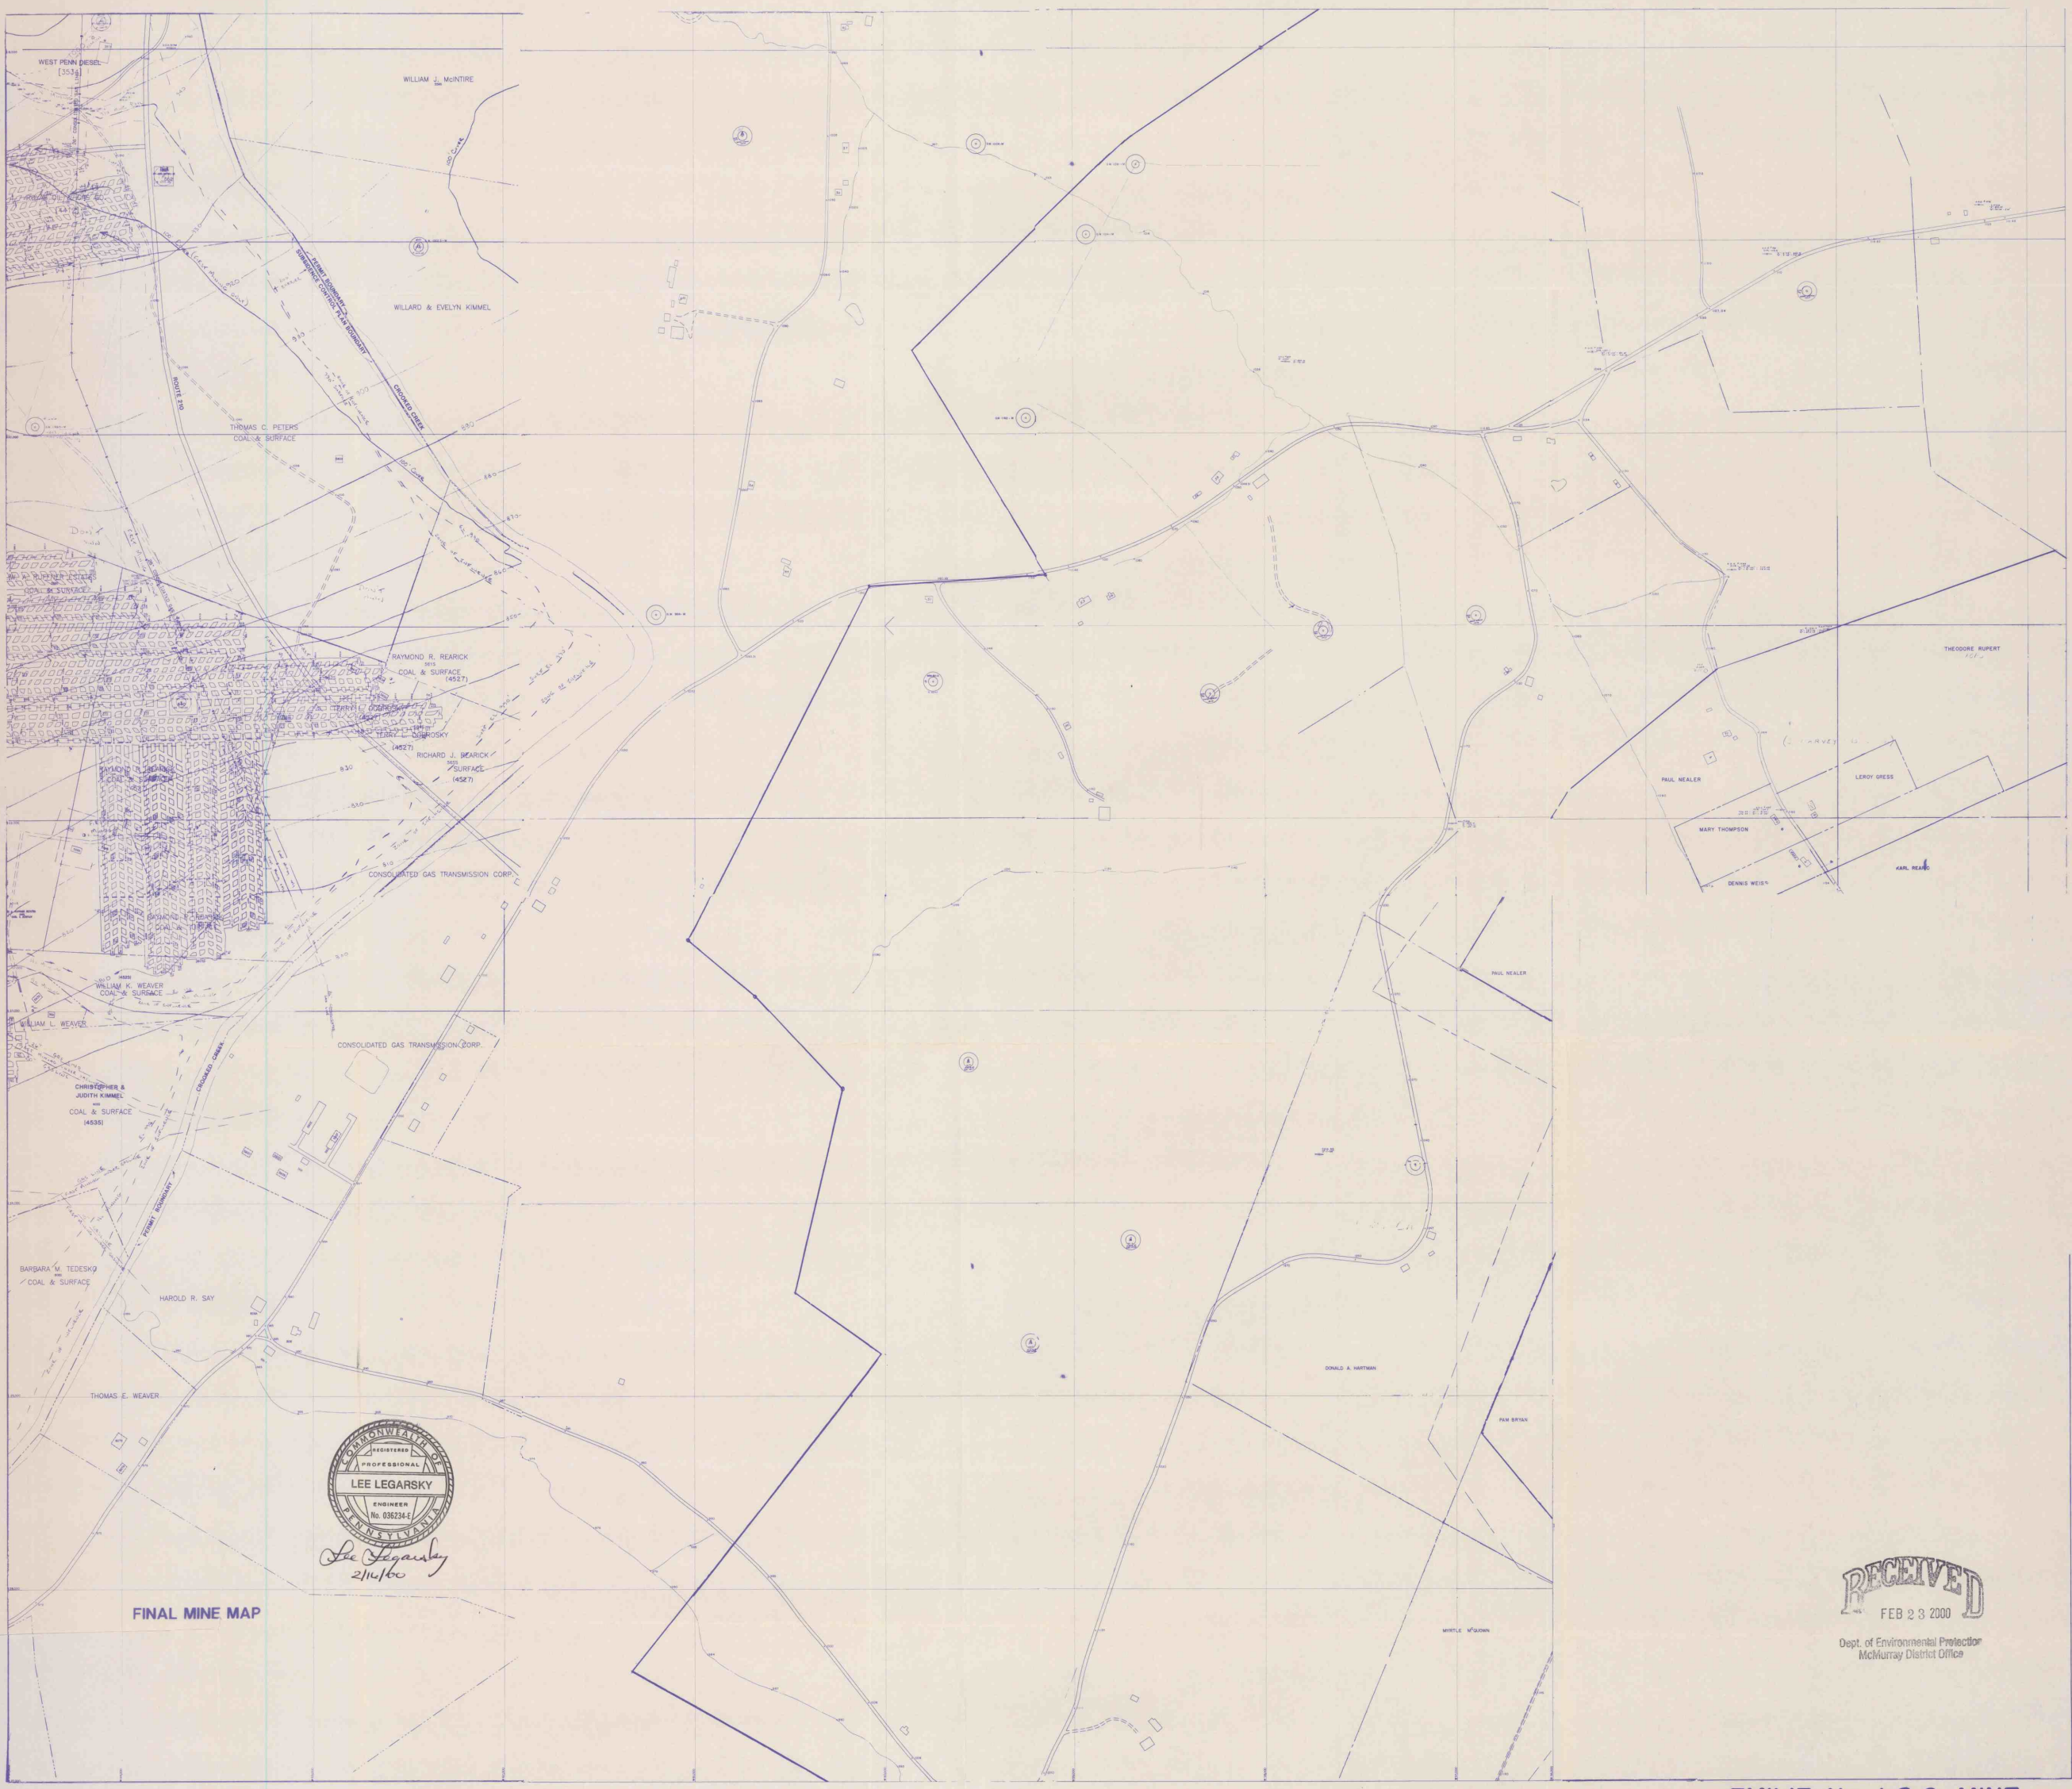

PROFESSIONAL
REGISTERED
ENGINEER
LEE LEGARSKY
No. 036234-E
Pennsylvania
Lee Legarsky
2/14/00

FINAL MINE MAP

RECEIVED
FEB 23 2000
Dept. of Environmental Protection
McMurray District Office

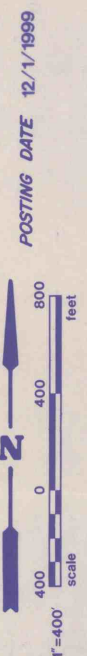

PLUMCREEK & SOUTH BEND TWPS.
ARMSTRONG COUNTY

EMILIE No. 1 & 2 MINE
(UPPER FREEPORT COAL SEAM)
Emilie-1-2-07-B Southeast Portion