


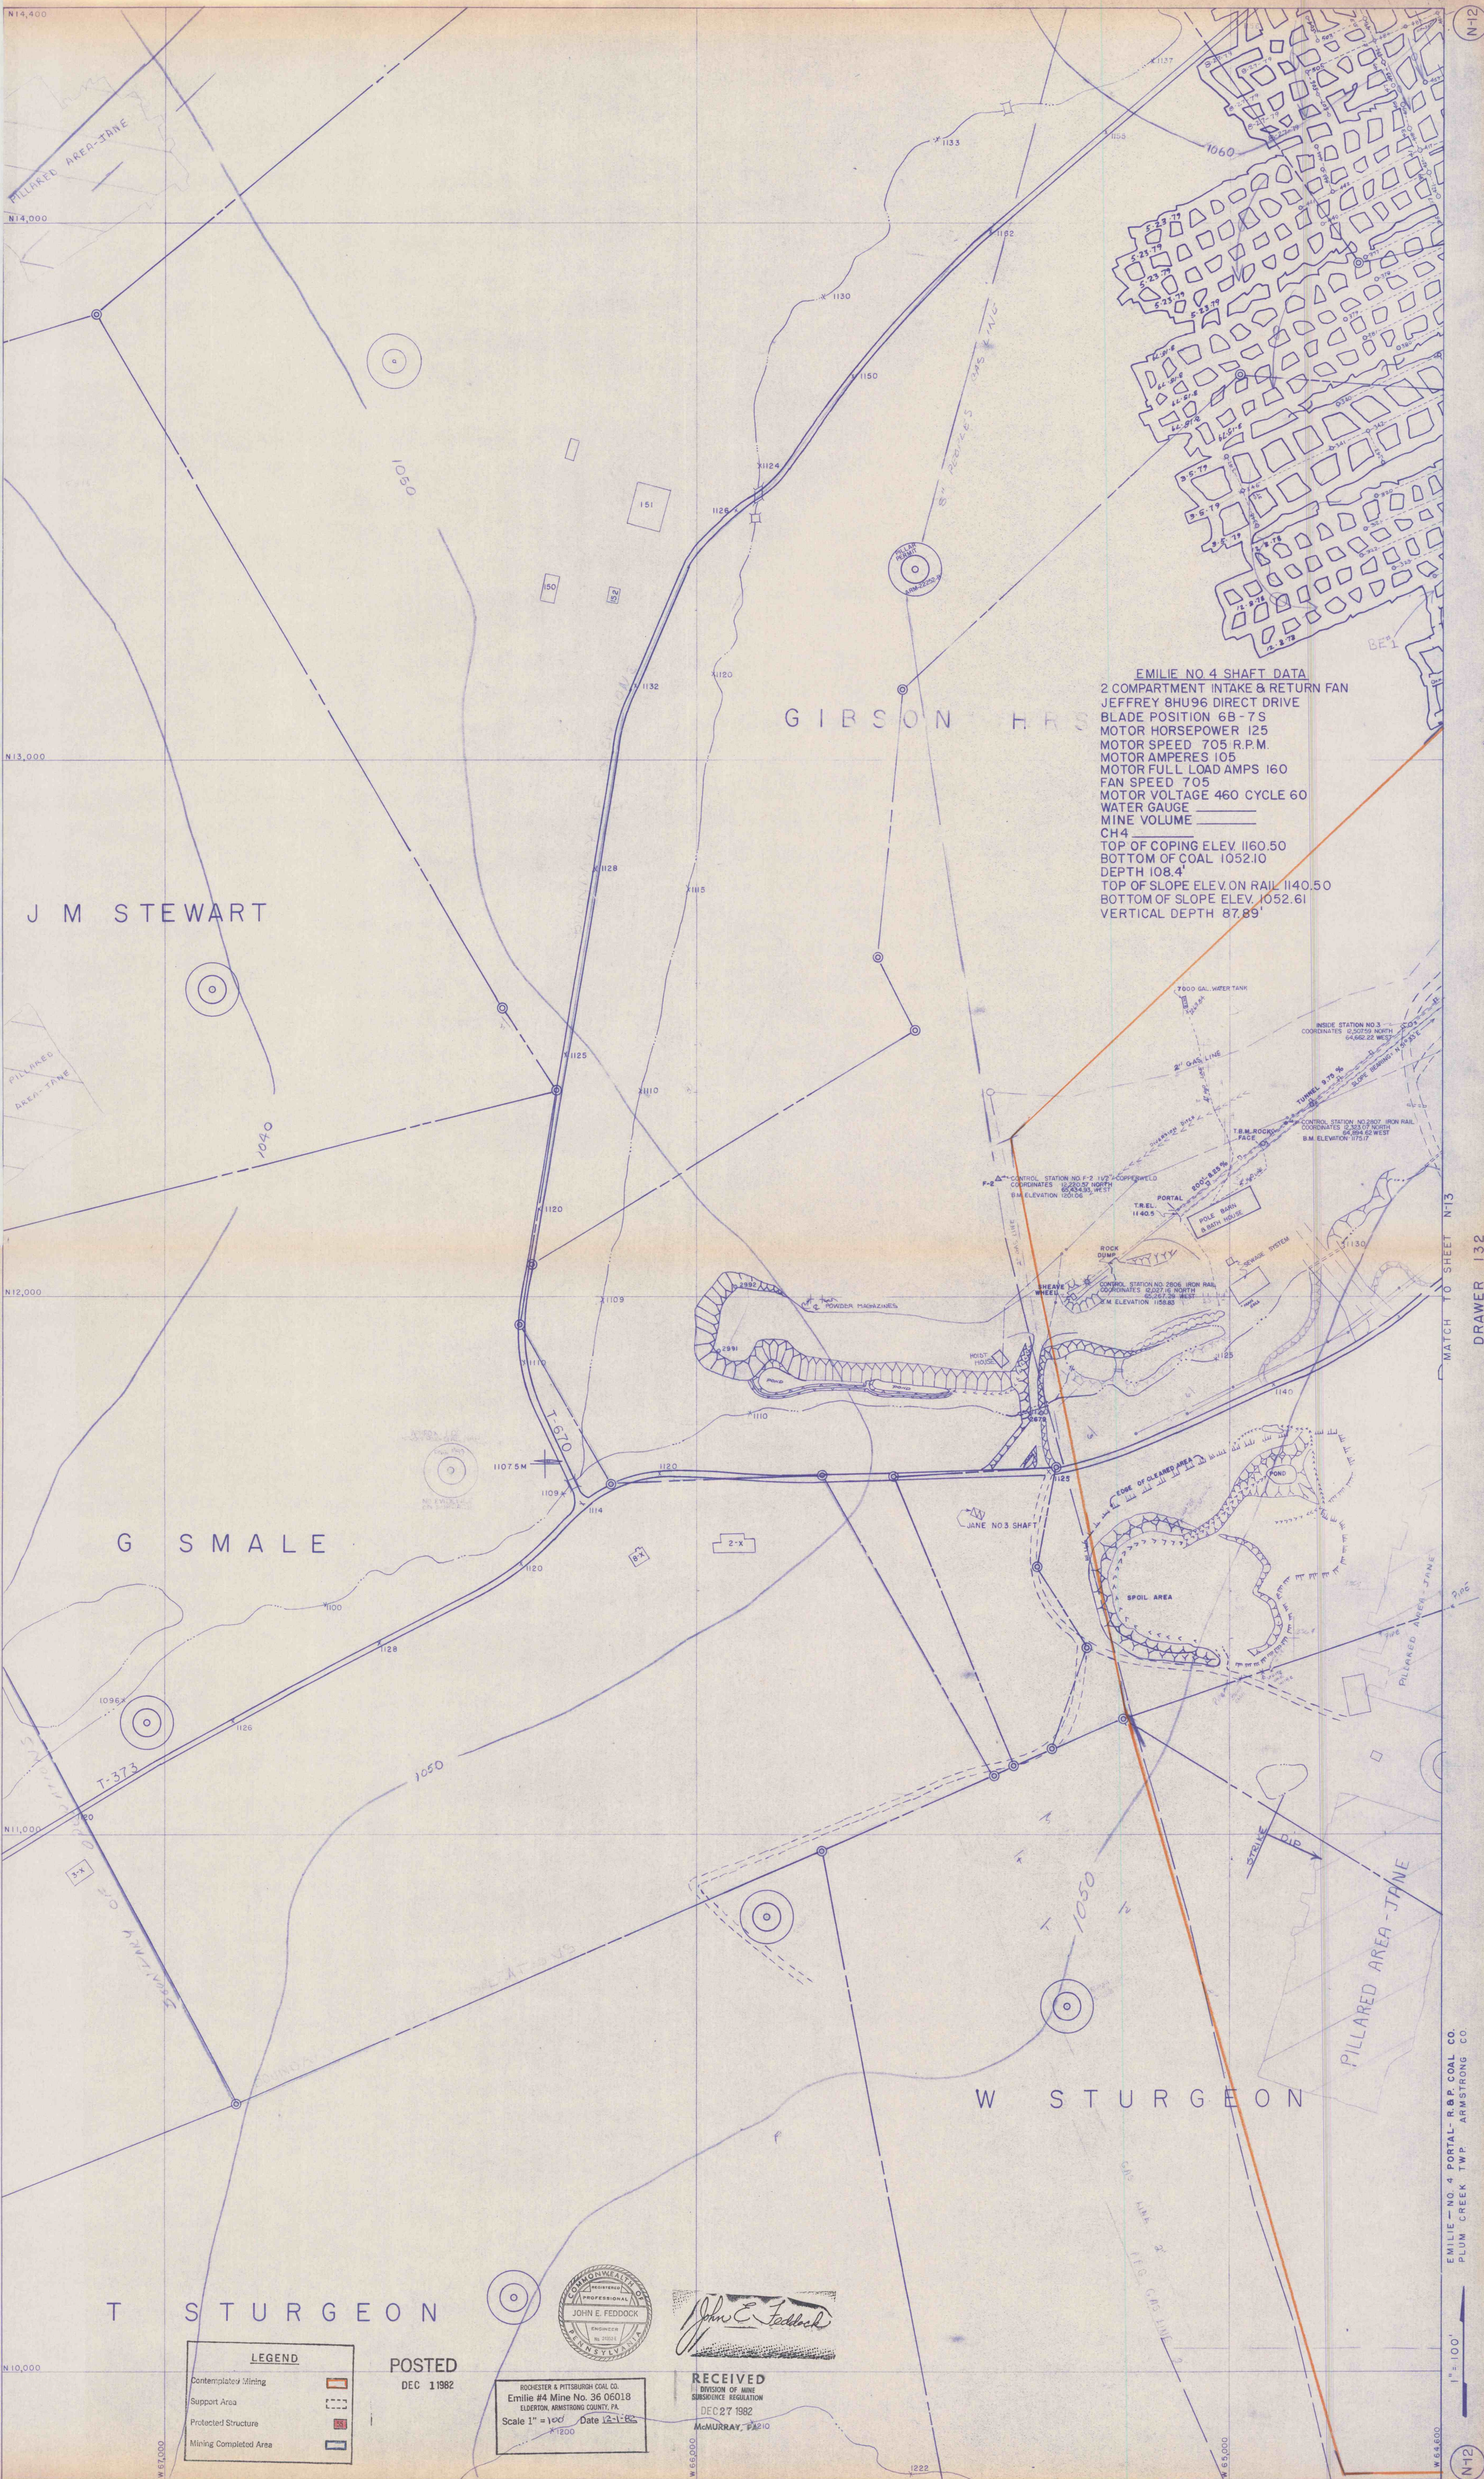

EMILIE NO. 4 SHAFT DATA
2 COMPARTMENT INTAKE & RETURN FAN
JEFFREY 8HU96 DIRECT DRIVE
BLADE POSITION 6B-7S
MOTOR HORSEPOWER 125
MOTOR SPEED 705 R.P.M.
MOTOR AMPERES 105
MOTOR FULL LOAD AMPS 160
FAN SPEED 705
MOTOR VOLTAGE 460 CYCLE 60
WATER GAUGE
MINE VOLUME
CH-4
TOP OF COPING ELEV. 1160.50
BOTTOM OF COAL 1052.10
DEPTH 108.4'
TOP OF SLOPE ELEV. ON RAIL 1140.50
BOTTOM OF SLOPE ELEV. 1052.61
VERTICAL DEPTH 87.89'

LEGEND	
Contemplated Mining	
Support Area	
Protected Structure	
Mining Completed Area	

POSTED
DEC 1982

ROCHESTER & PITTSBURGH COAL CO.
Emilie #4 Mine No. 36 06018
ELDERTON, ARMSTRONG COUNTY, PA.
Scale 1" = 100' Date 12-1-82
McMURRAY, PA 210

John E. Feddock
JOHN E. FEDDOCK
REGISTERED PROFESSIONAL ENGINEER
No. 20224
PENNSYLVANIA

RECEIVED
DIVISION OF MINE
SUPERVISOR REGULATION
DEC 27 1982
McMURRAY, PA 210

EMILIE - NO. 4 PORTAL - R.S.P. COAL CO.
PLUM CREEK TWP. ARMSTRONG CO.

1" = 100'

EMILIE-1-2-012