


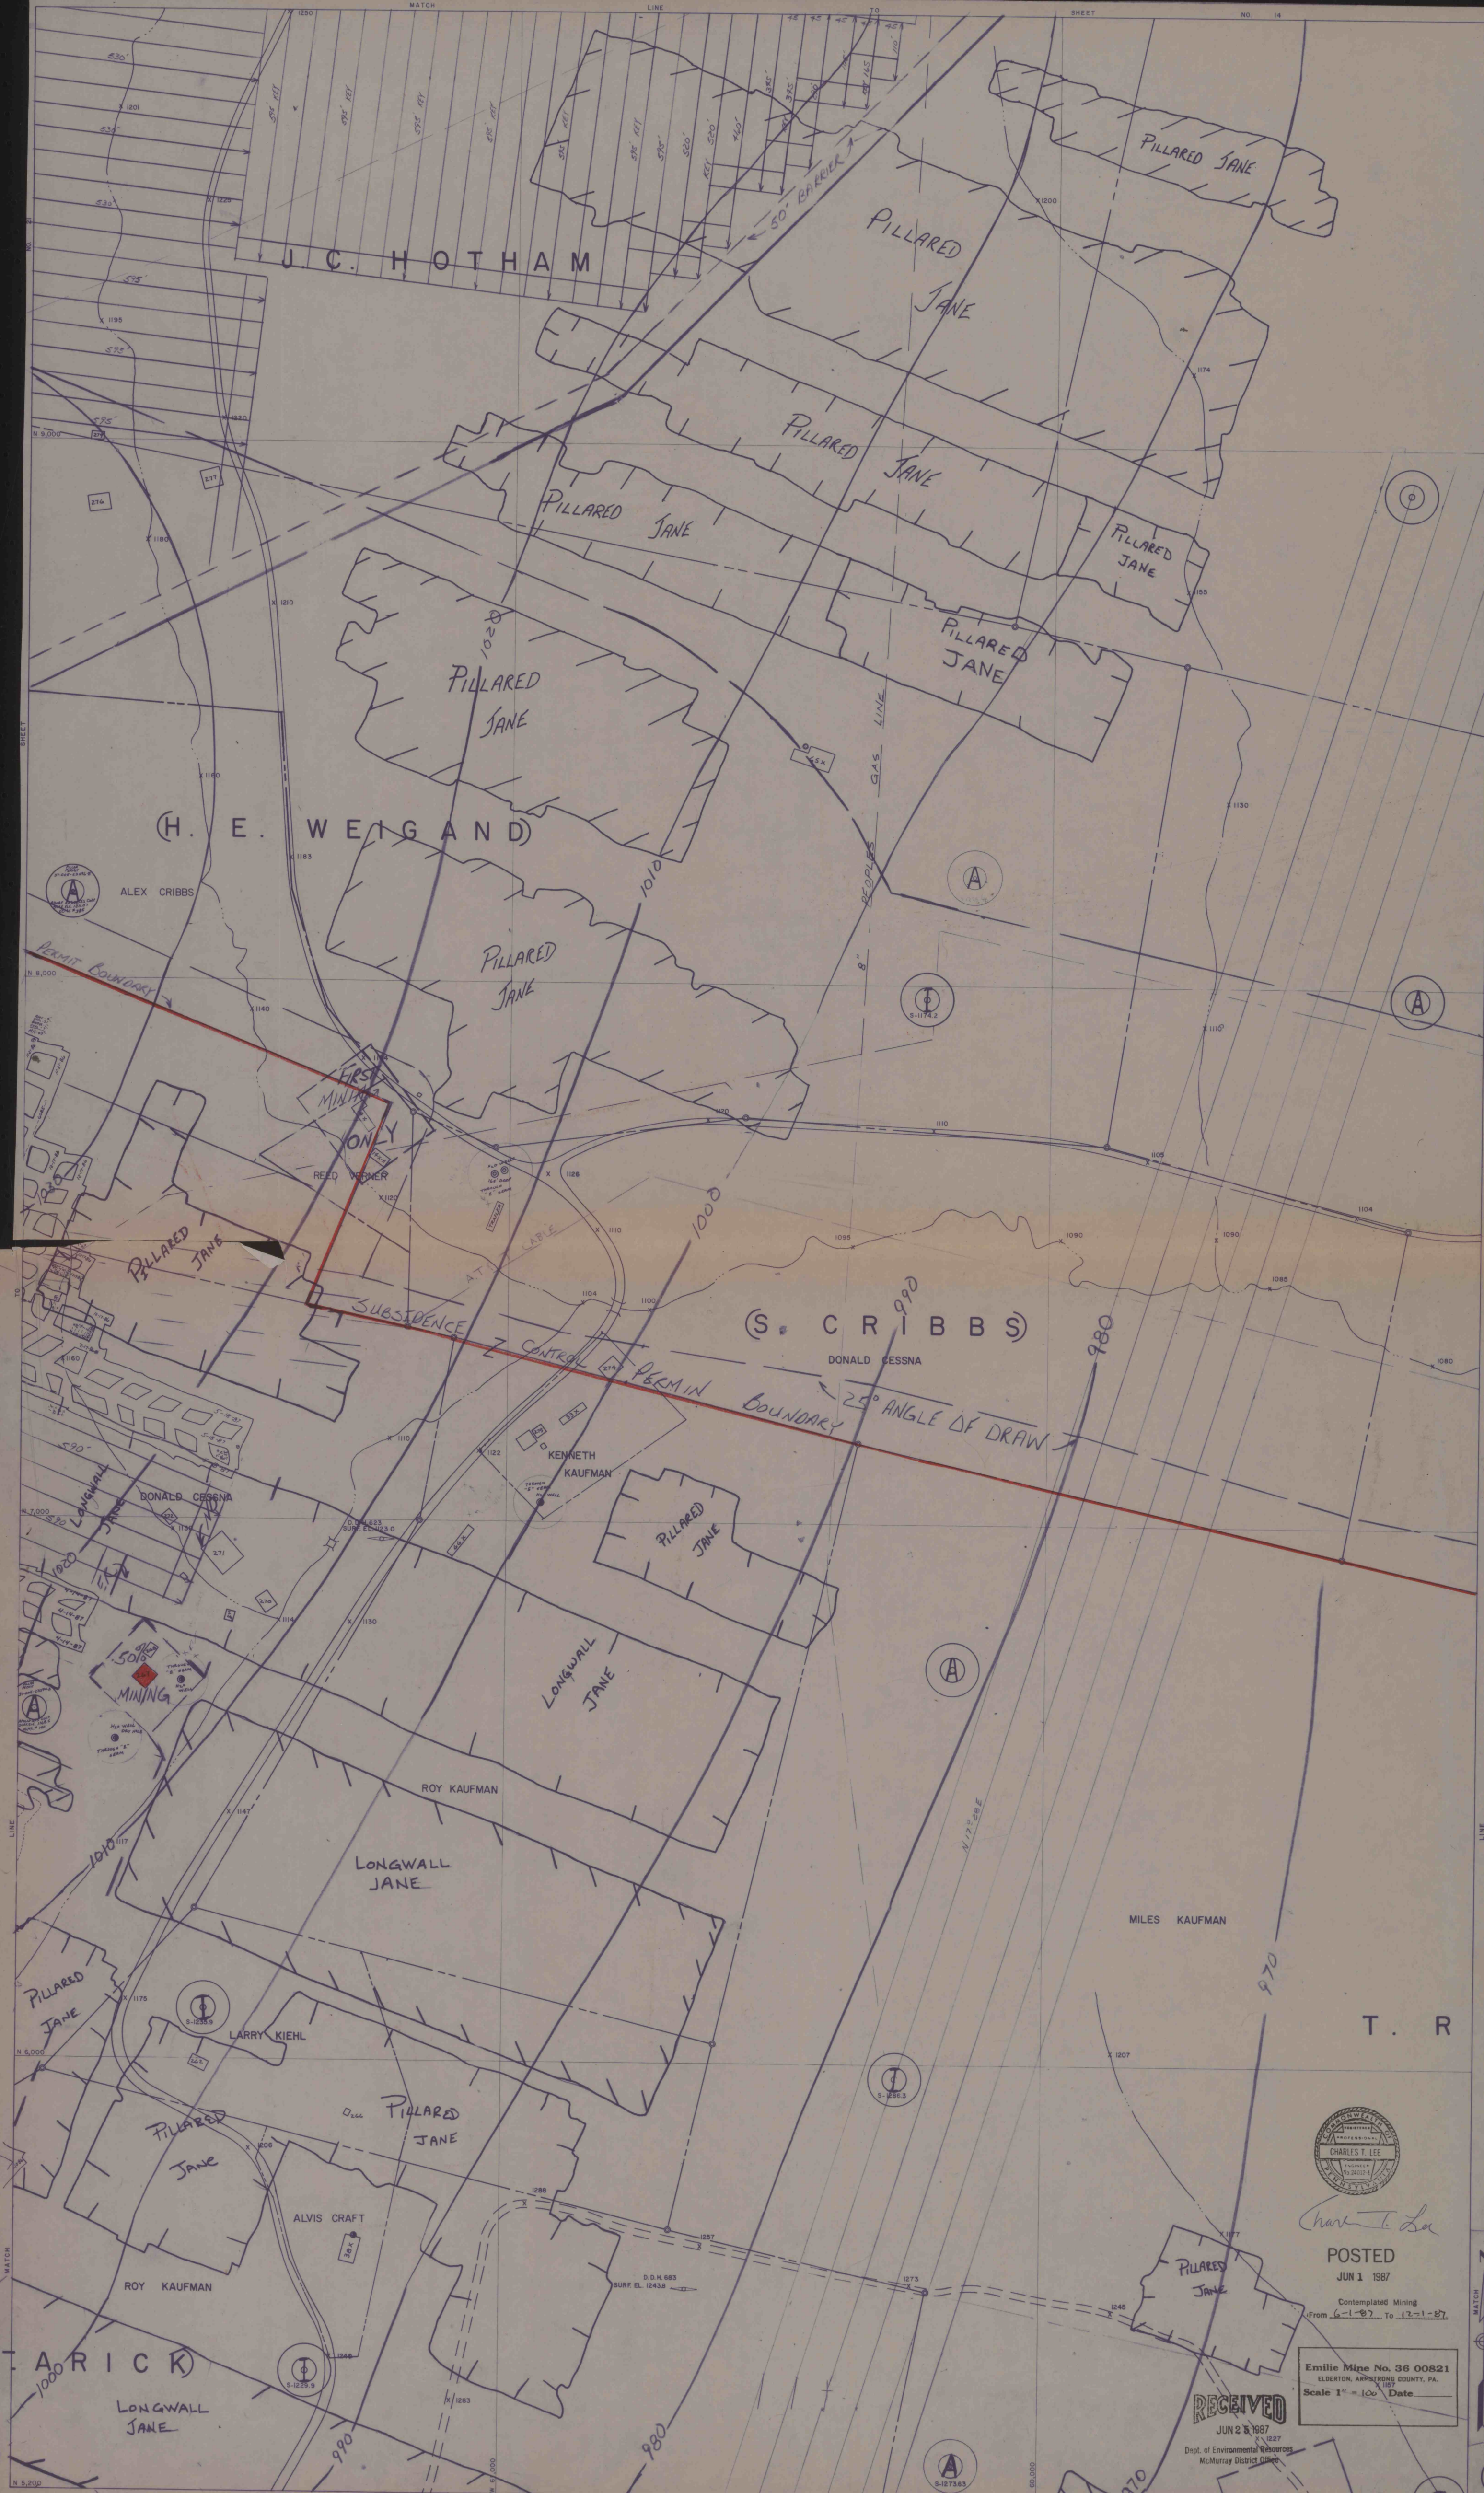

POSTED
JUN 1 1987
Contemplated Mining
From 6-1-87 To 12-1-87

Emilie Mine No. 36 00821
ELBERTON, ARMSTRONG COUNTY, PA.
Scale 1" = 100' Date

RECEIVED
JUN 2 1987
Dept. of Environmental Resources
McMurry District Office