




COMMONWEALTH OF PENNSYLVANIA
DEPARTMENT OF ENVIRONMENTAL PROTECTION
Oil and Gas Management Program
WELL LOCATION PLAT

DEP USE ONLY	DEP Application Tracking #	G
	Form #	C
	Project #	

☐	Denotes location of well on topo map.
True Latitude: NORTH 40° 41' 47.73"	
True Longitude: WEST 79° 22' 12.50"	

Well is located on topo map 4,264 feet south of latitude 40° 42' 30"

L k - present
UF-?

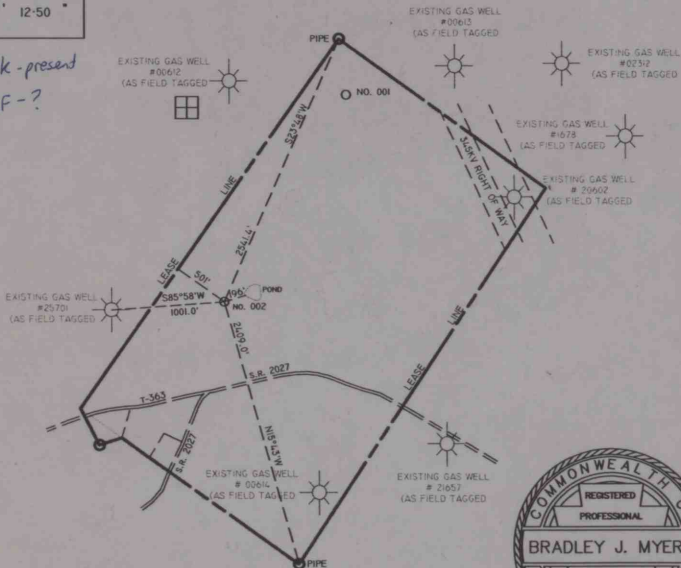

Surveyor or Engineer: **BRADLEY J. MYERS** Phone: **814-764-5050** Draw: **YOUNT-STUDER.DWG** Date: **12/07/2004** Scale: **1"=1000'** Tract Acreage: **215**

Lat. & Long. Metadata Method: GPS/KN Accuracy: ±0.25 ft. Datum: NAD 1927		Elevation Metadata Method: GPS/KN Accuracy: ±0.25 ft. Datum: NAVD 88		Survey Date: 11/19/2004	
Applicant / Well Operator Name KRIEBEL MINERALS, INC.		Well(Farm) Name EYLER CANALE		Well # 002	Serial #
Address P.O. BOX 765 CLARION, PA 16214		County Code ARMSTRONG - 03		Municipality PLUMCREEK TOWNSHIP	
Surface Landowner MICHAEL C. STUDER, MICHAEL E. STUDER, & BRYAN E. STUDER ET. AL.		USGS 71/2 Quadrangle Map Name ELDERTON		Map Section "4"	
Surface Lessor		Angle & Course of Deviation (Drilling) VERTICAL		Surface Elevation 1243.5	Anticipated Total Depth 4,400
Surface Owner or Water Purveyor with a Water Supply within 1,000 ft.		Approximate Course and Distance to Water Supply S 20° W 970'		Name of Coal Seam Owned, Leased, or Operated ALL	
CLAIR KOUGH		ROCHESTER & PITTSBURGH COAL COMPANY			

Well is located on topo map 10,204 feet west of longitude

79° 20' 00"