


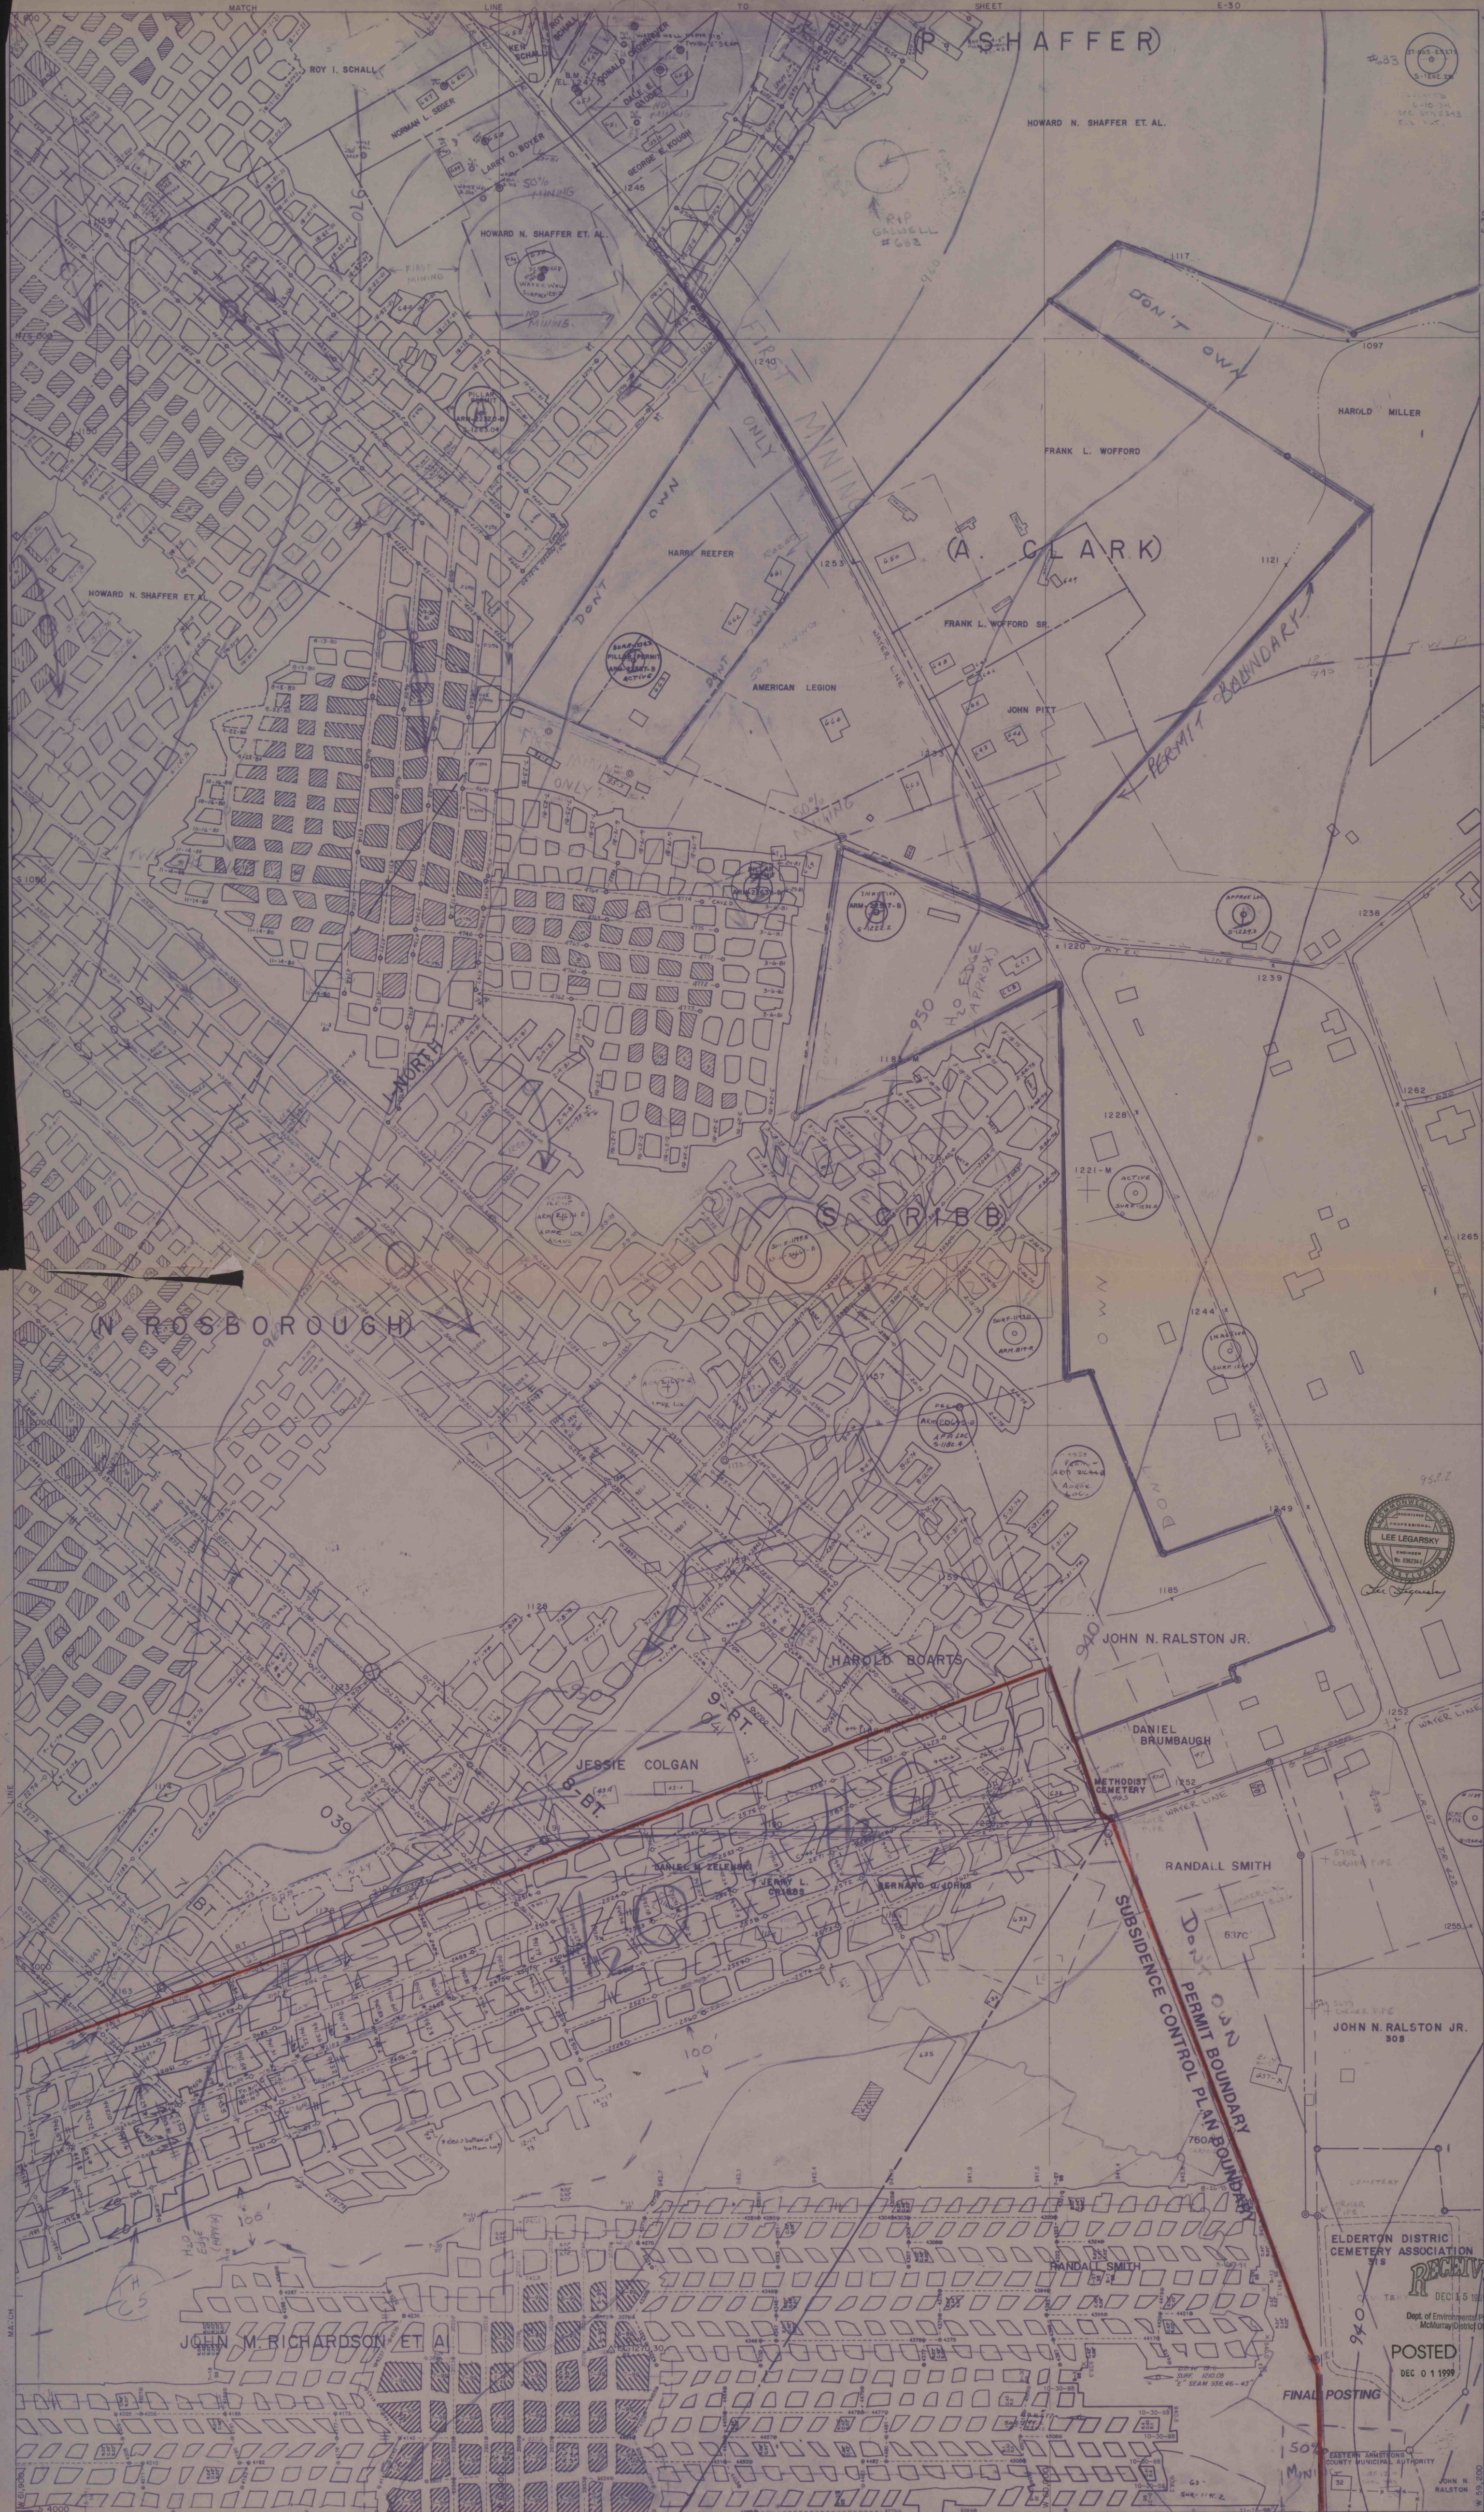

TRACING E-38
DRAWER
E-39
E-30
E-46
E-38

TRACING E-38

RECEIVED
DEC 15 1999
Dept. of Environmental Protection
McMurray District Office
POSTED
DEC 01 1999
FINAL POSTING
Elderton District Cemetery Association
COUNTY MUNICIPAL AUTHORITY
JOHN N. RALSTON JR.
308