


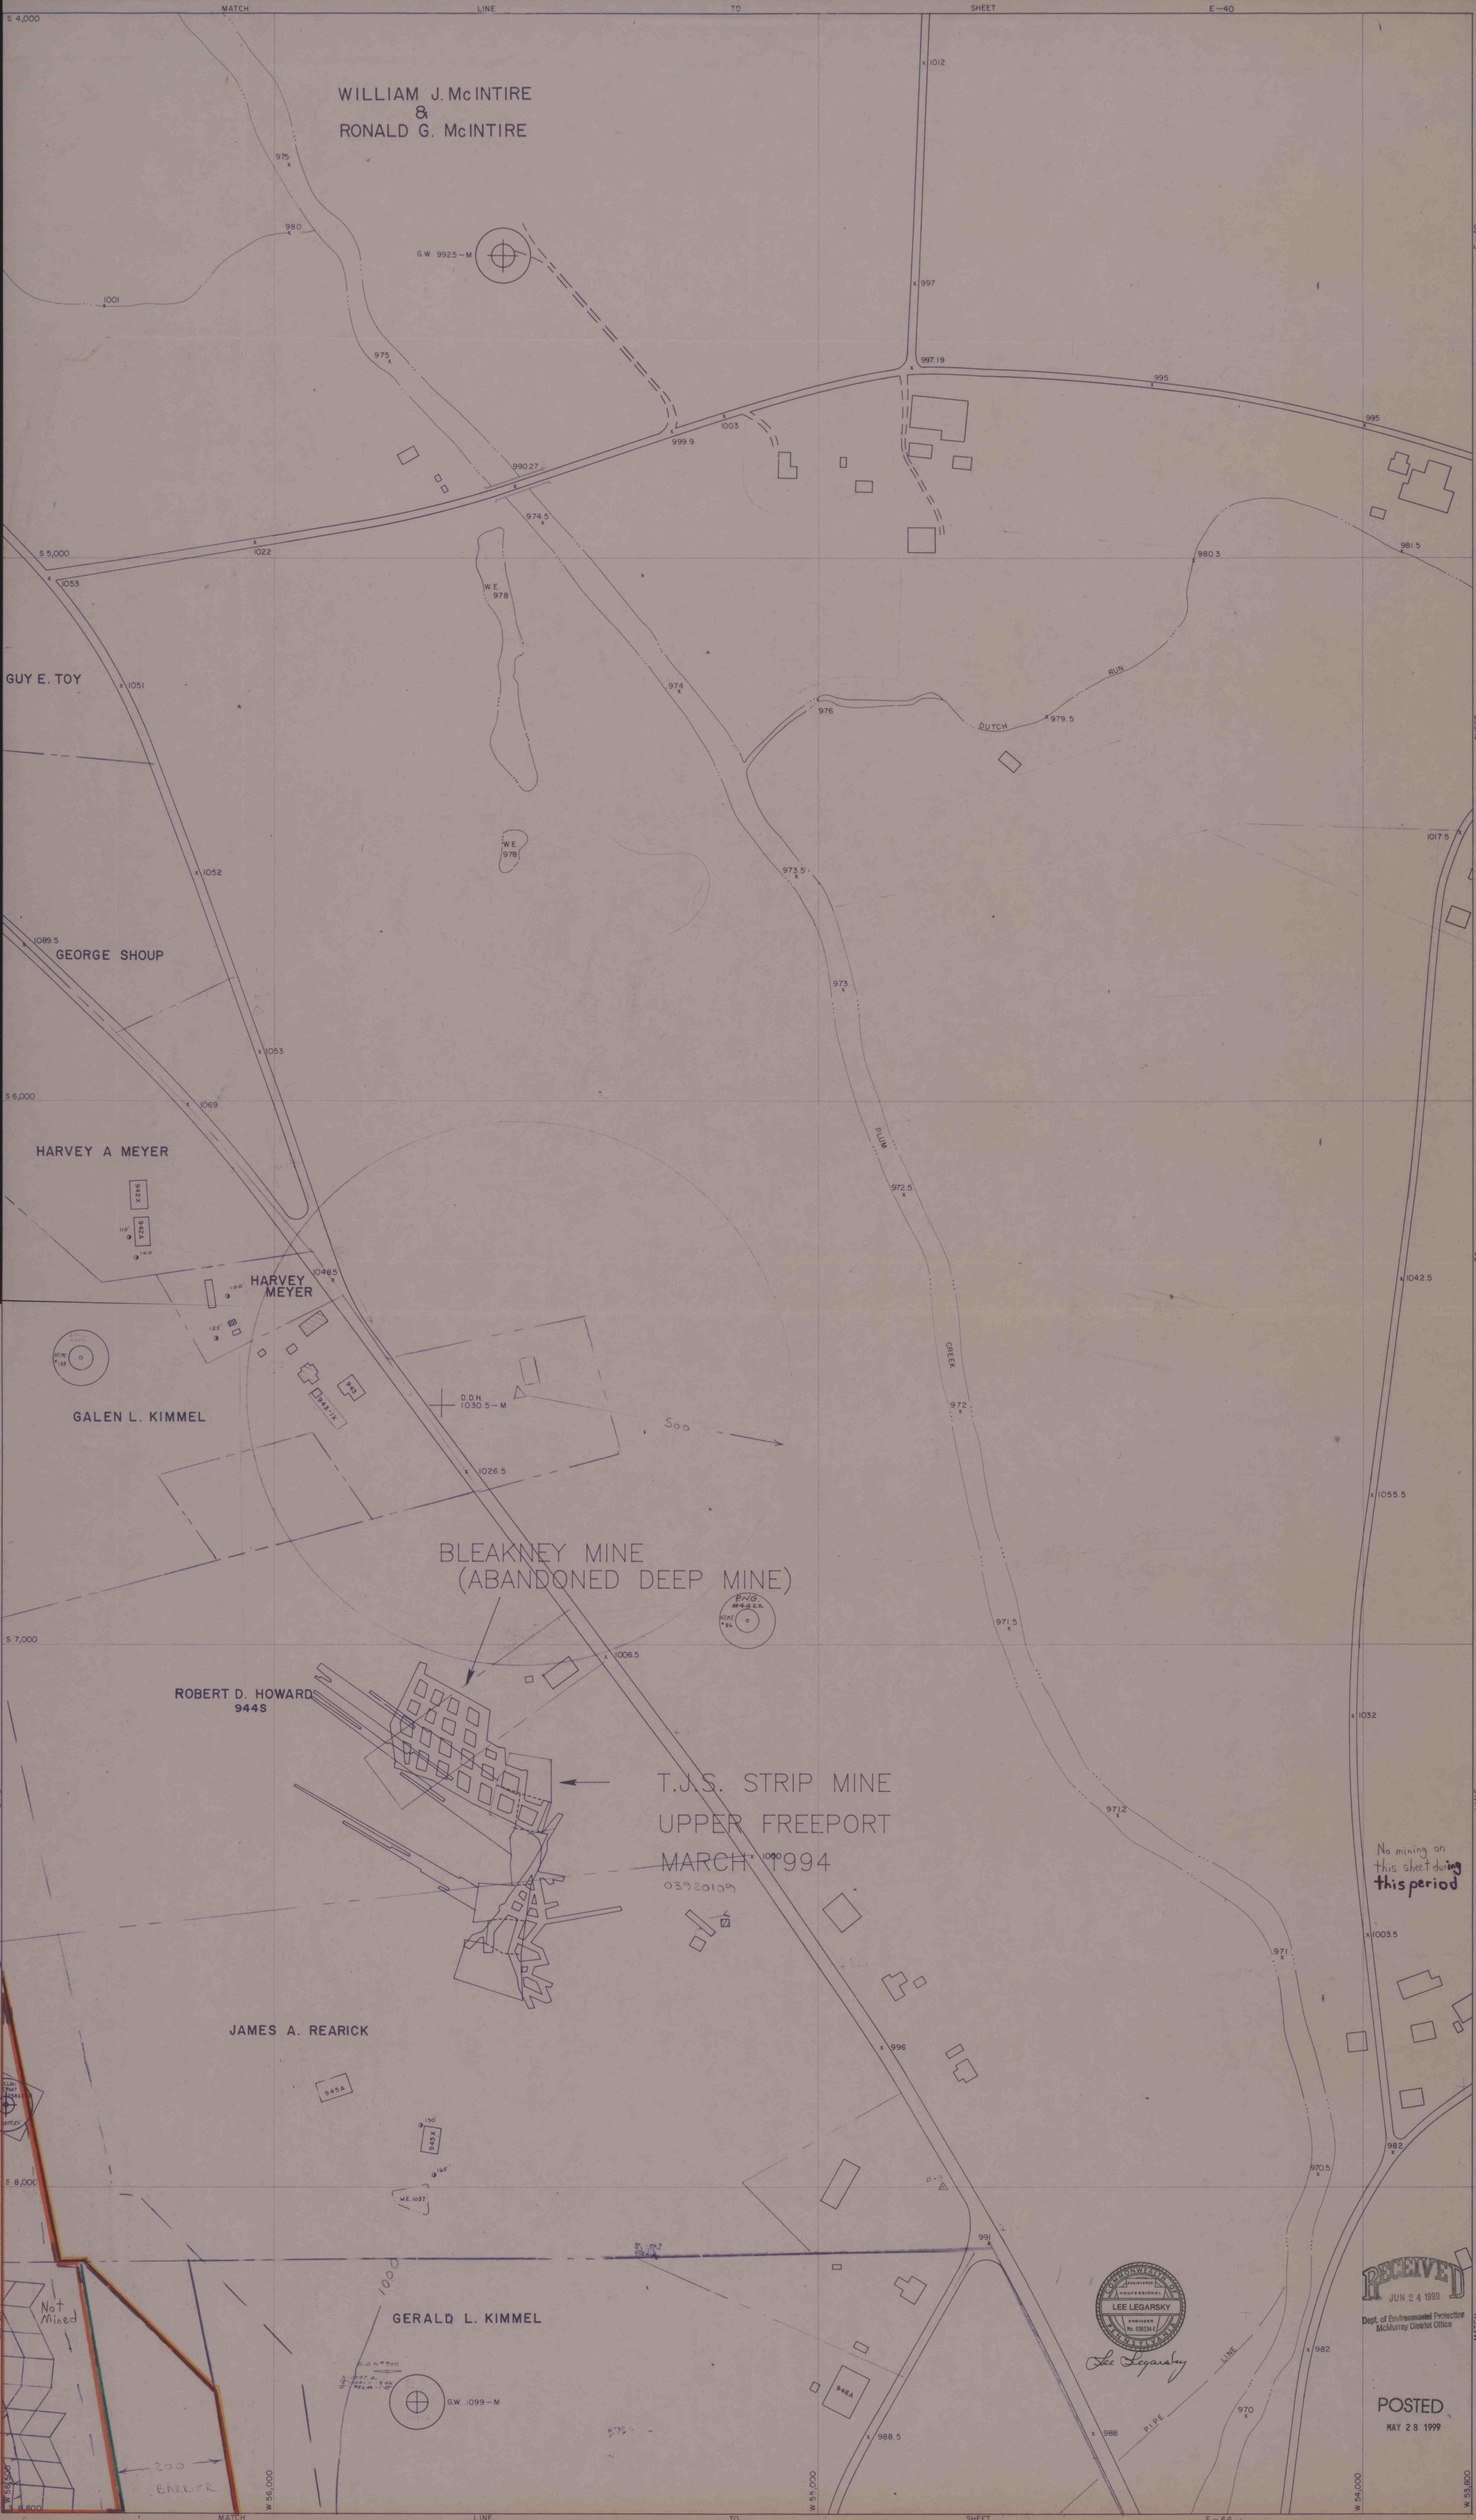

WILLIAM J. McINTIRE
&
RONALD G. McINTIRE

GUY E. TOY

GEORGE SHOUP

HARVEY A MEYER

HARVEY MEYER

GALEN L. KIMMEL



BLEAKNEY MINE
(ABANDONED DEEP MINE)

ROBERT D. HOWARD
9445

T.J.S. STRIP MINE
UPPER FREEPORT
MARCH 10, 1994
03920109

JAMES A. REARICK

GERALD L. KIMMEL

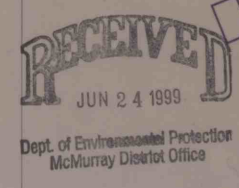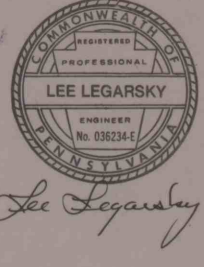

POSTED
MAY 28 1999

DRAWING E-48

DRAWING E-48

DRAWING E-48

CONTEMPLATED MINING FROM 6-1-99 TO 12-1-99

POSTED
MAY 28 1999

KEYSTONE COAL MINING CORPORATION
EMILIE No. 1 & 2 MINE
UPPER FREEPORT COAL SEAM
PLUMCREEK & SOUTH BEND TOWNS
ARMSTRONG COUNTY, PENNSYLVANIA