


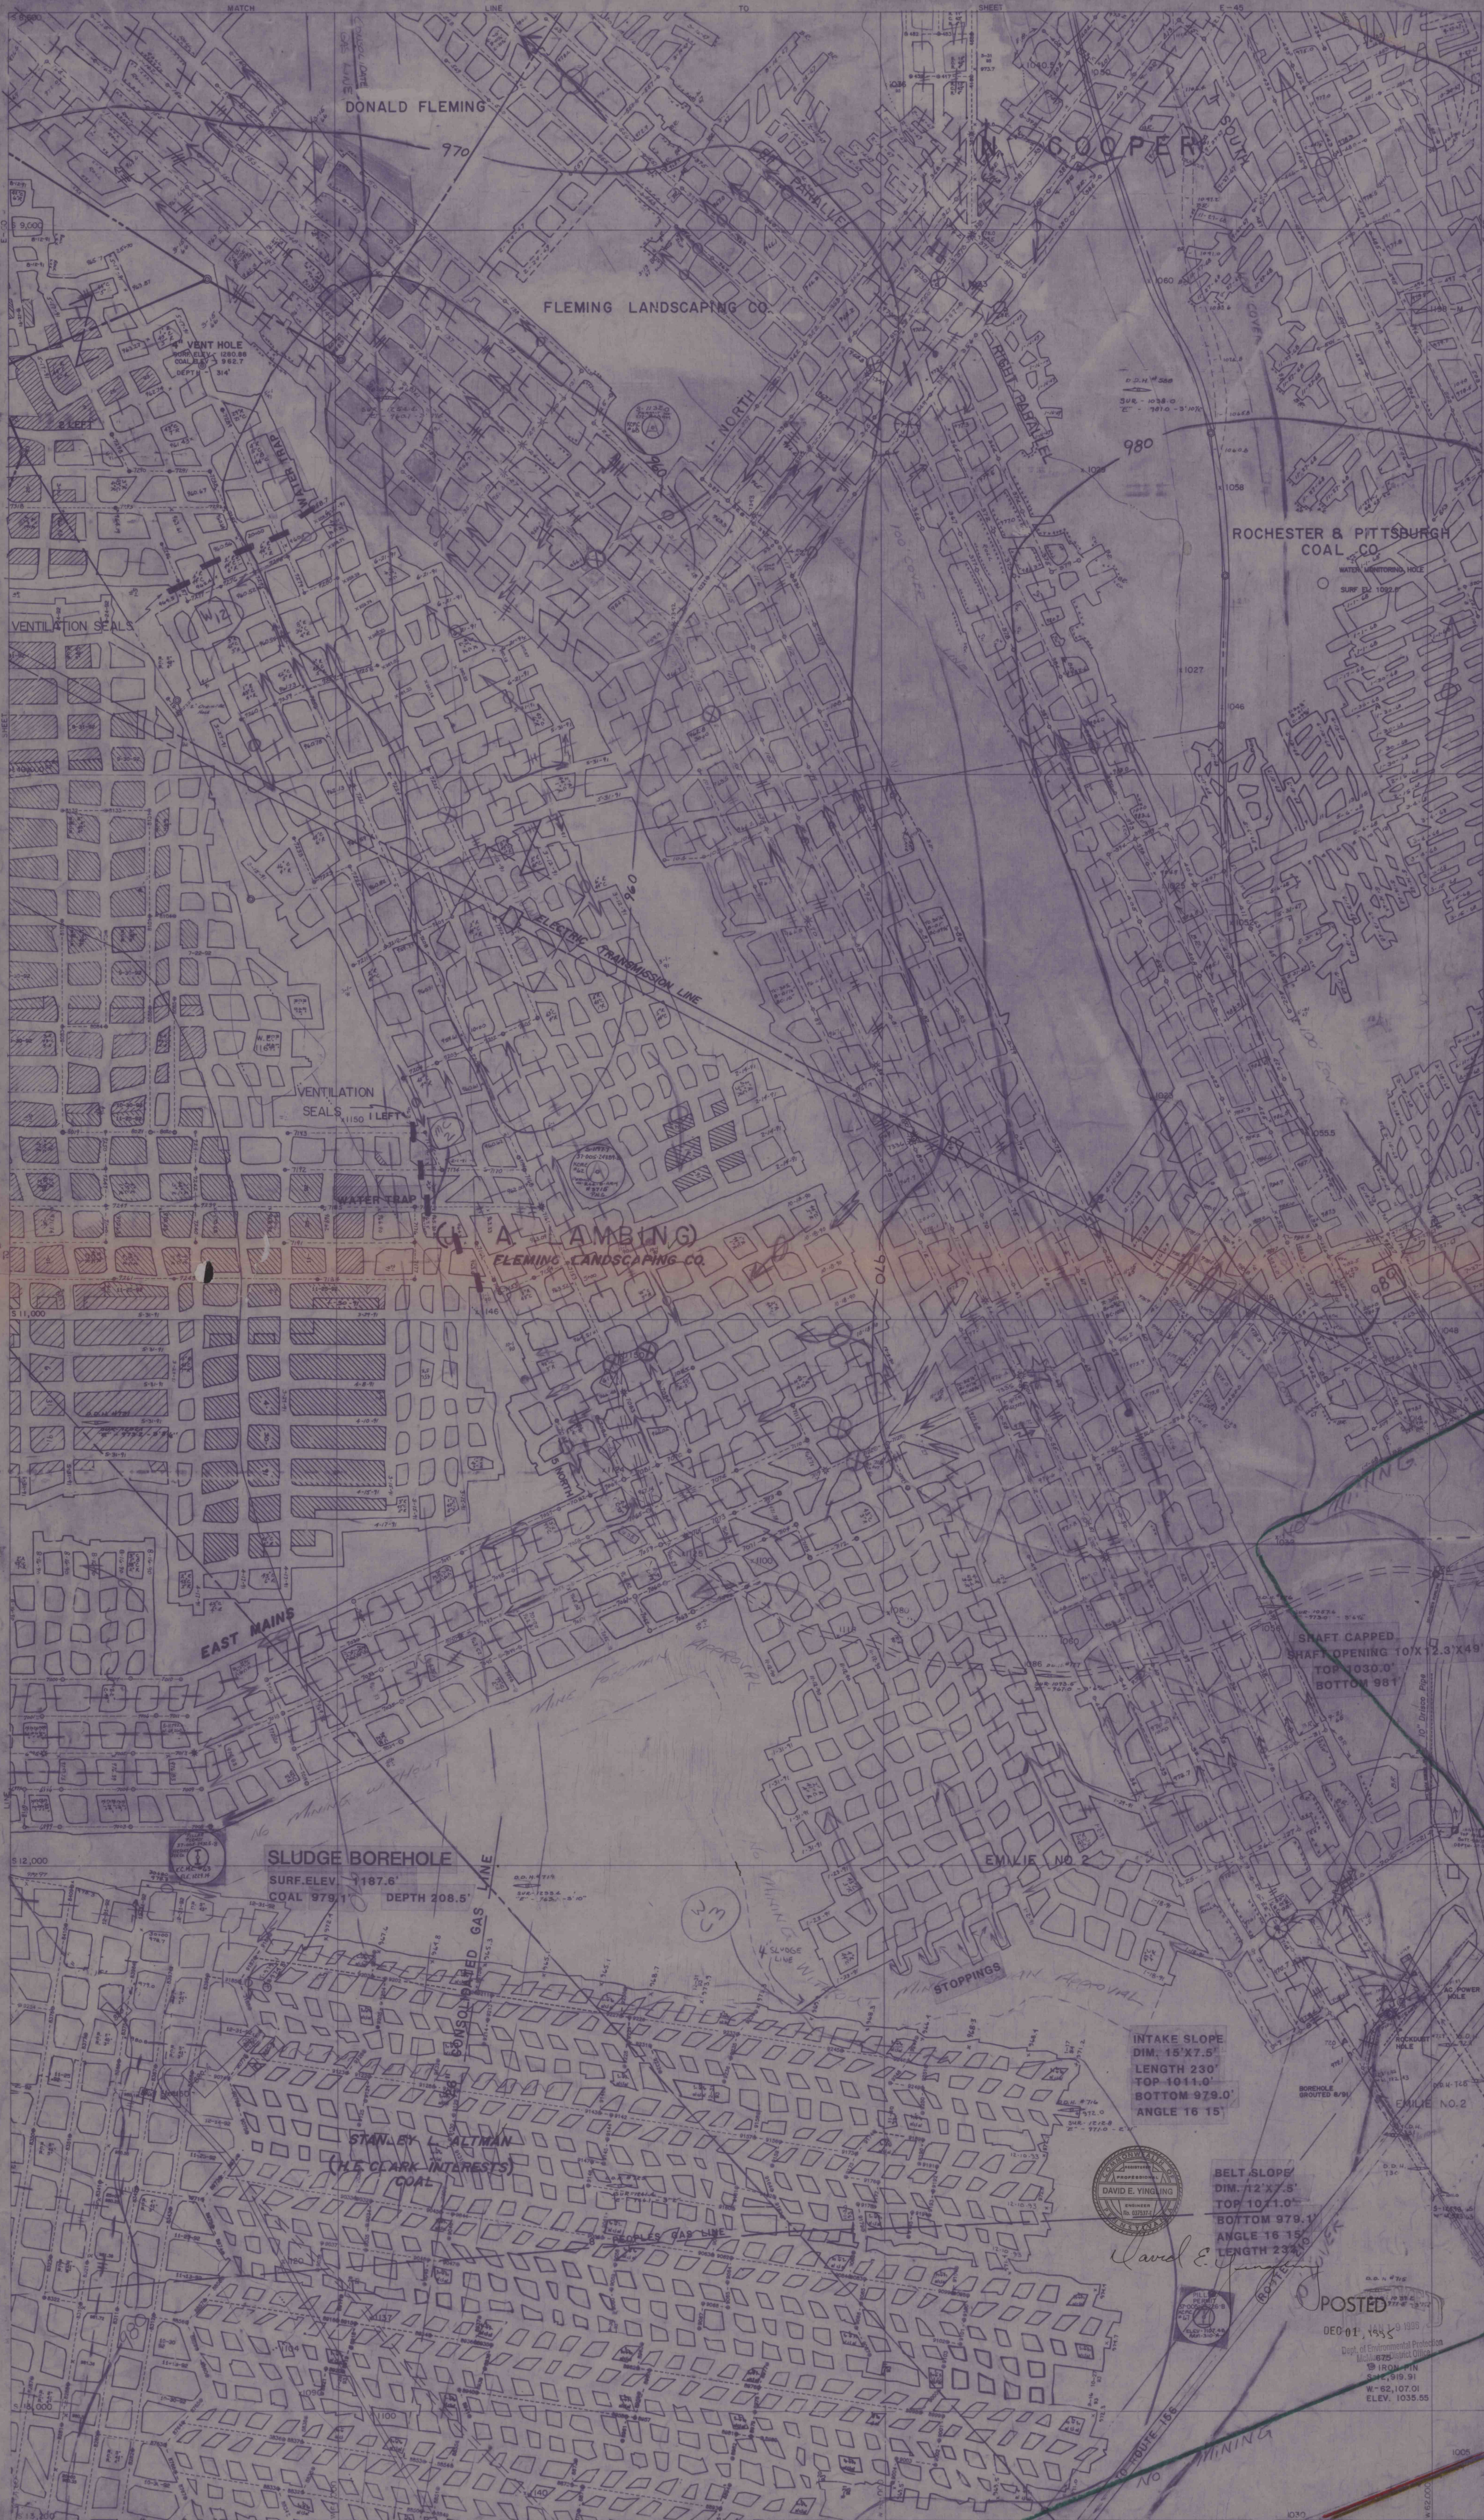

DONALD FLEMING

FLEMING LANDSCAPING CO.

ROCHESTER & PITTSBURGH COAL CO.

STANLEY L. ALTMAN
(PLC CLARK INTERESTS) COAL

SLUDGE BOREHOLE
SURF. ELEV. 1187.6'
COAL 979.1' DEPTH 208.5'

INTAKE SLOPE
DIM. 15'X7.5'
LENGTH 230'
TOP 1011.0'
BOTTOM 979.0'
ANGLE 16 15'

BELT SLOPE
DIM. 12'X7.5'
TOP 1011.0'
BOTTOM 979.1'
ANGLE 16 15'
LENGTH 232'

POSTED
DEC 01 1993
Dept. of Environmental Protection
IR 93-0131
W-62,107.01
ELEV. 1035.55