


Lee Legarsky

FINAL POSTING

POSTED
DEC 01 1999

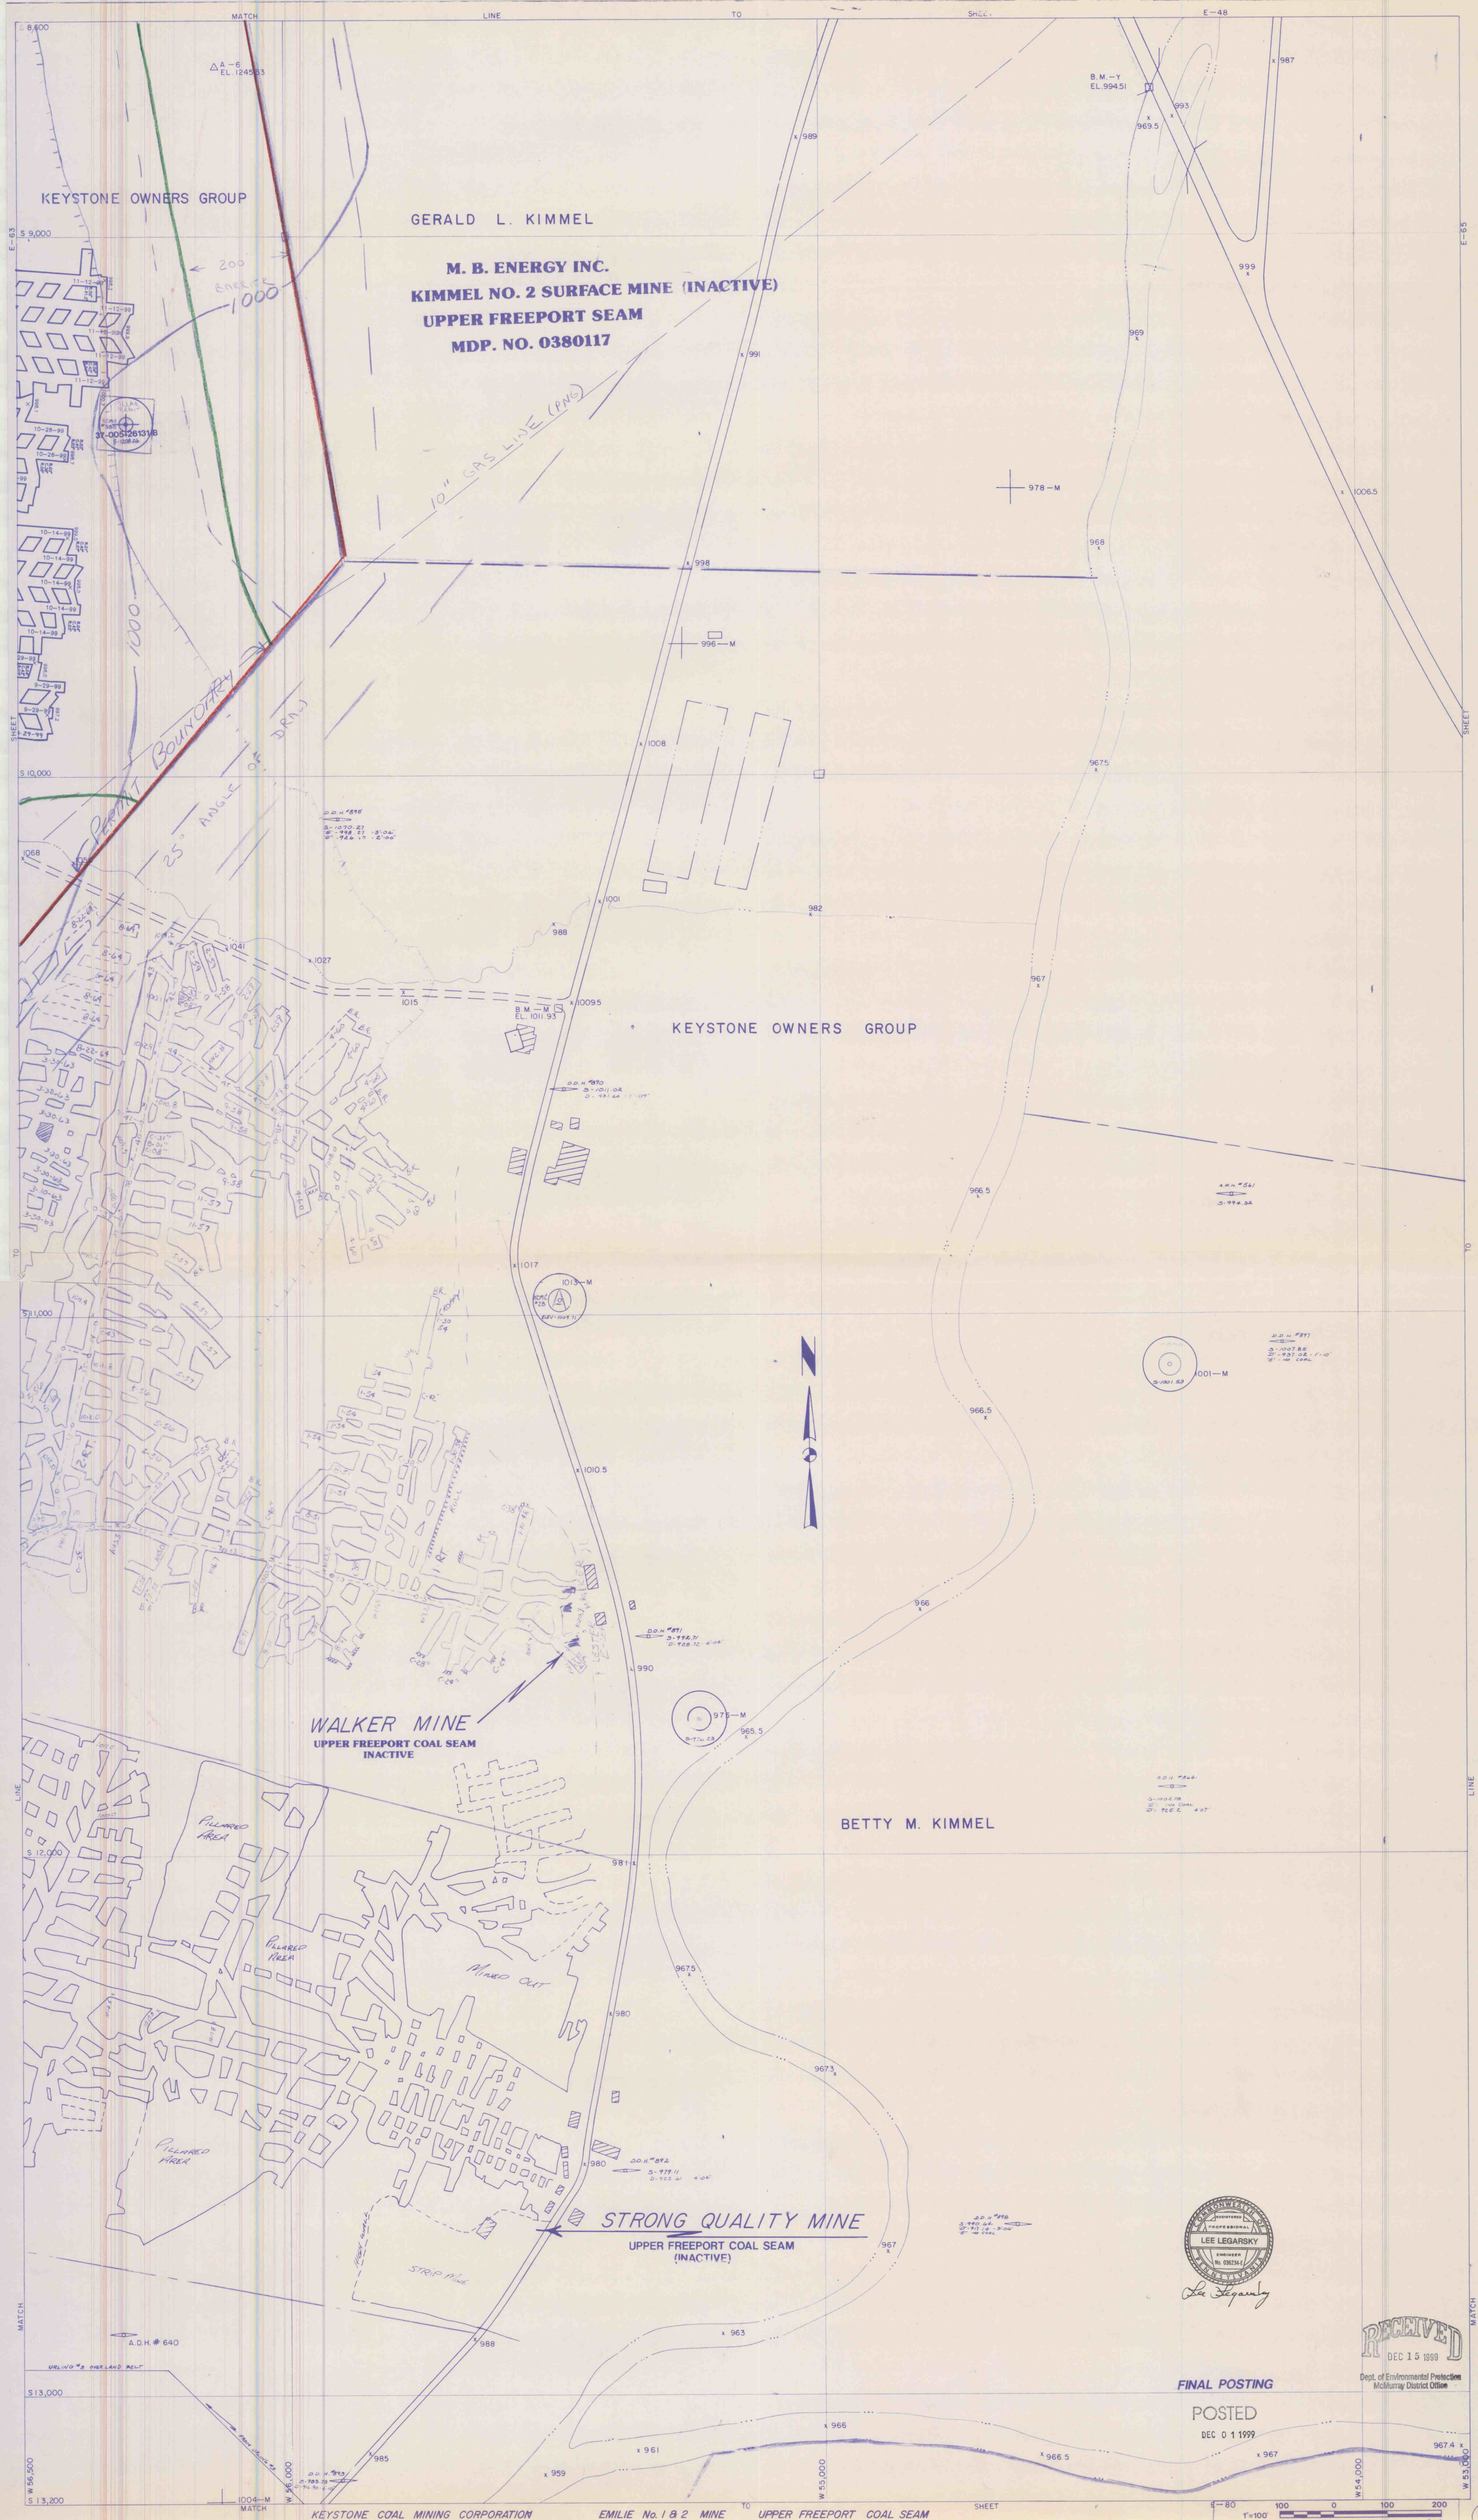