


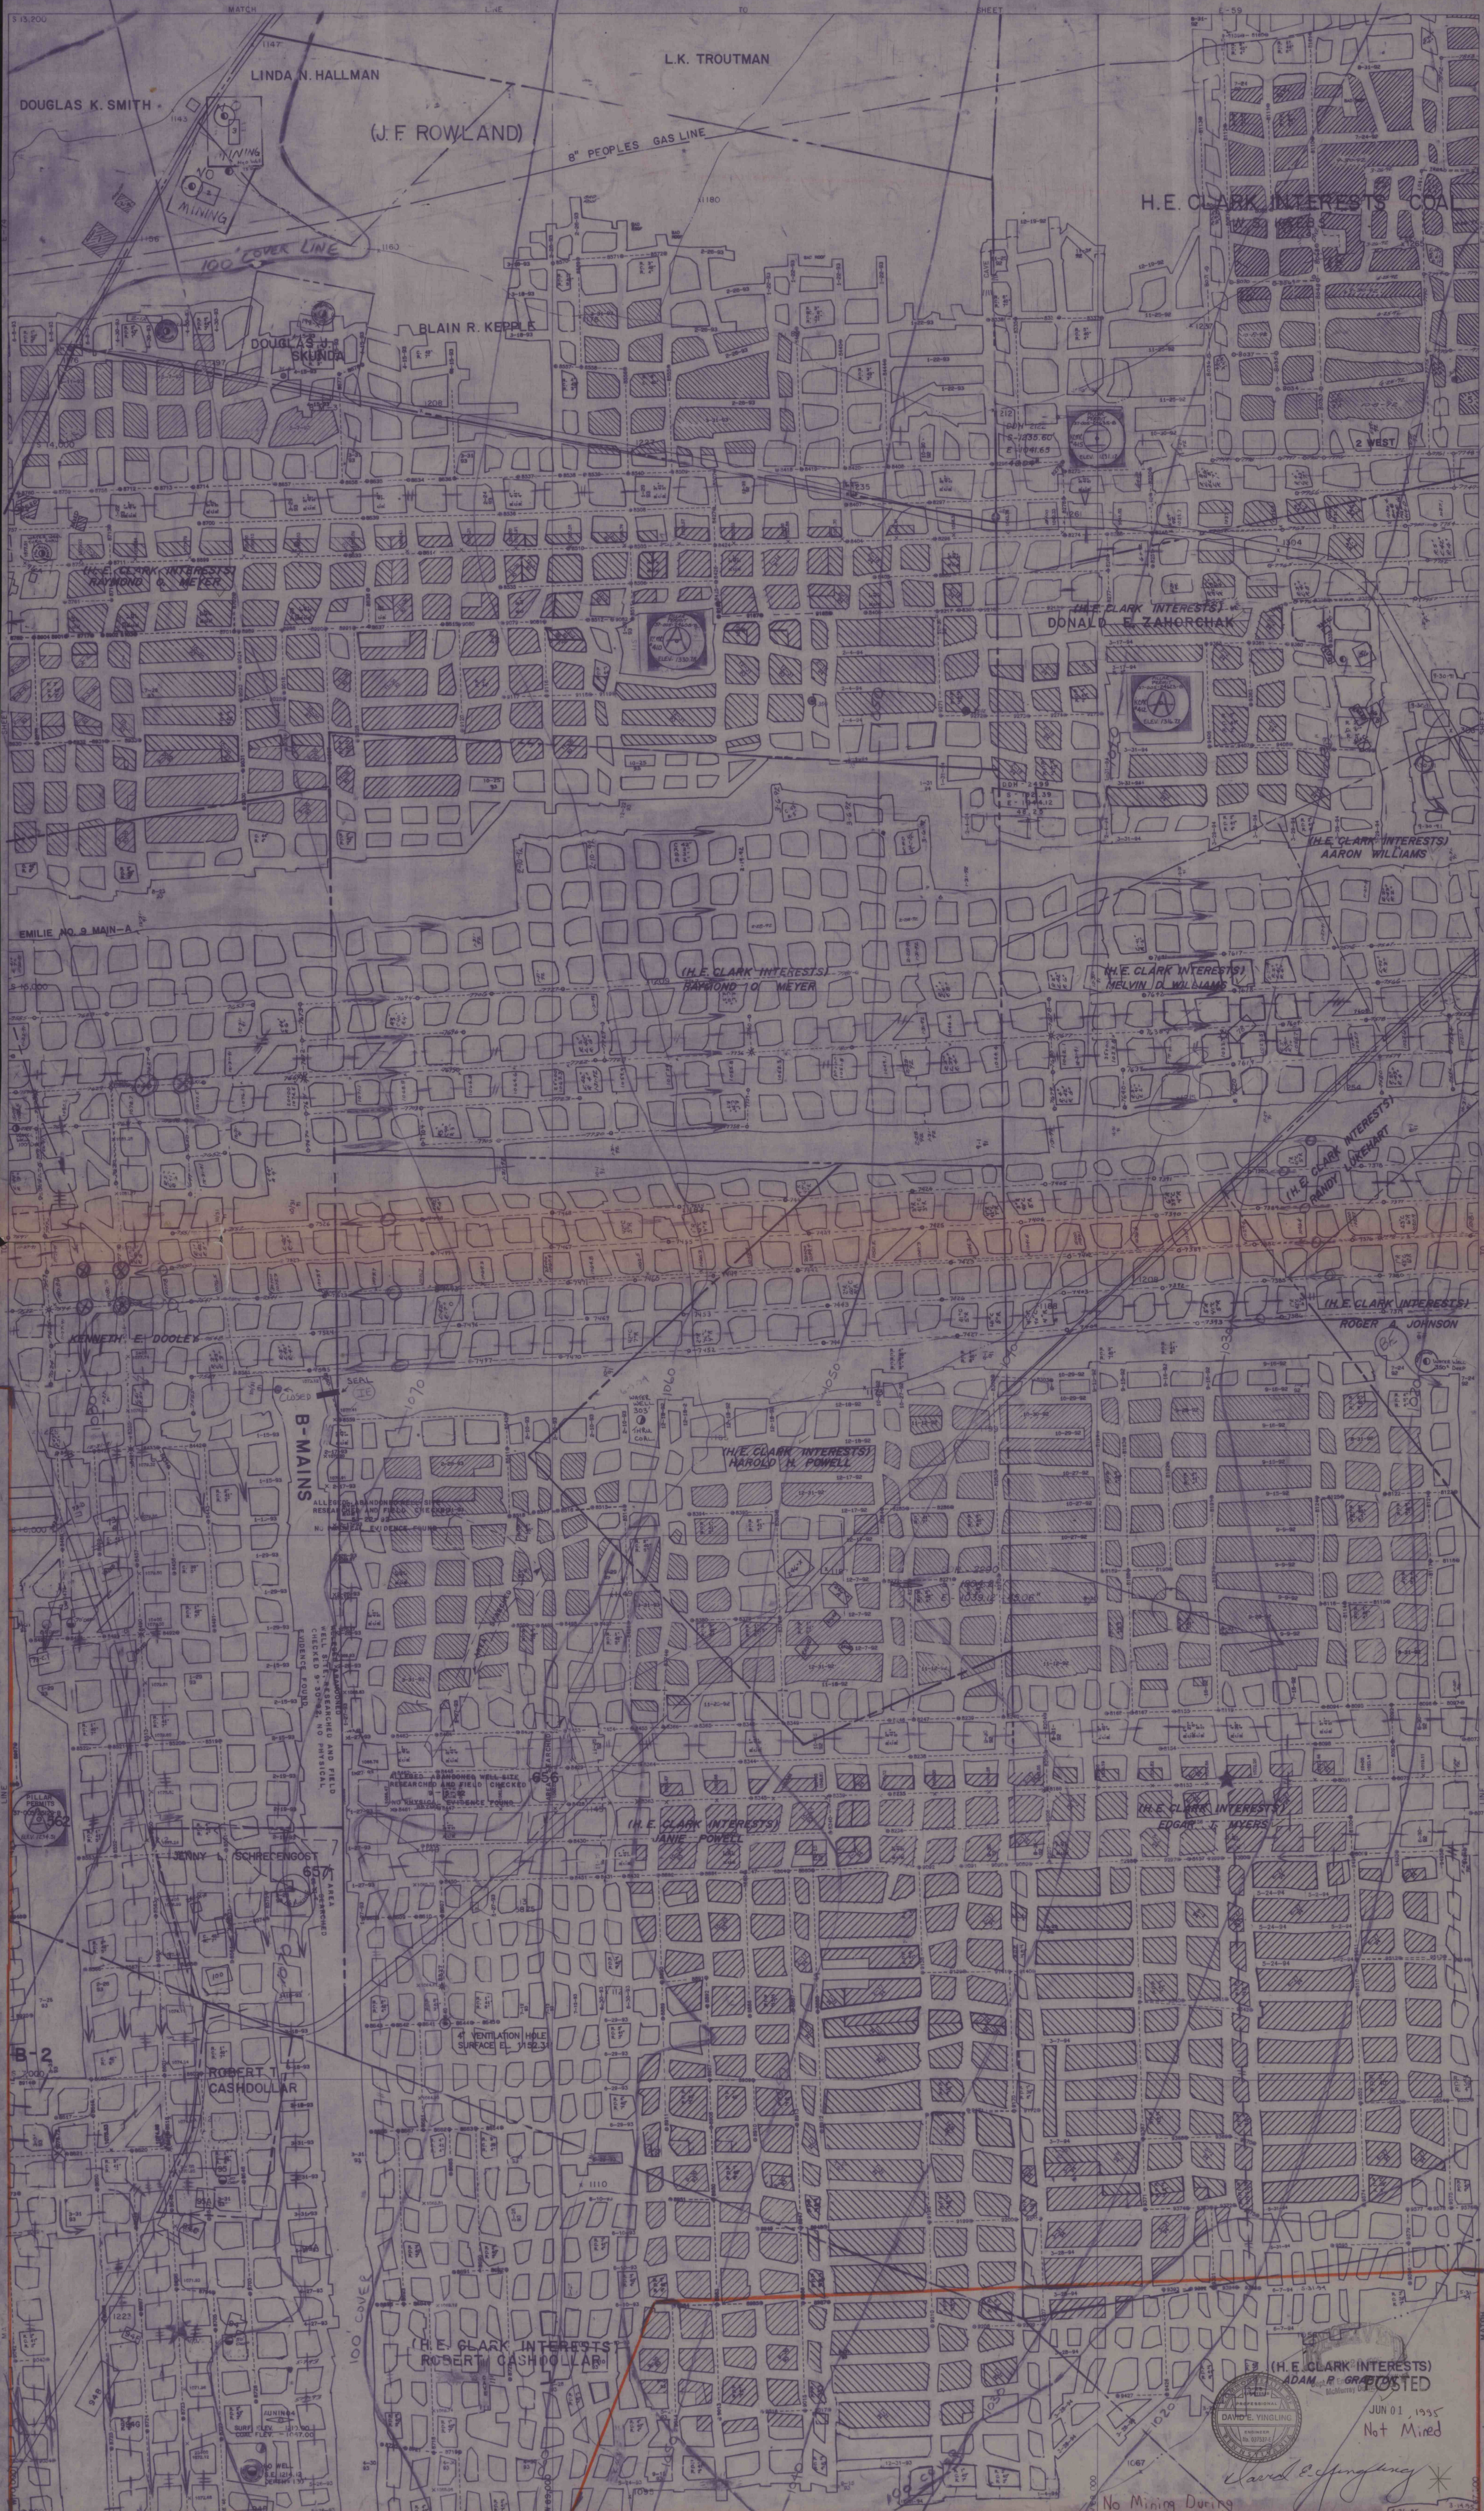

(H.E. CLARK INTERESTS)
ADAM R. GRABOSKI
Not Mined
JUN 01 1995
David E. Yingling