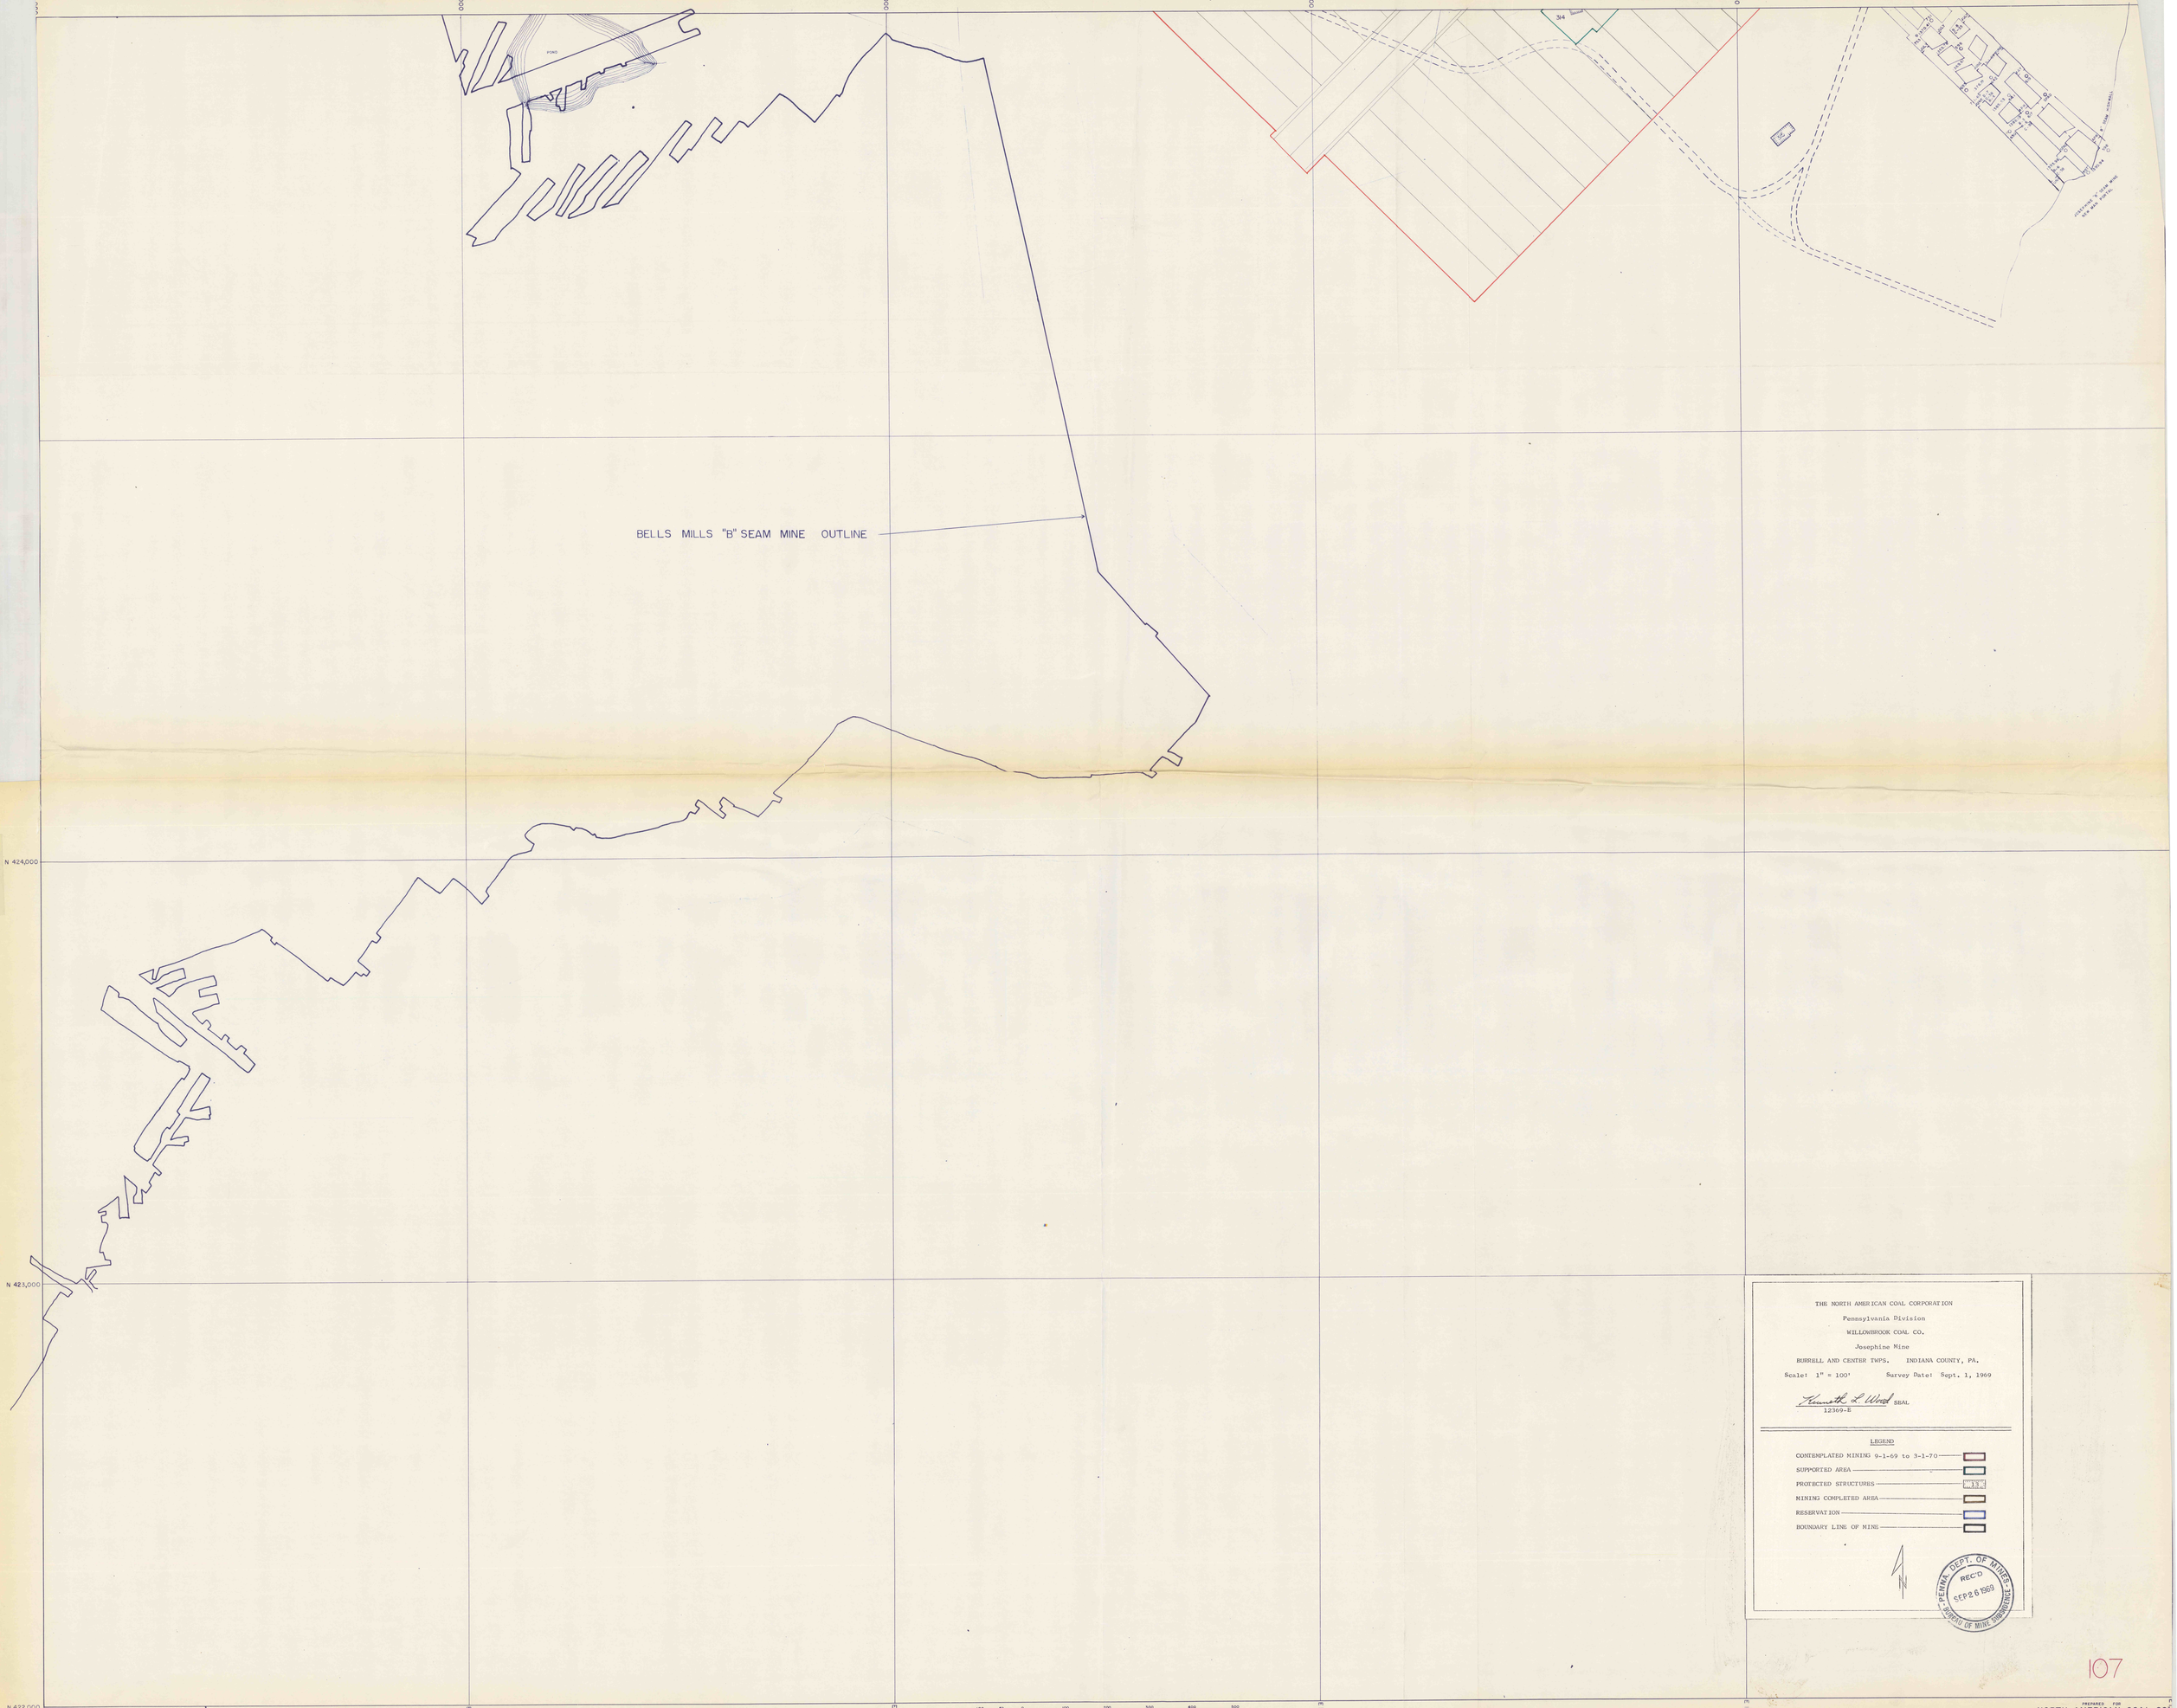
E 1507000
E 1508000
E 1509000
E 1510000
E 1511000
N 424,000
N 423,000
N 422,000
POND
BELLS MILLS "B" SEAM MINE OUTLINE
3/4
THE NORTH AMERICAN COAL CORPORATION
Pennsylvania Division
WILLOWBROOK COAL CO.
Josephine Mine
BURRELL AND CENTER TWPS. INDIANA COUNTY, PA.
Scale: 1" = 100' Survey Date: Sept. 1, 1969
Kenneth L. Wood SEAL
12369-E
LEGEND
CONTEMPLATED MINING 9-1-69 to 3-1-70
SUPPORTED AREA
PROTECTED STRUCTURES
MINING COMPLETED AREA
RESERVATION
BOUNDARY LINE OF MINE
PENNA. DEPT. OF MINES
REC'D
SEP 26 1969
BUREAU OF MINE SUBSIDENCE
AMERICAN AIR SURVEYS, INC.
PITTSBURGH, PA.
SCALE 1"=100'
GRID BASED ON PENNSYLVANIA STATE
COORDINATE SYSTEM SOUTH ZONE.
PREPARED FOR
NORTH AMERICAN COAL CO.
PENNSYLVANIA DIVISION
SHEET

107