



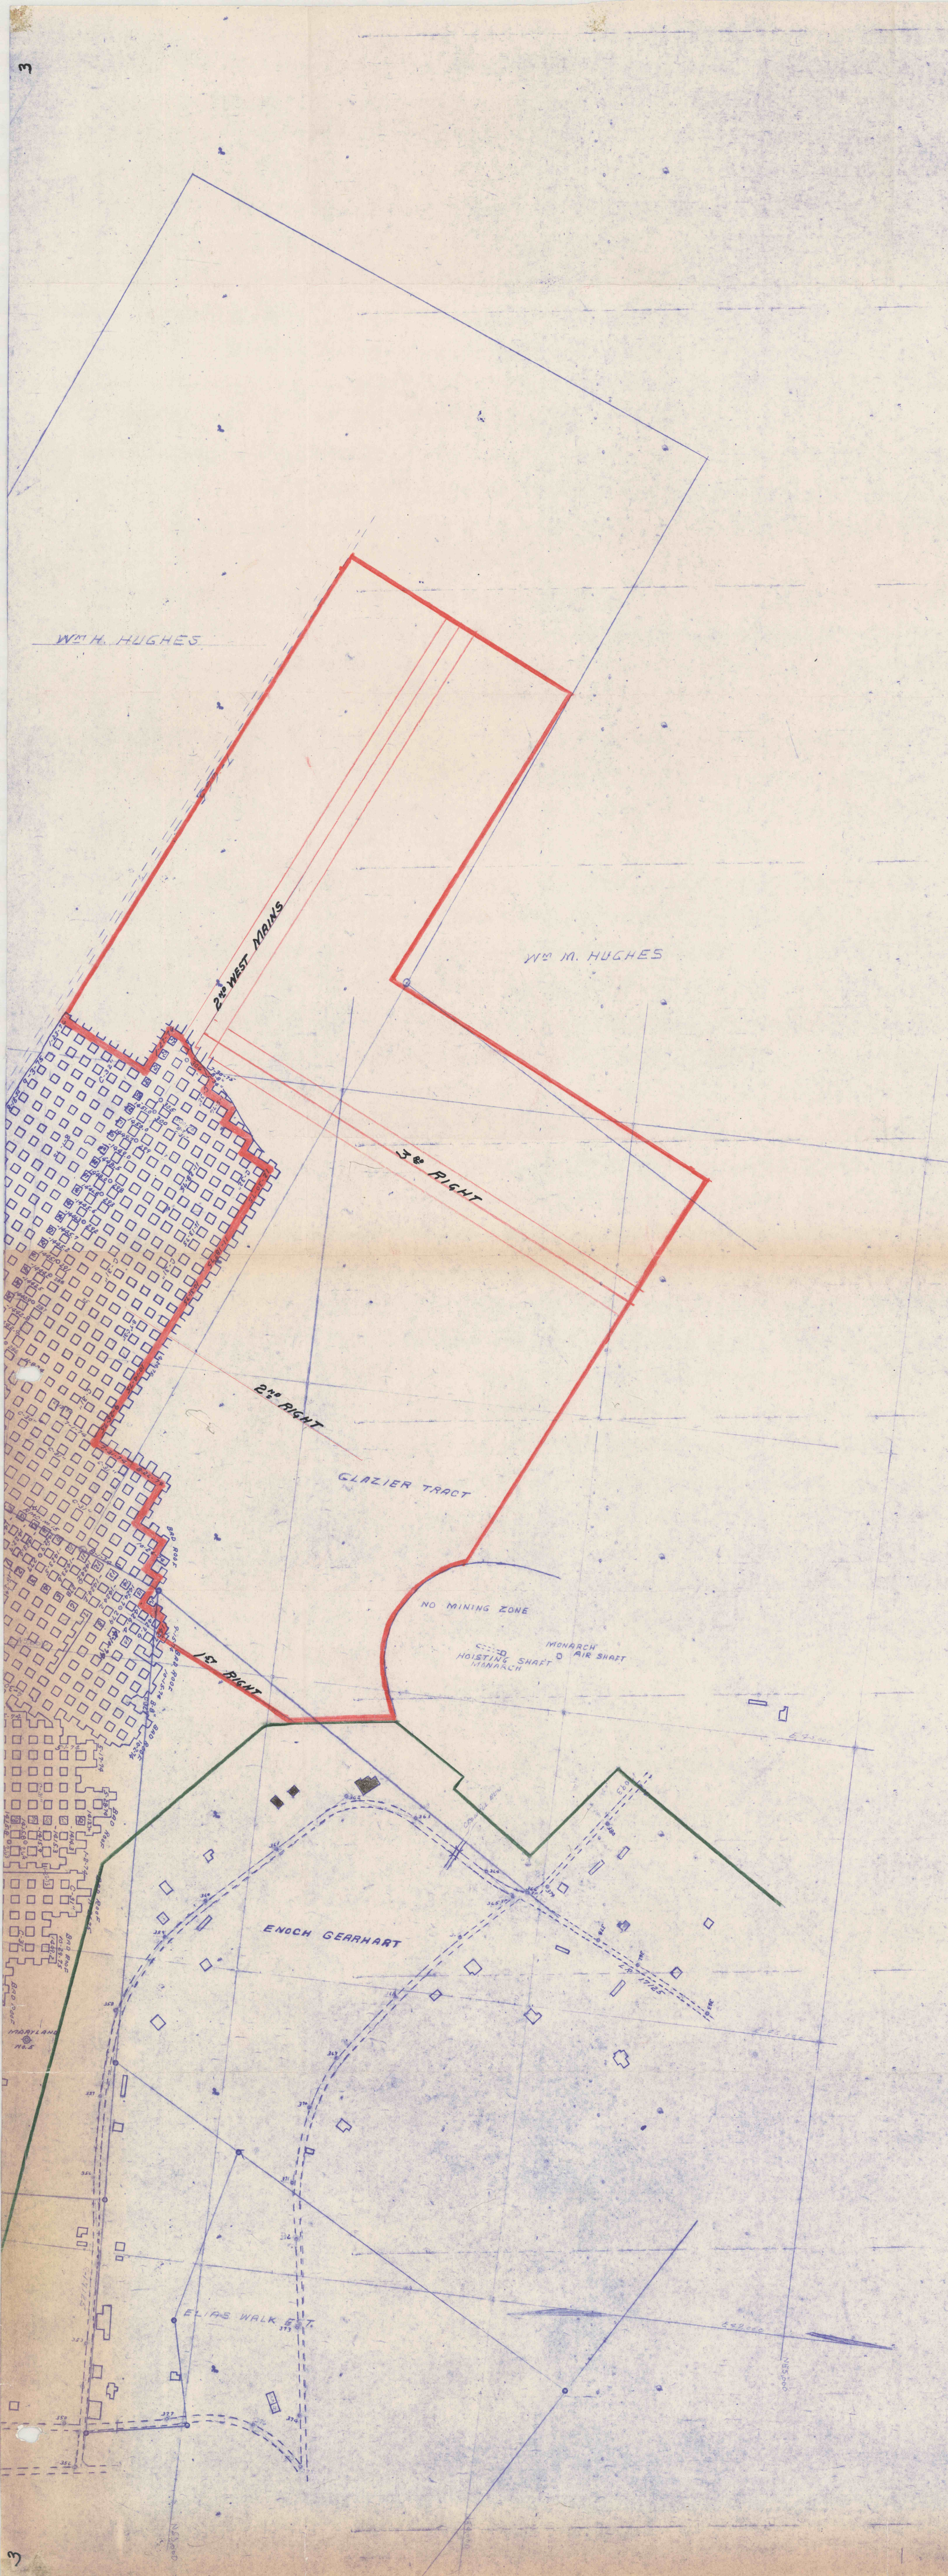

MICROFILMED

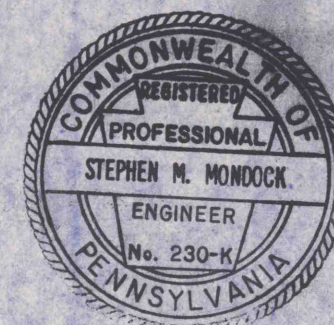

RECEIVED
DIVISION OF MINE
SURVEILLANCE REGULATION
FEB 13 1976
McMURRAY,
PENNSYLVANIA

LEGEND	
—	Contemplated Mining 2-1-76 to 8-1-76
—	Mining Completed Area
—	Permit Boundary
—	Structures Adjacent to Mining Area

USBM ID # 36008680

MAP OF
MINE WORKINGS
C SEAM - KEPHART MINE
ASSOCIATED DRILLING INC.
SITUATED IN
DECATUR TWP. CLERFIELD CO. PA.
SCALE 1 inch = 200 FT. 8-18-66
REVISED 1-27-76

SHEET NO. 3

FEB 76