


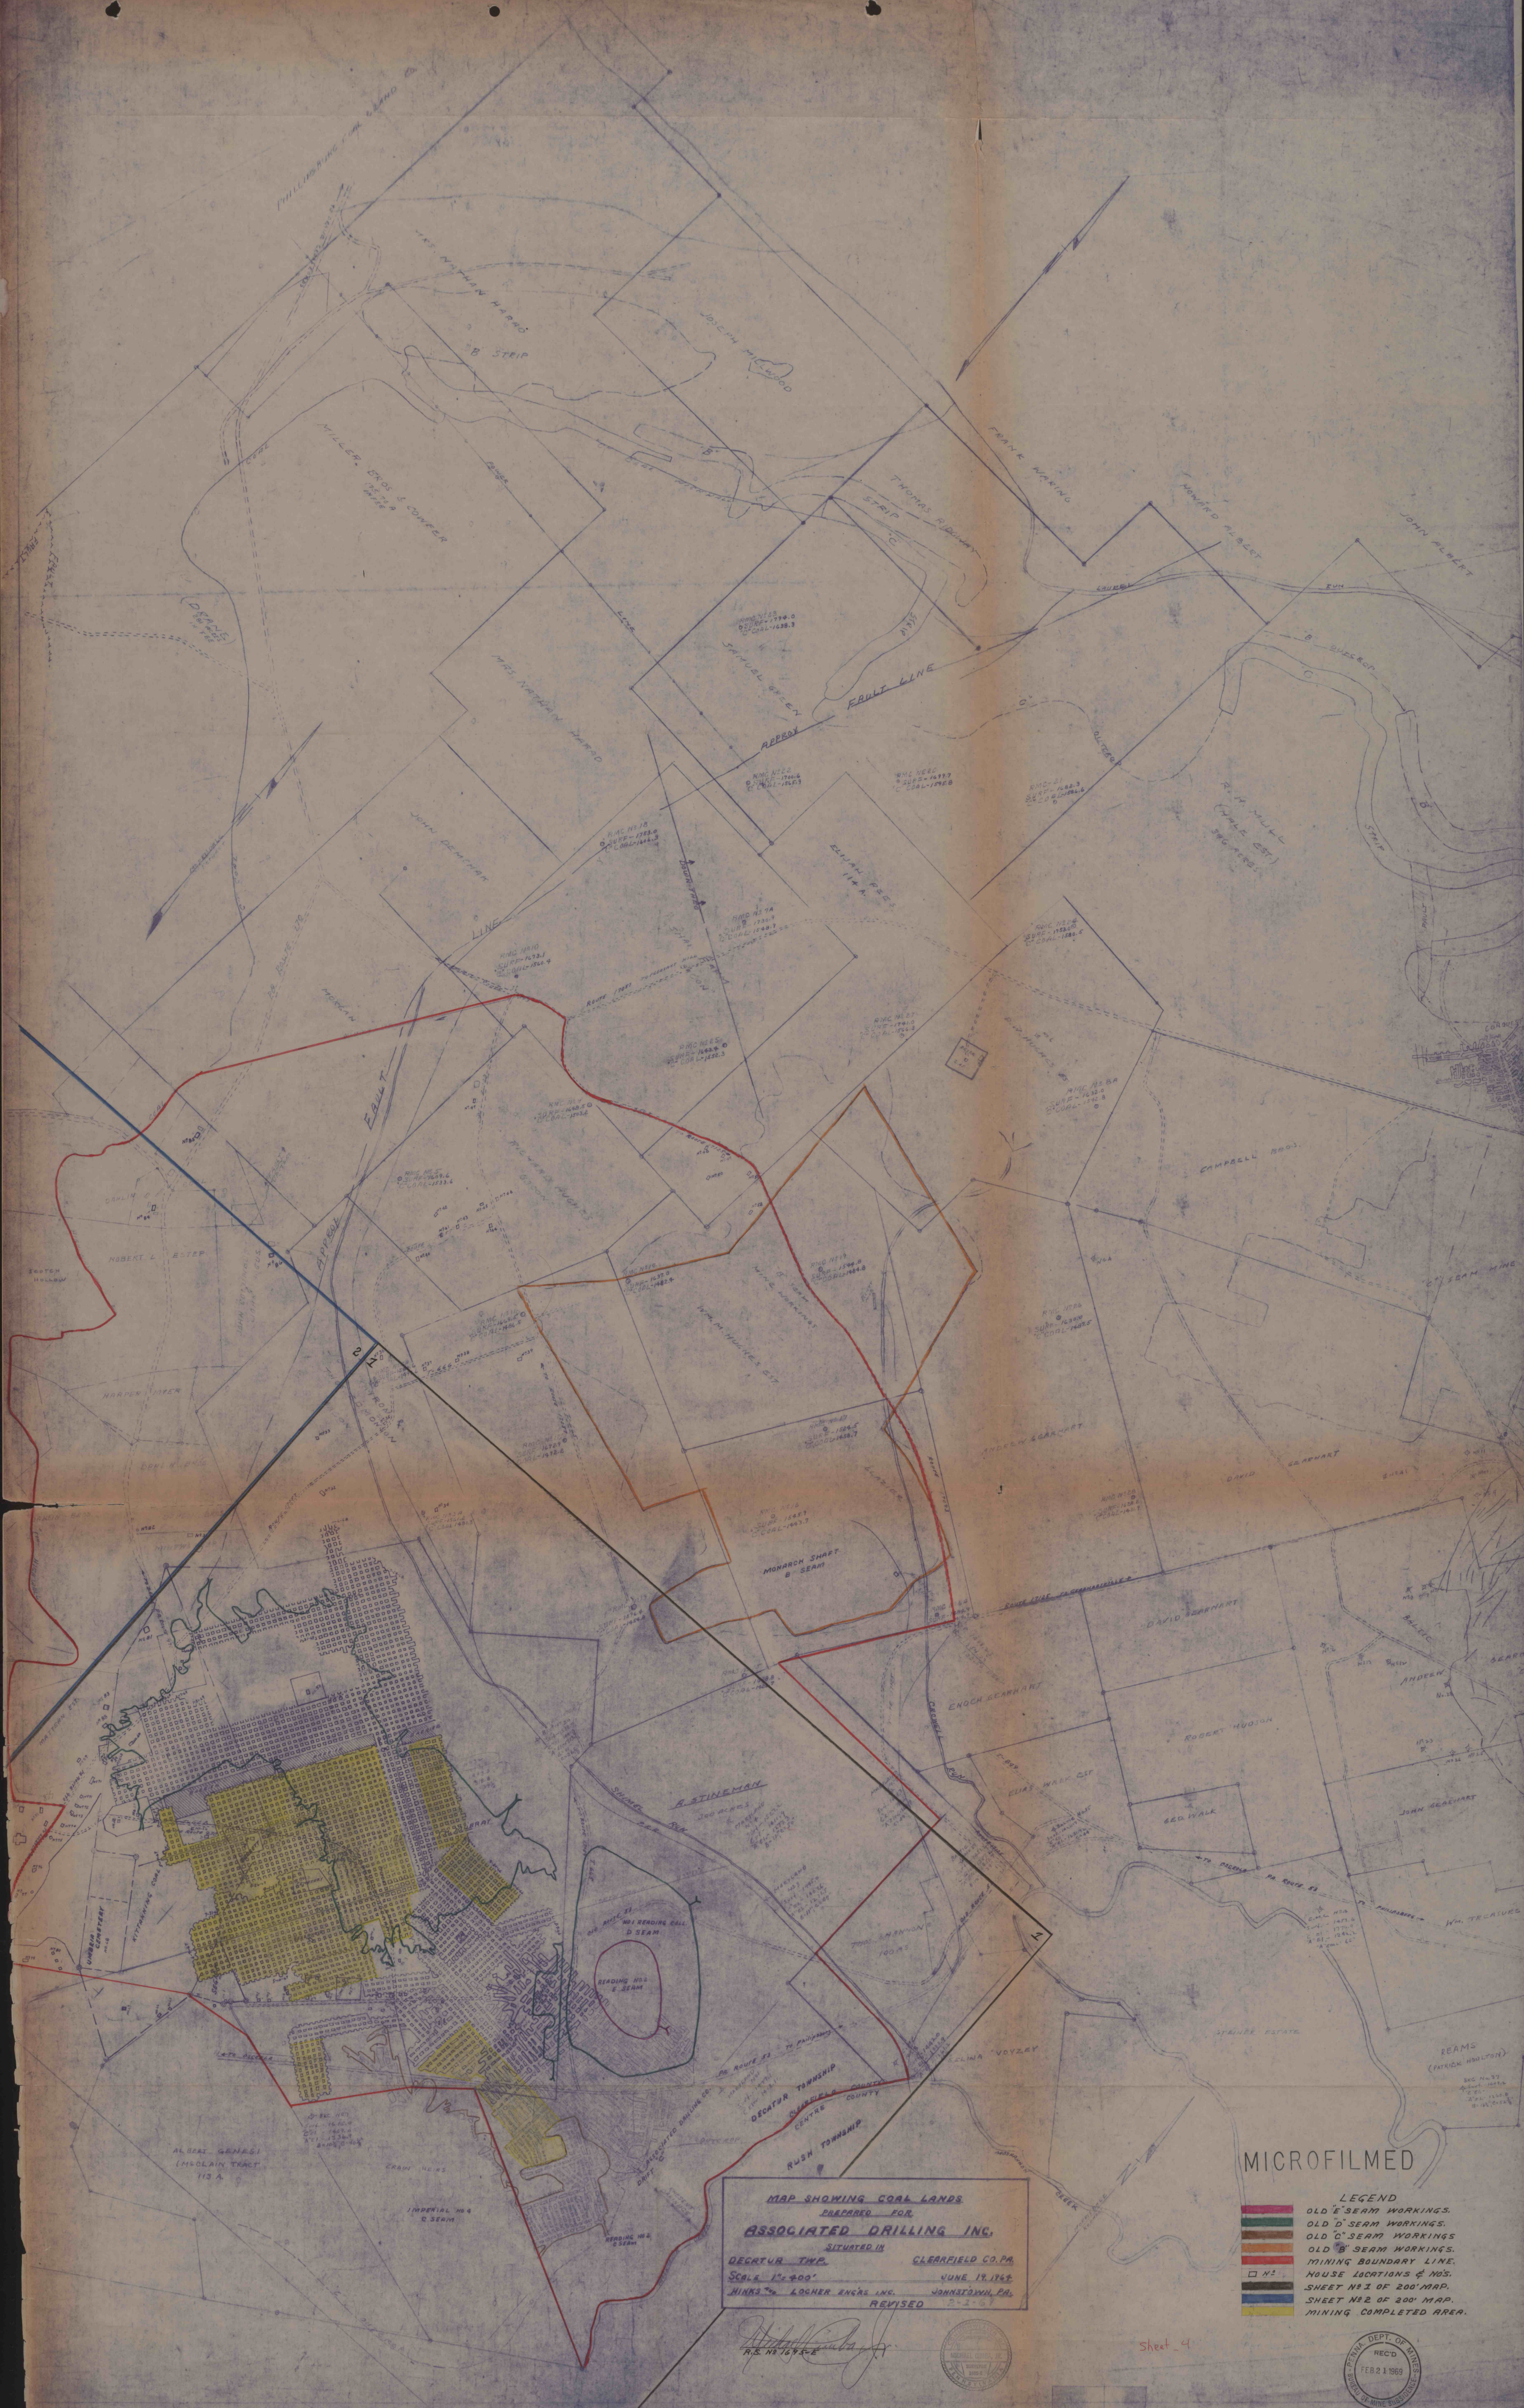

MAP SHOWING COAL LANDS
PREPARED FOR
ASSOCIATED DRILLING INC.
SITUATED IN
DECATUR TWP. CLEARFIELD CO. PA.
SCALE 1" = 400' JUNE 19, 1955
HINKS & LOCHER ENGINEERS, JOHNSTOWN, PA.
REVISED 5-2-57

MICROFILMED

LEGEND

- OLD E SEAM WORKINGS.
- OLD D SEAM WORKINGS.
- OLD C SEAM WORKINGS.
- OLD B SEAM WORKINGS.
- MINING BOUNDARY LINE.
- HOUSE LOCATIONS & NOS.
- SHEET NO 1 OF 200 MAP.
- SHEET NO 2 OF 200 MAP.
- MINING COMPLETED AREA.

Sheet 4

