




Note: This Plan is a composite of surface and sub-surface deeds, where necessary the deed bearings and distances were adjusted to correct individual deeds and to provide properties with continuous lines. No field survey verifications where done. Ownership data was provided by the owner.

IONS:					
-------	--	--	--	--	--

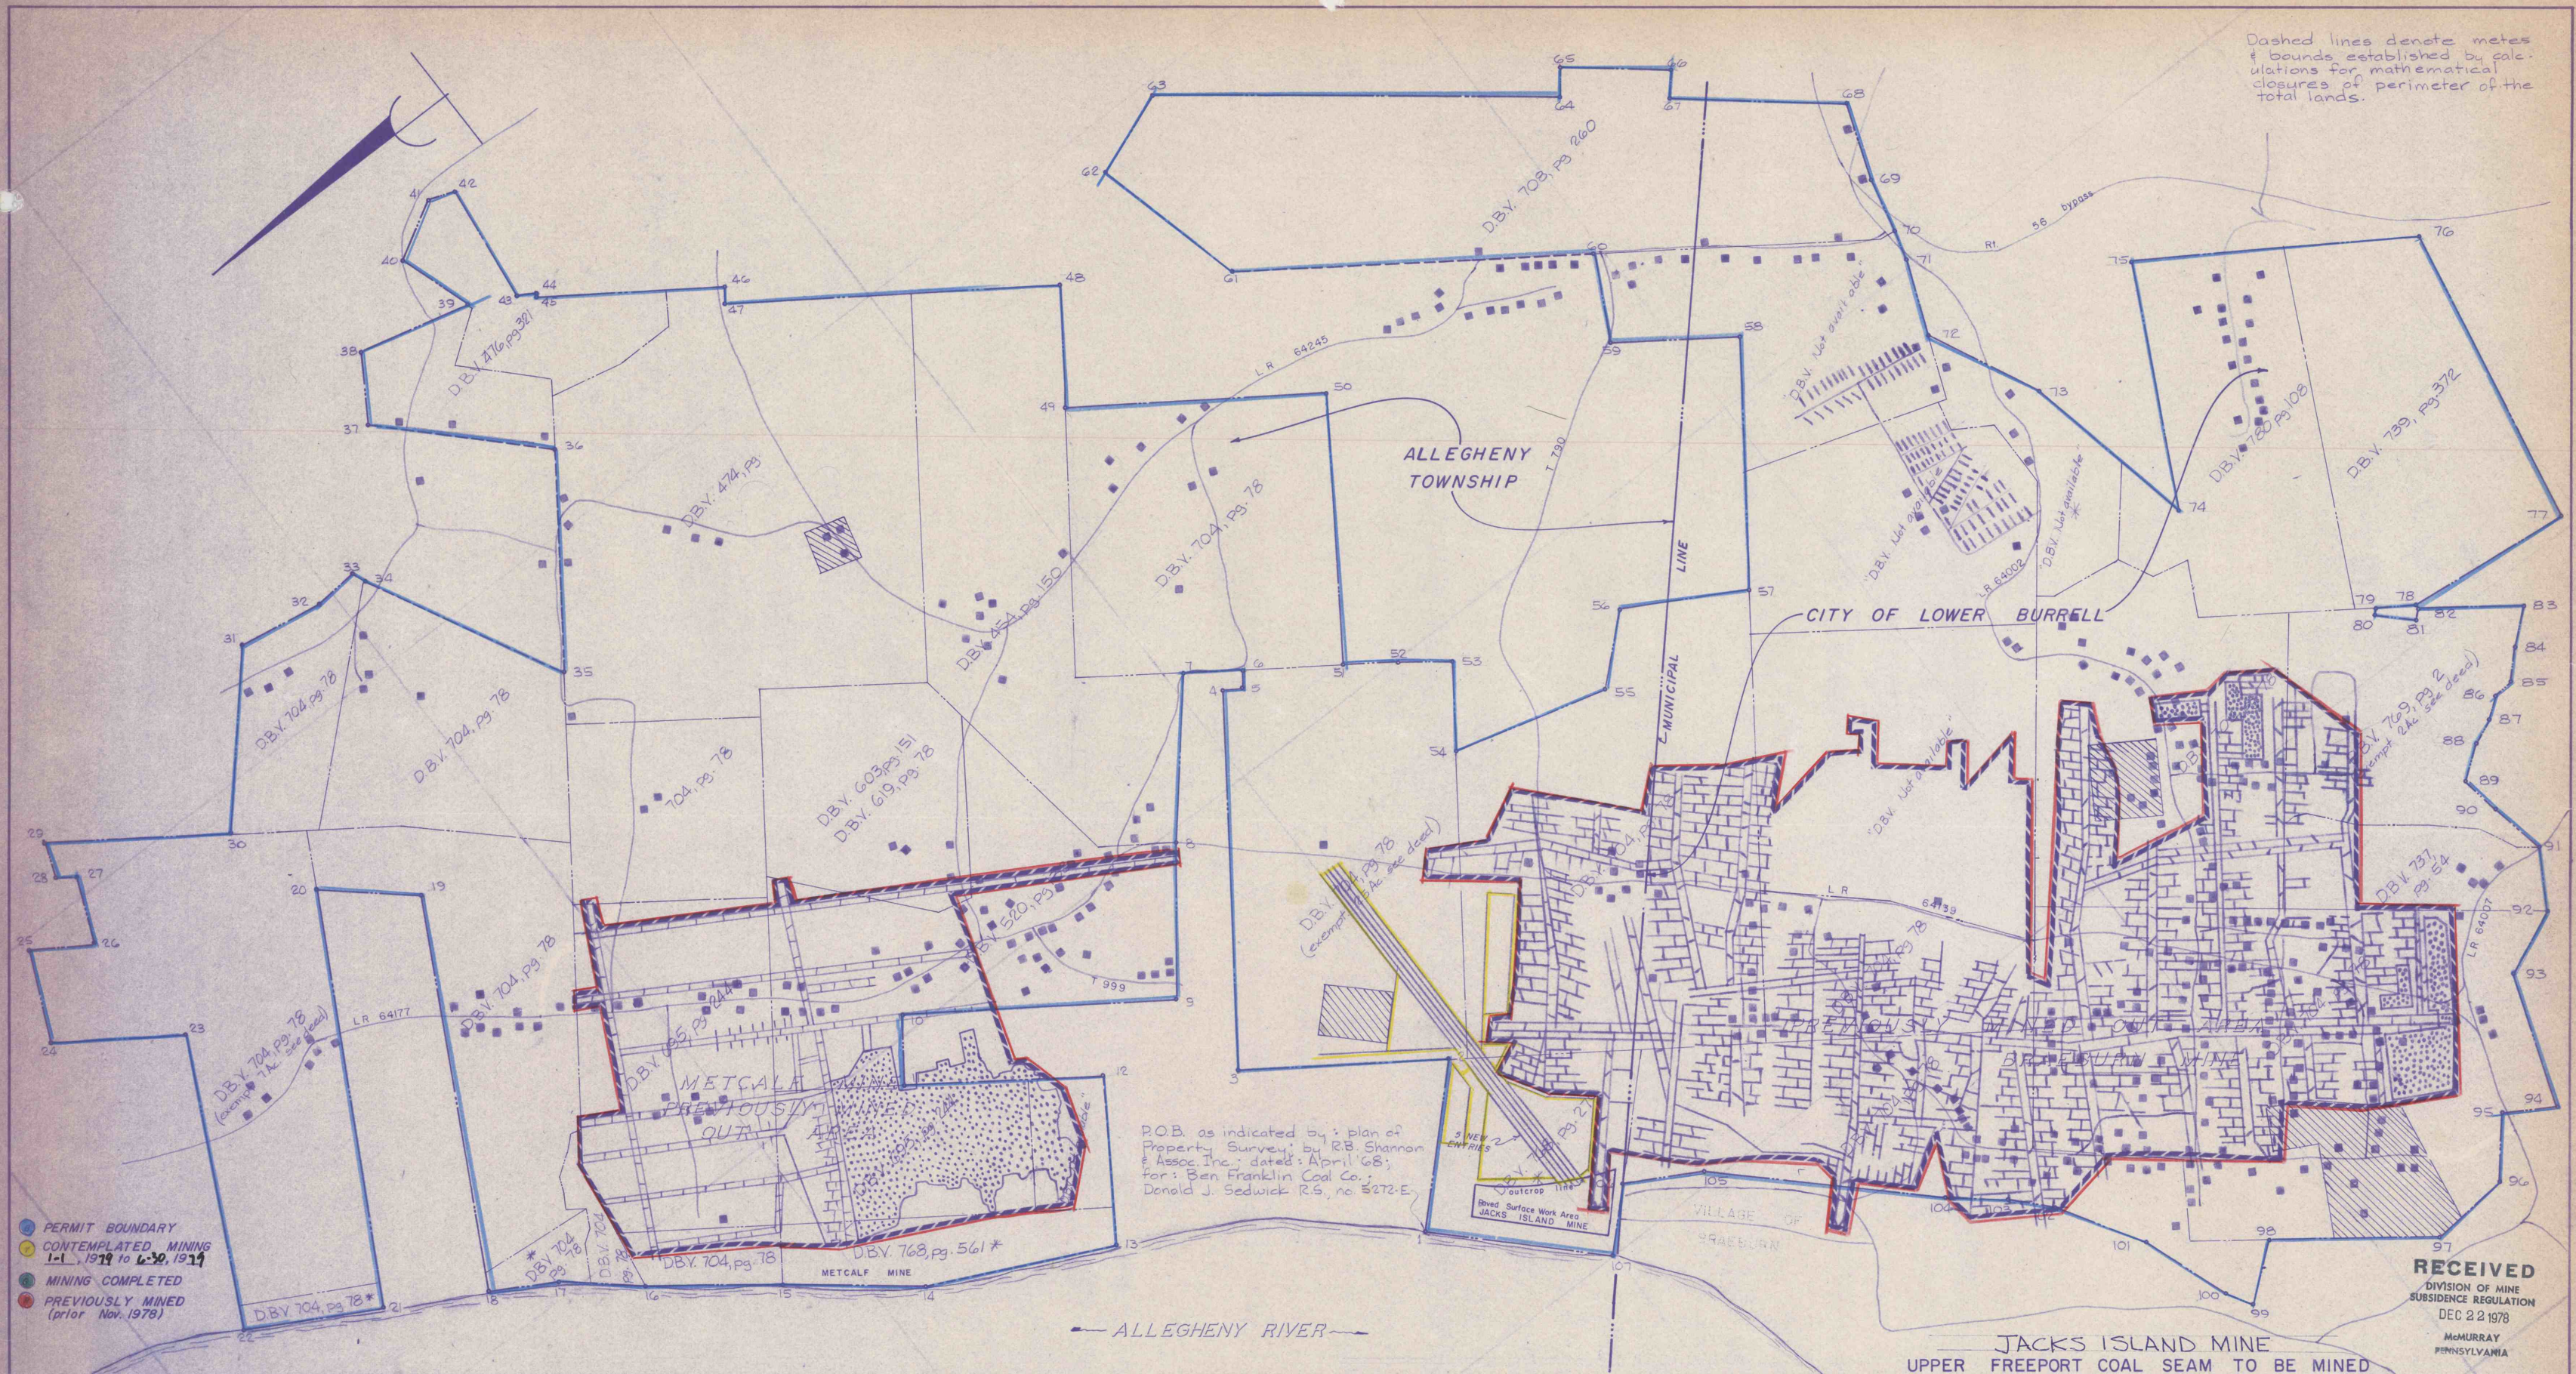

COAL LANDS PERIMETER & EXISTING STRUCTURES

SITUATE IN:
ALLEGHENY TWP & CITY OF LOWER BURELL, WESTMORELAND CO, PENNA.

PREPARED FOR:
BEN FRANKLIN COAL COMPANY, INC.

THE SENATE COMPANY, INC.
 ENGINEERS - PLANNERS - SURVEYORS

1407 MAPLE ST. CHESWICK, PA. 15024

PHONE (412) 274-8771, (412) 361-2368

DRAWN BY	CHECKED BY	DATE	SCALE
E.R.K	W.S.M.	Nov., '78	1" = 600'
JOB NO. 10312 - C		DRAWING NO. B-1096	