


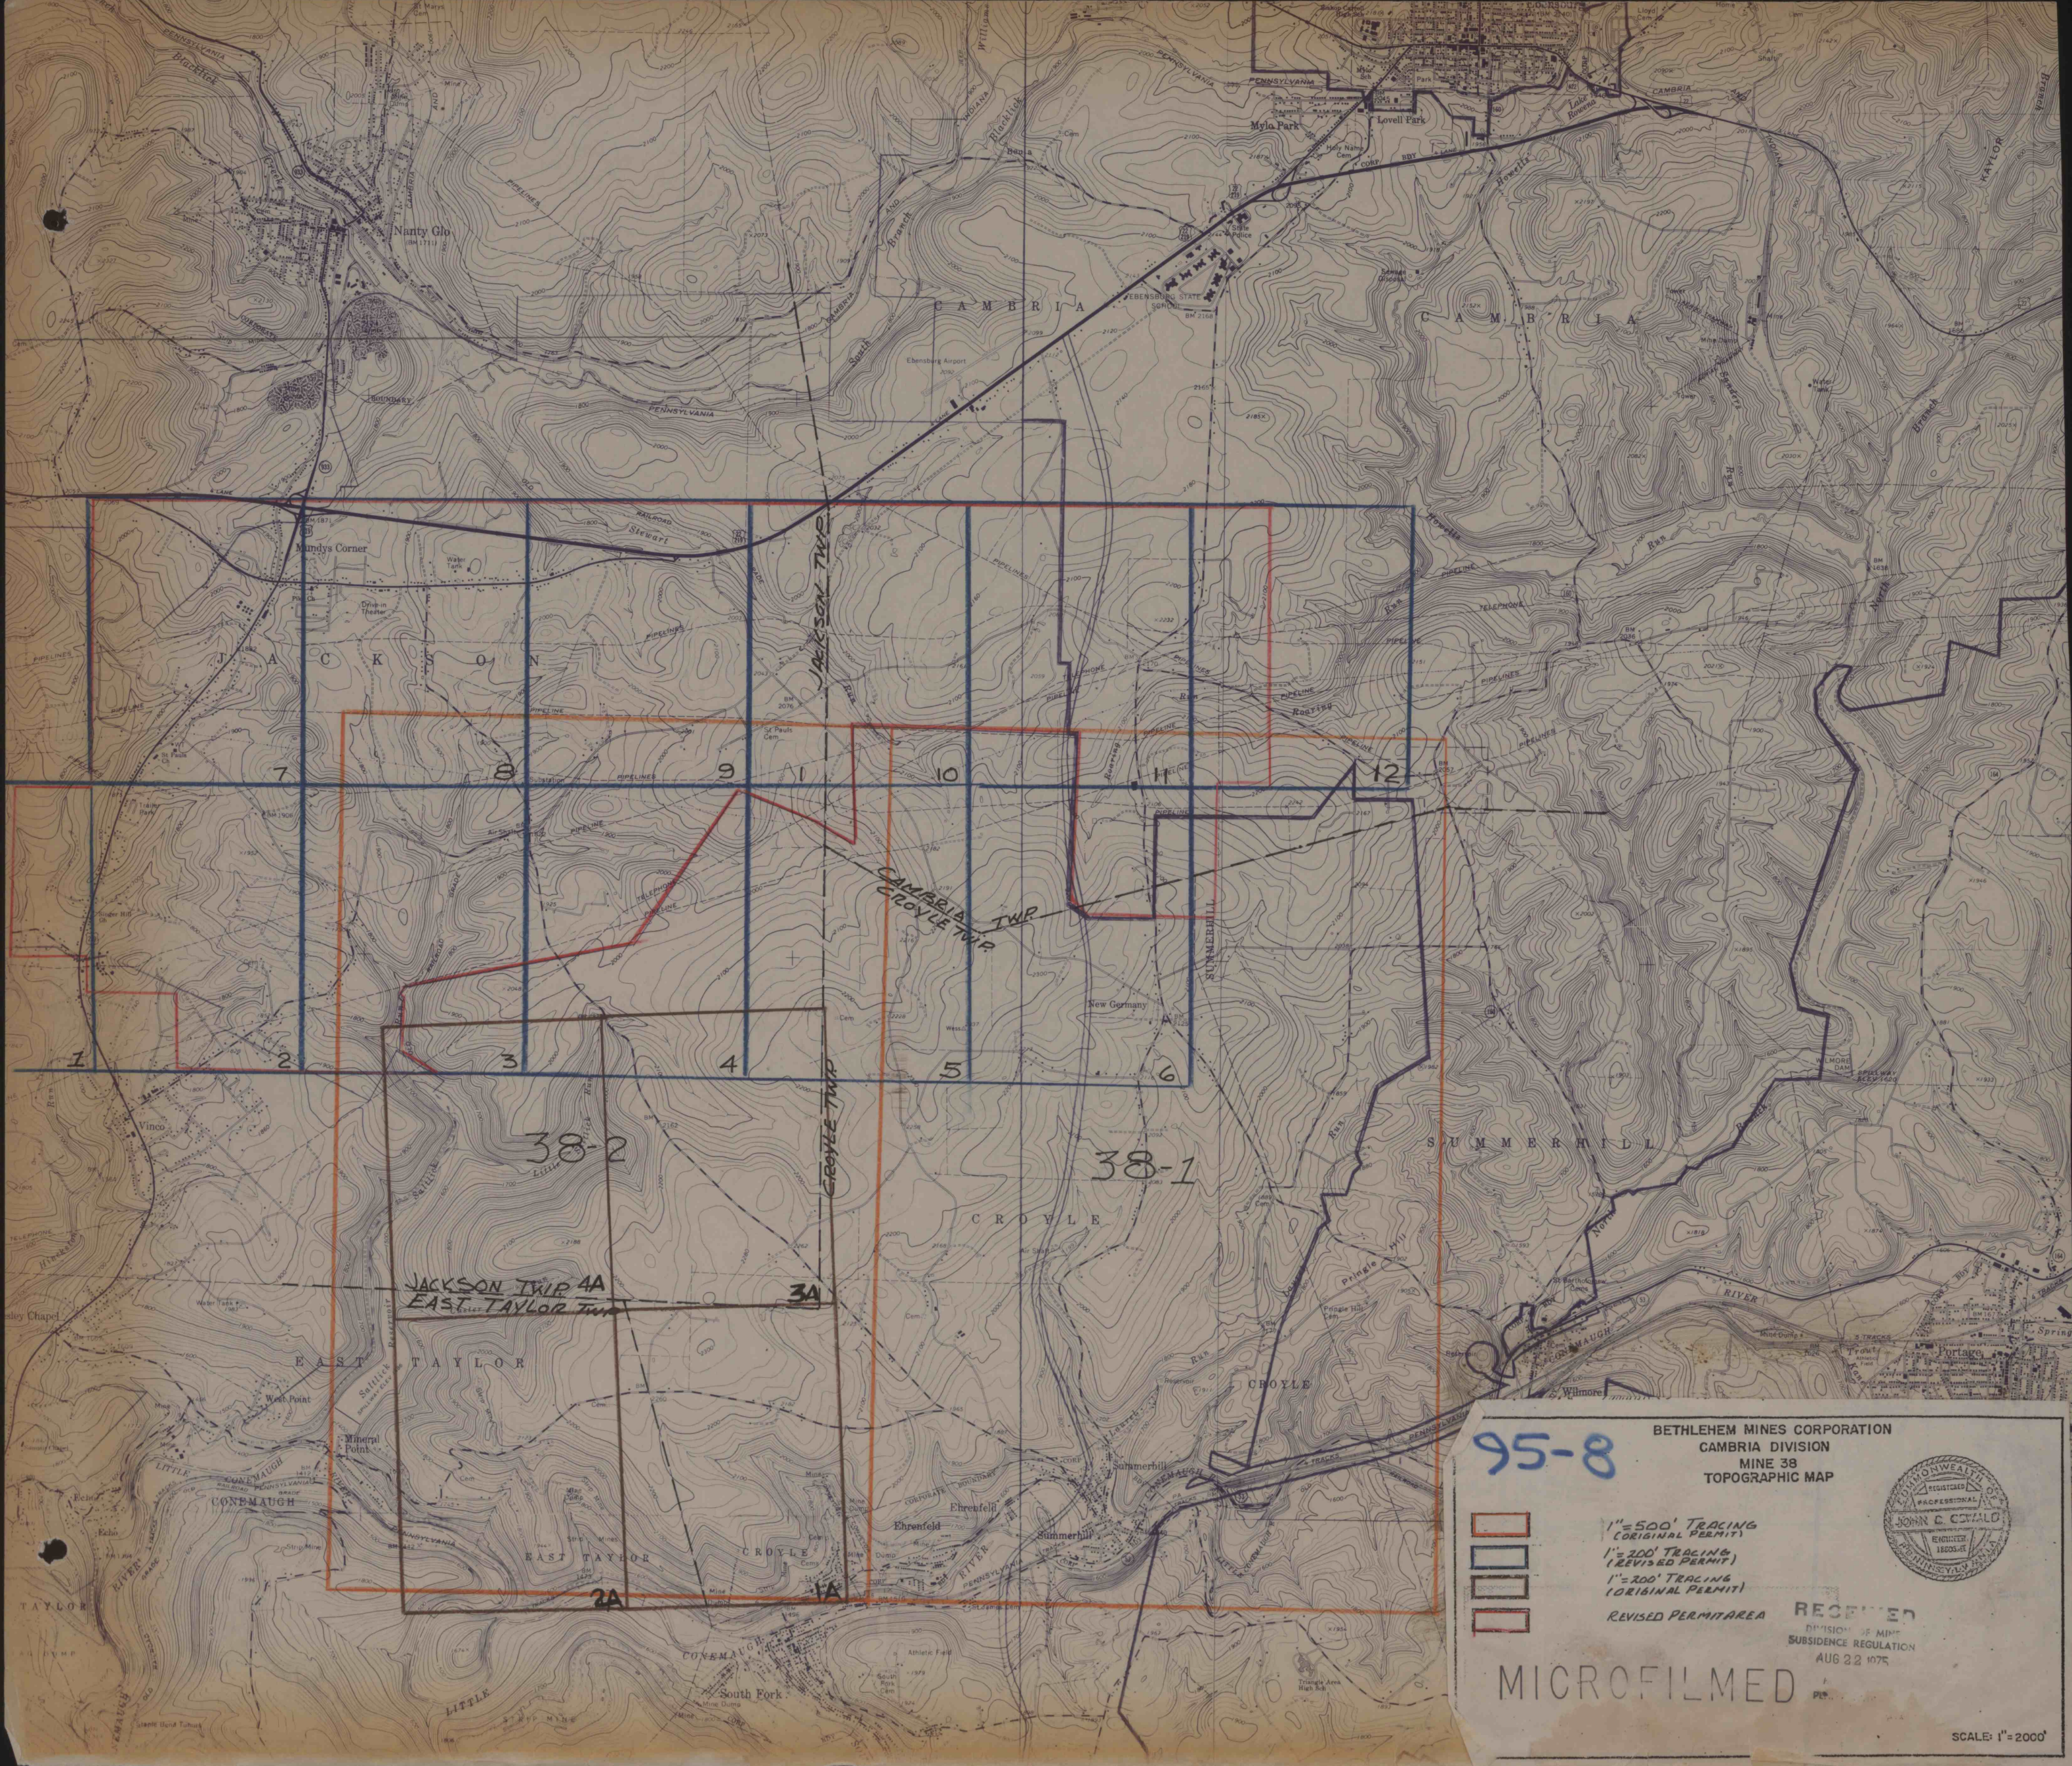

95-8

BETHLEHEM MINES CORPORATION
CAMBRIA DIVISION
MINE 38
TOPOGRAPHIC MAP

1"=500' TRACING (ORIGINAL PERMIT)
1"=200' TRACING (REVISED PERMIT)
1"=200' TRACING (ORIGINAL PERMIT)

REVISED PERMIT AREA

RECEIVED
DIVISION OF MINE
SUBSIDENCE REGULATION
AUG 22 1975

MICROFILMED

SCALE: 1"=2000'