


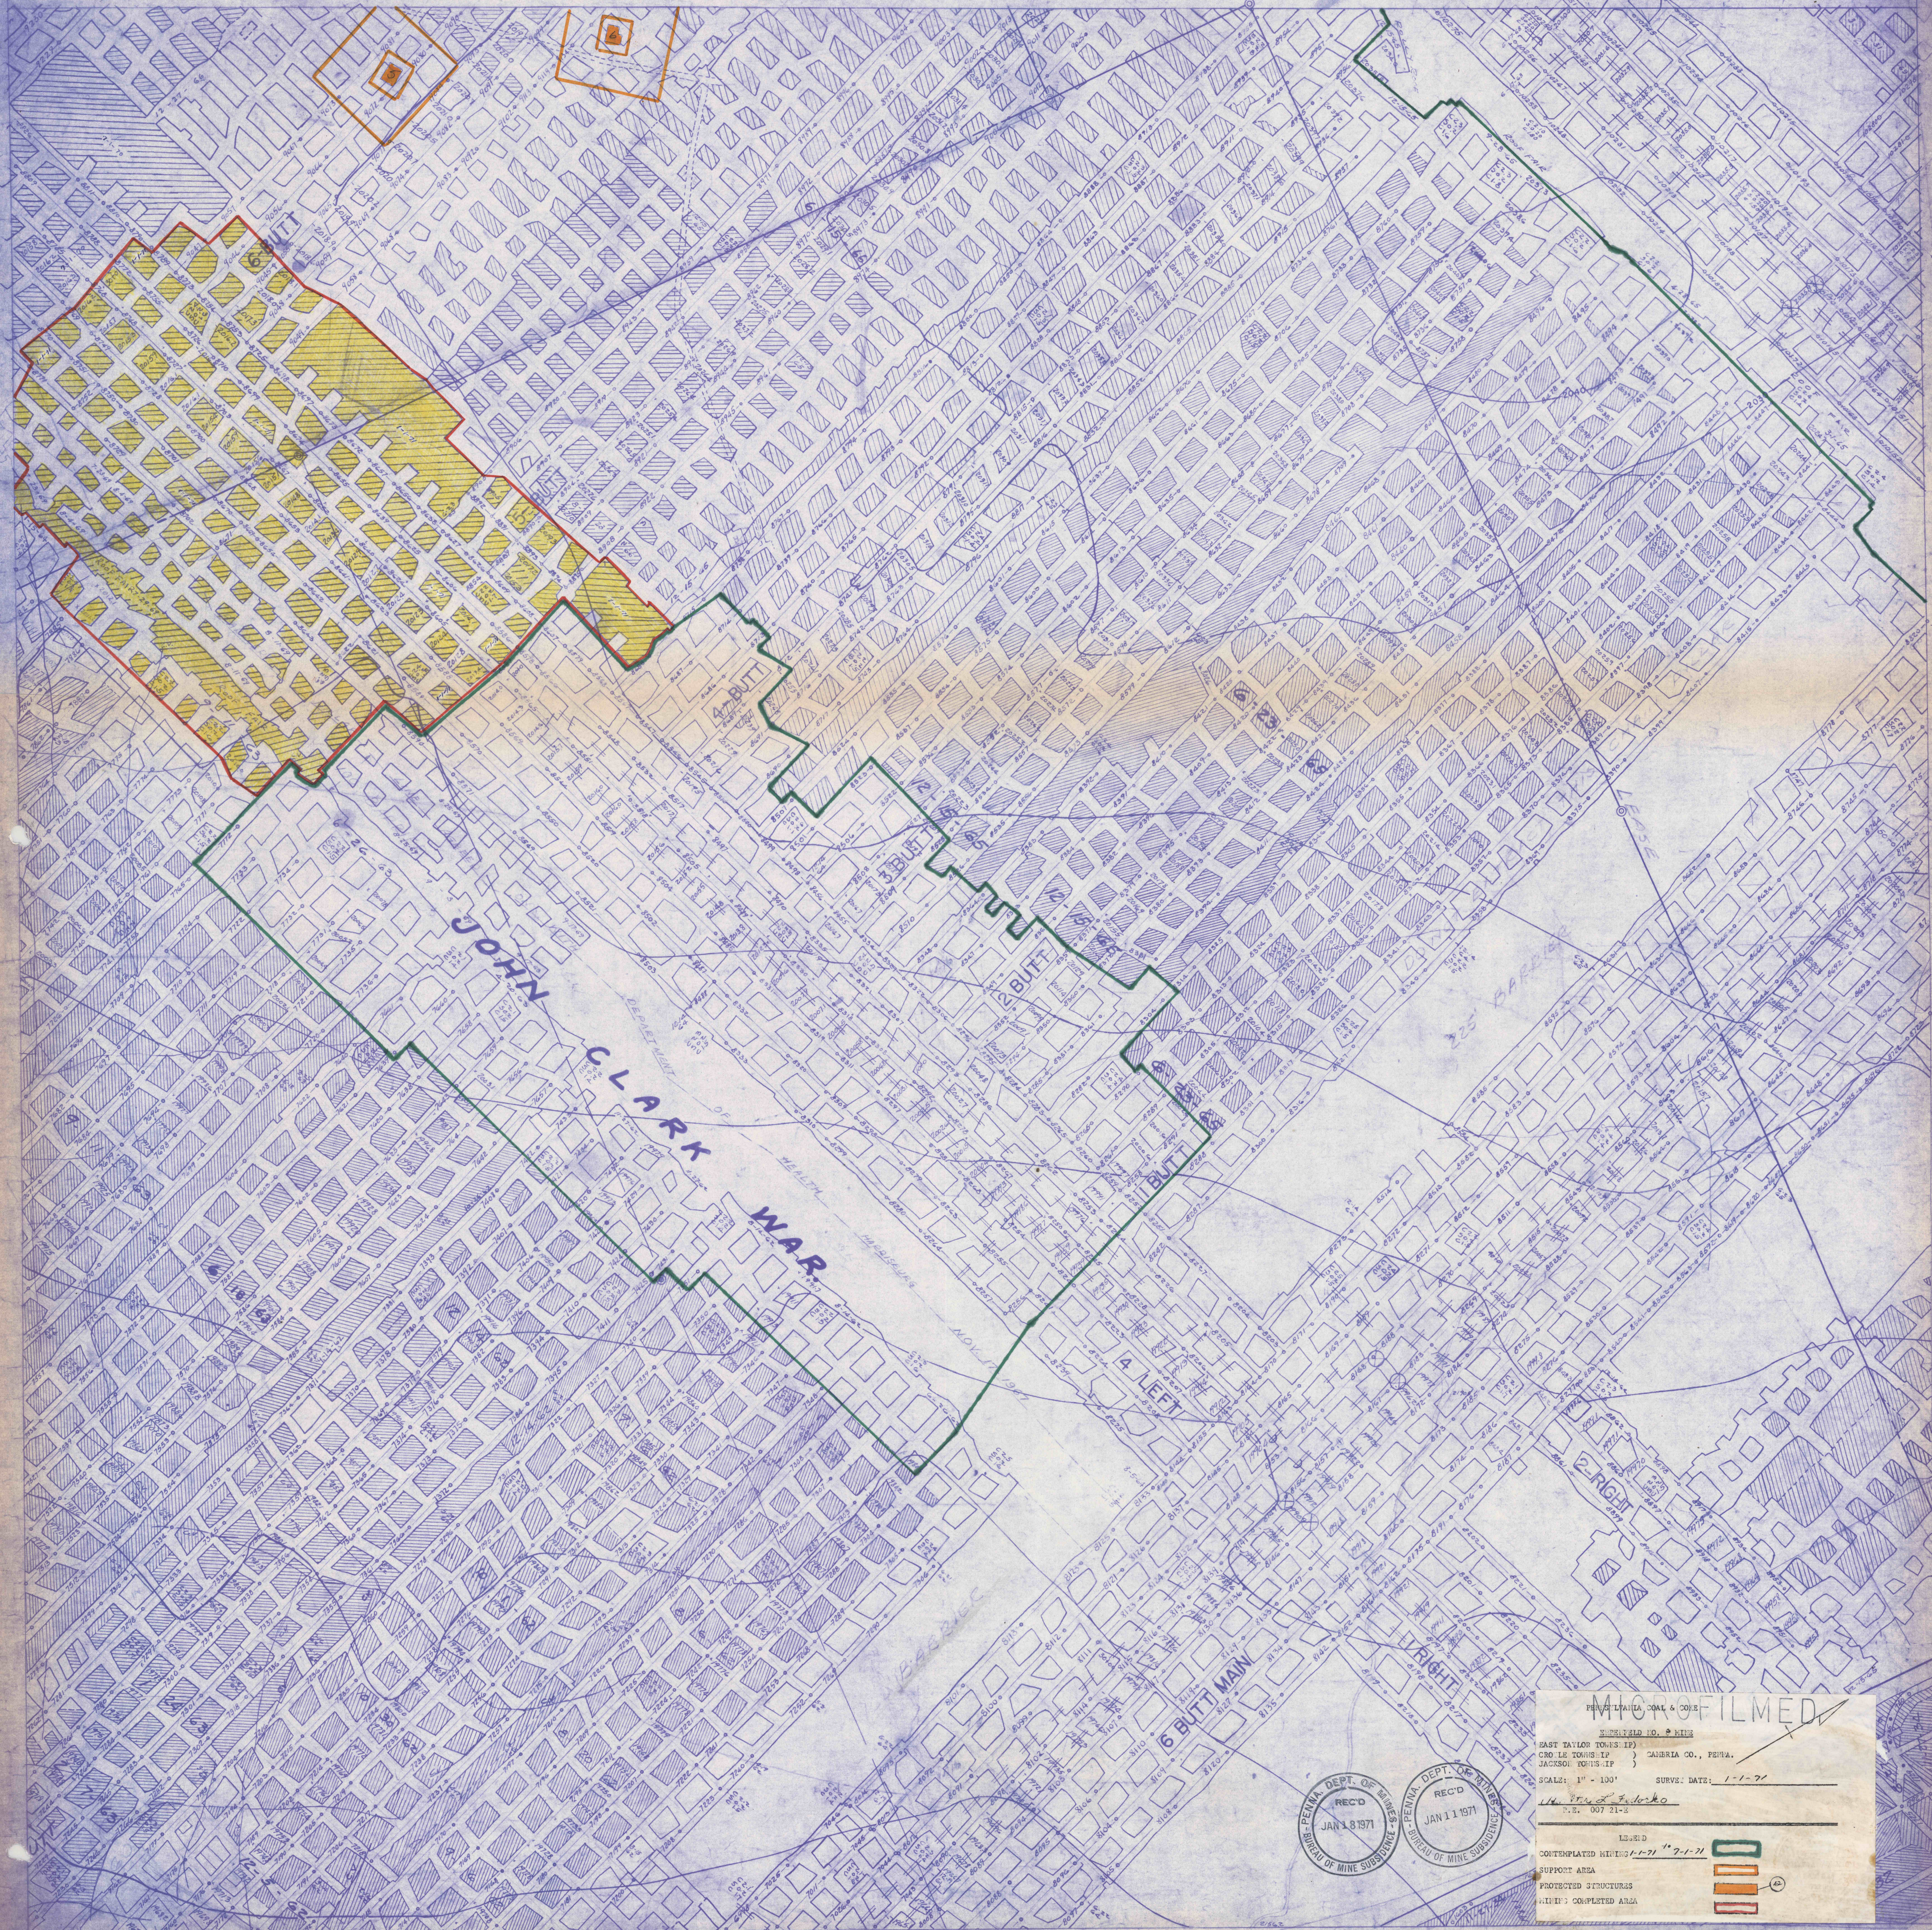

RECD
JAN 18 1971
PENNA. DEPT. OF MINES
BUREAU OF MINE SUPERVISOR

RECD
JAN 11 1971
PENNA. DEPT. OF MINES
BUREAU OF MINE SUPERVISOR

MAILED
SUPERVISOR TO MINE
EAST TAYLOR TOWNSHIP } CALHRIA CO., PENNA.
CROLE TOWNSHIP }
JACKSON TOWNSHIP }
SCALE: 1" = 100' SURVEY DATE: 1-1-71
114. 874.2 8.10.10
P.E. 007 21-2
LEGEND
CONTINGENT MINING 1-1-71 1-7-71
SUPPORT AREA
PROTECTED STRUCTURES
MINE'S COMPLETED AREA