


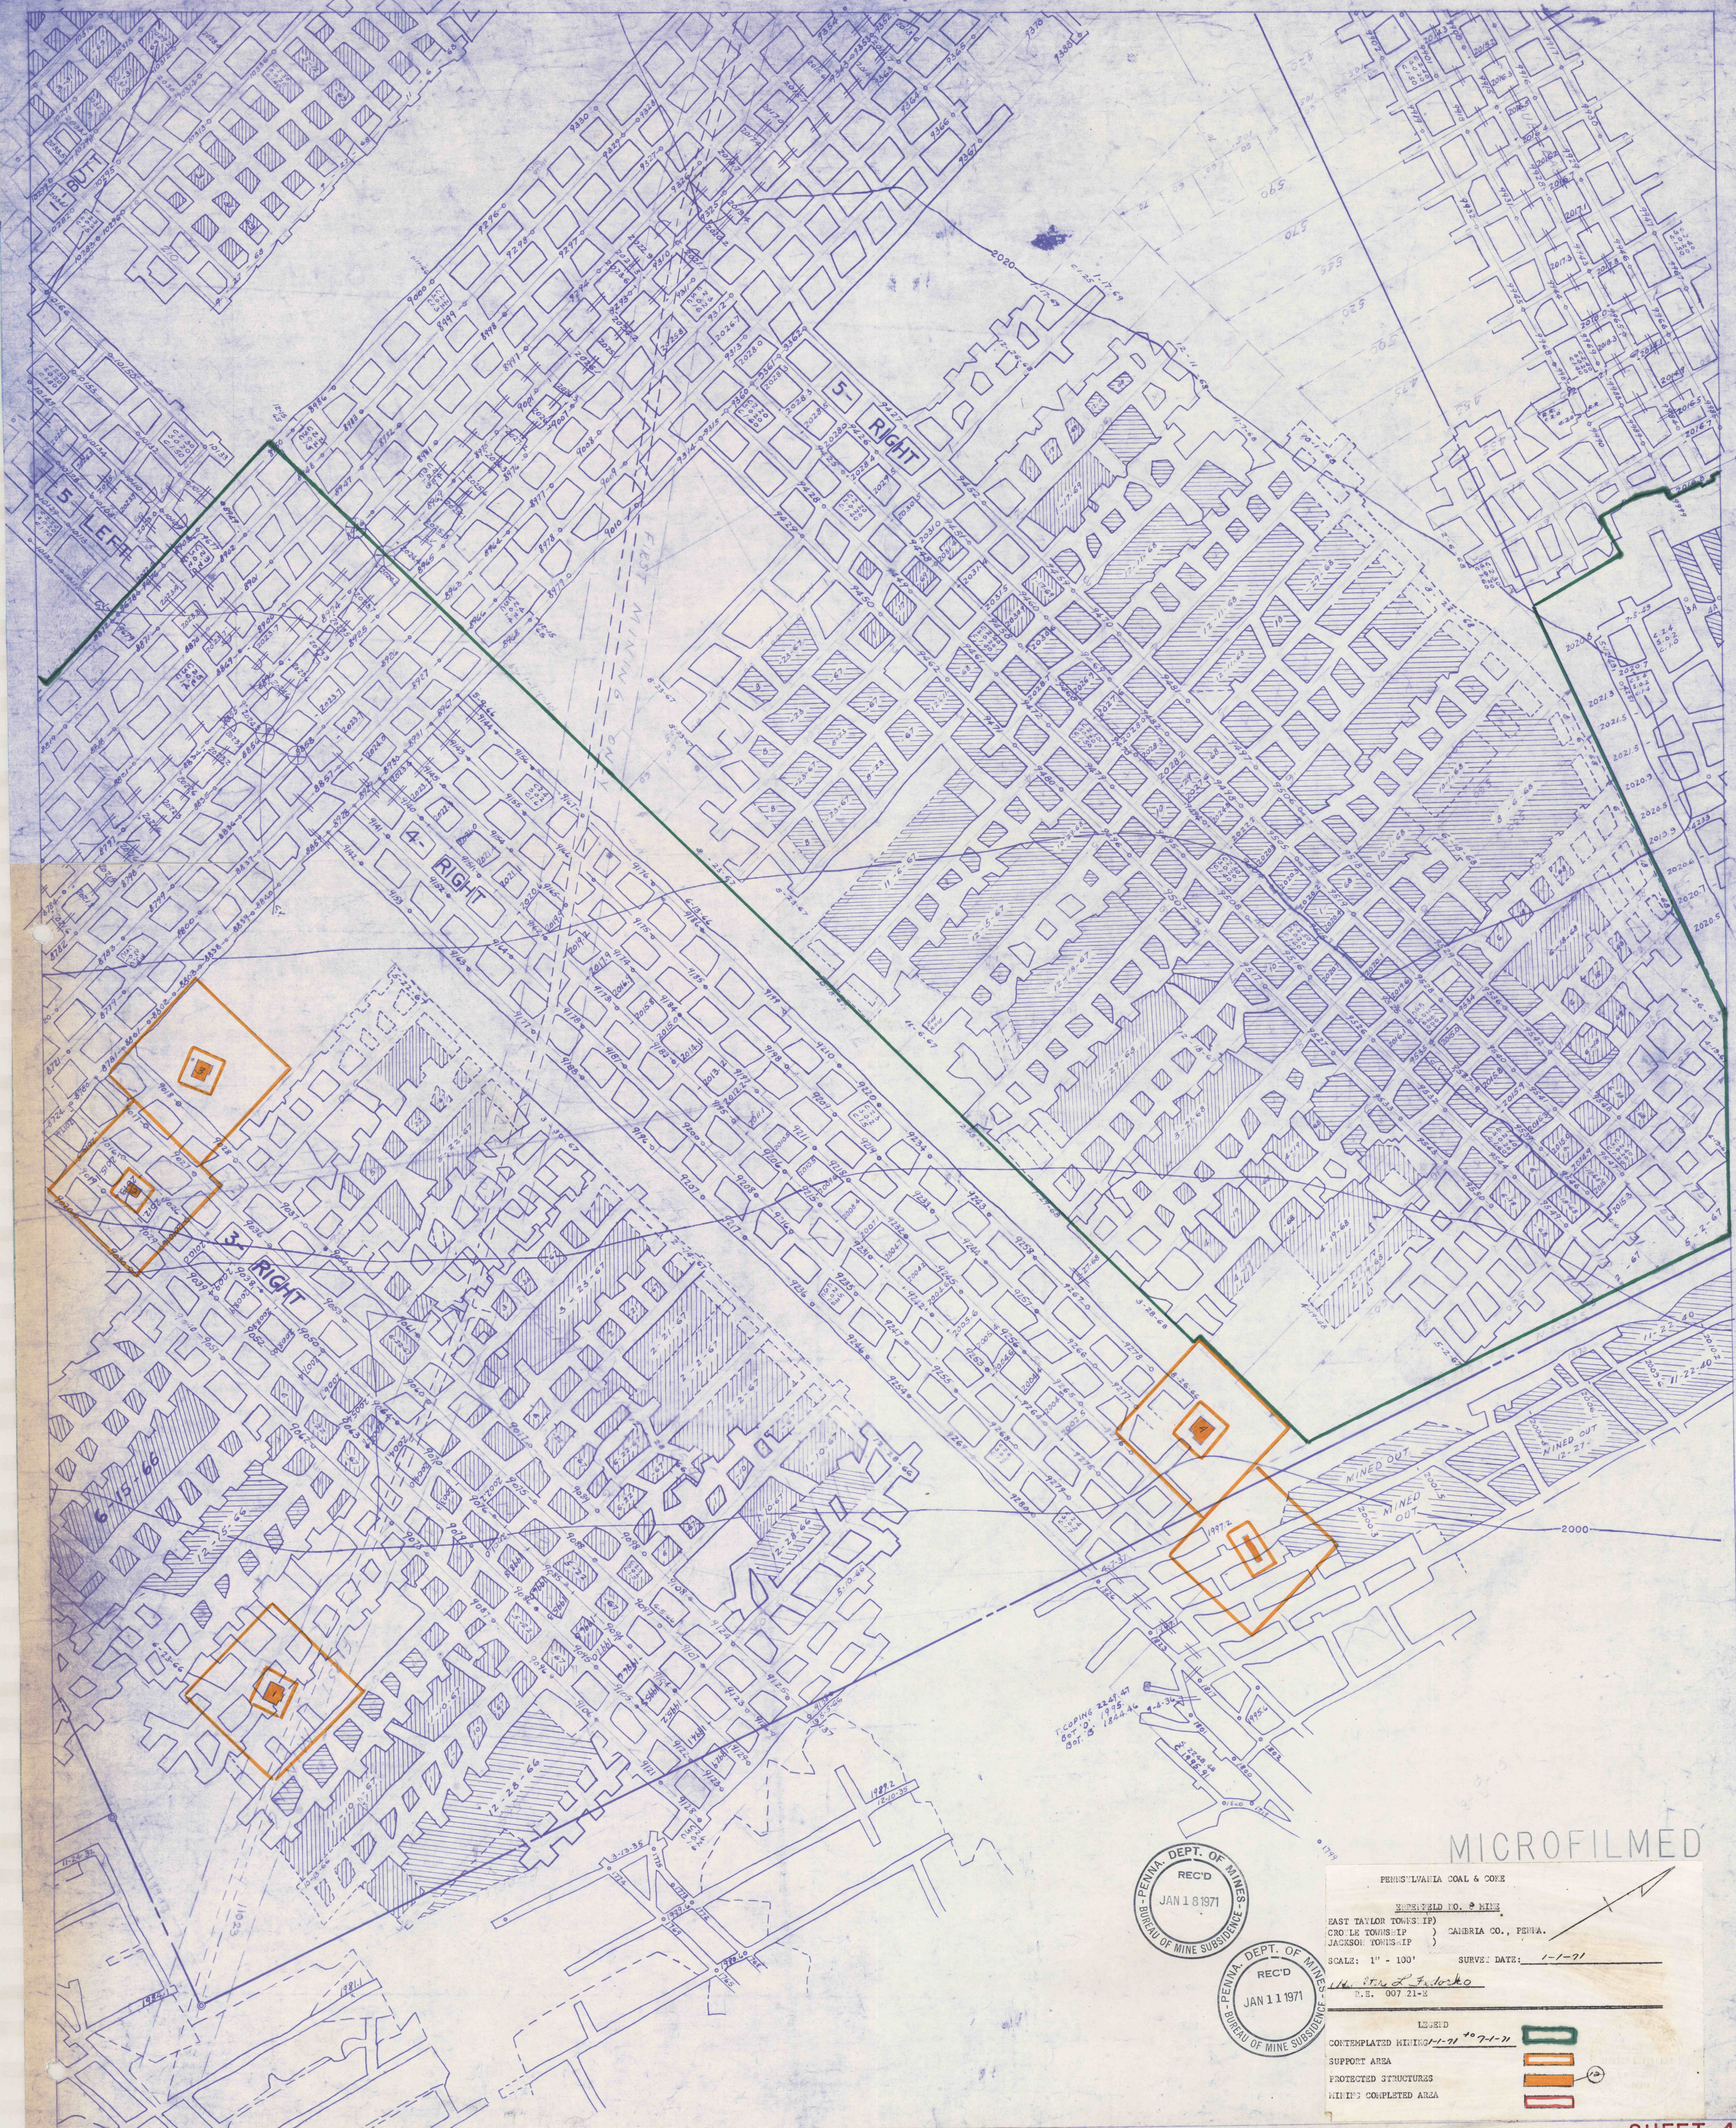

REC'D
JAN 18 1971
PENNS. DEPT. OF MINES
BUREAU OF MINE SUBSIDENCE

REC'D
JAN 11 1971
PENNS. DEPT. OF MINES
BUREAU OF MINE SUBSIDENCE

MICROFILMED

PENNSYLVANIA COAL & COKE
SHEPHERD NO. 2 MINE
EAST TAYLOR TOWNSHIP } CAMBERIA CO., PENNA.
CRO'LE TOWNSHIP }
JACKSON TOWNSHIP }

SCALE: 1" = 100' SURVEY DATE: 1-1-71
H. Street, Jackson
P.E. 007 21-2

LEGEND
CONTEMPLATED MINING 1-1-71 to 7-1-71
SUPPORT AREA
PROTECTED STRUCTURES
MINING COMPLETED AREA