


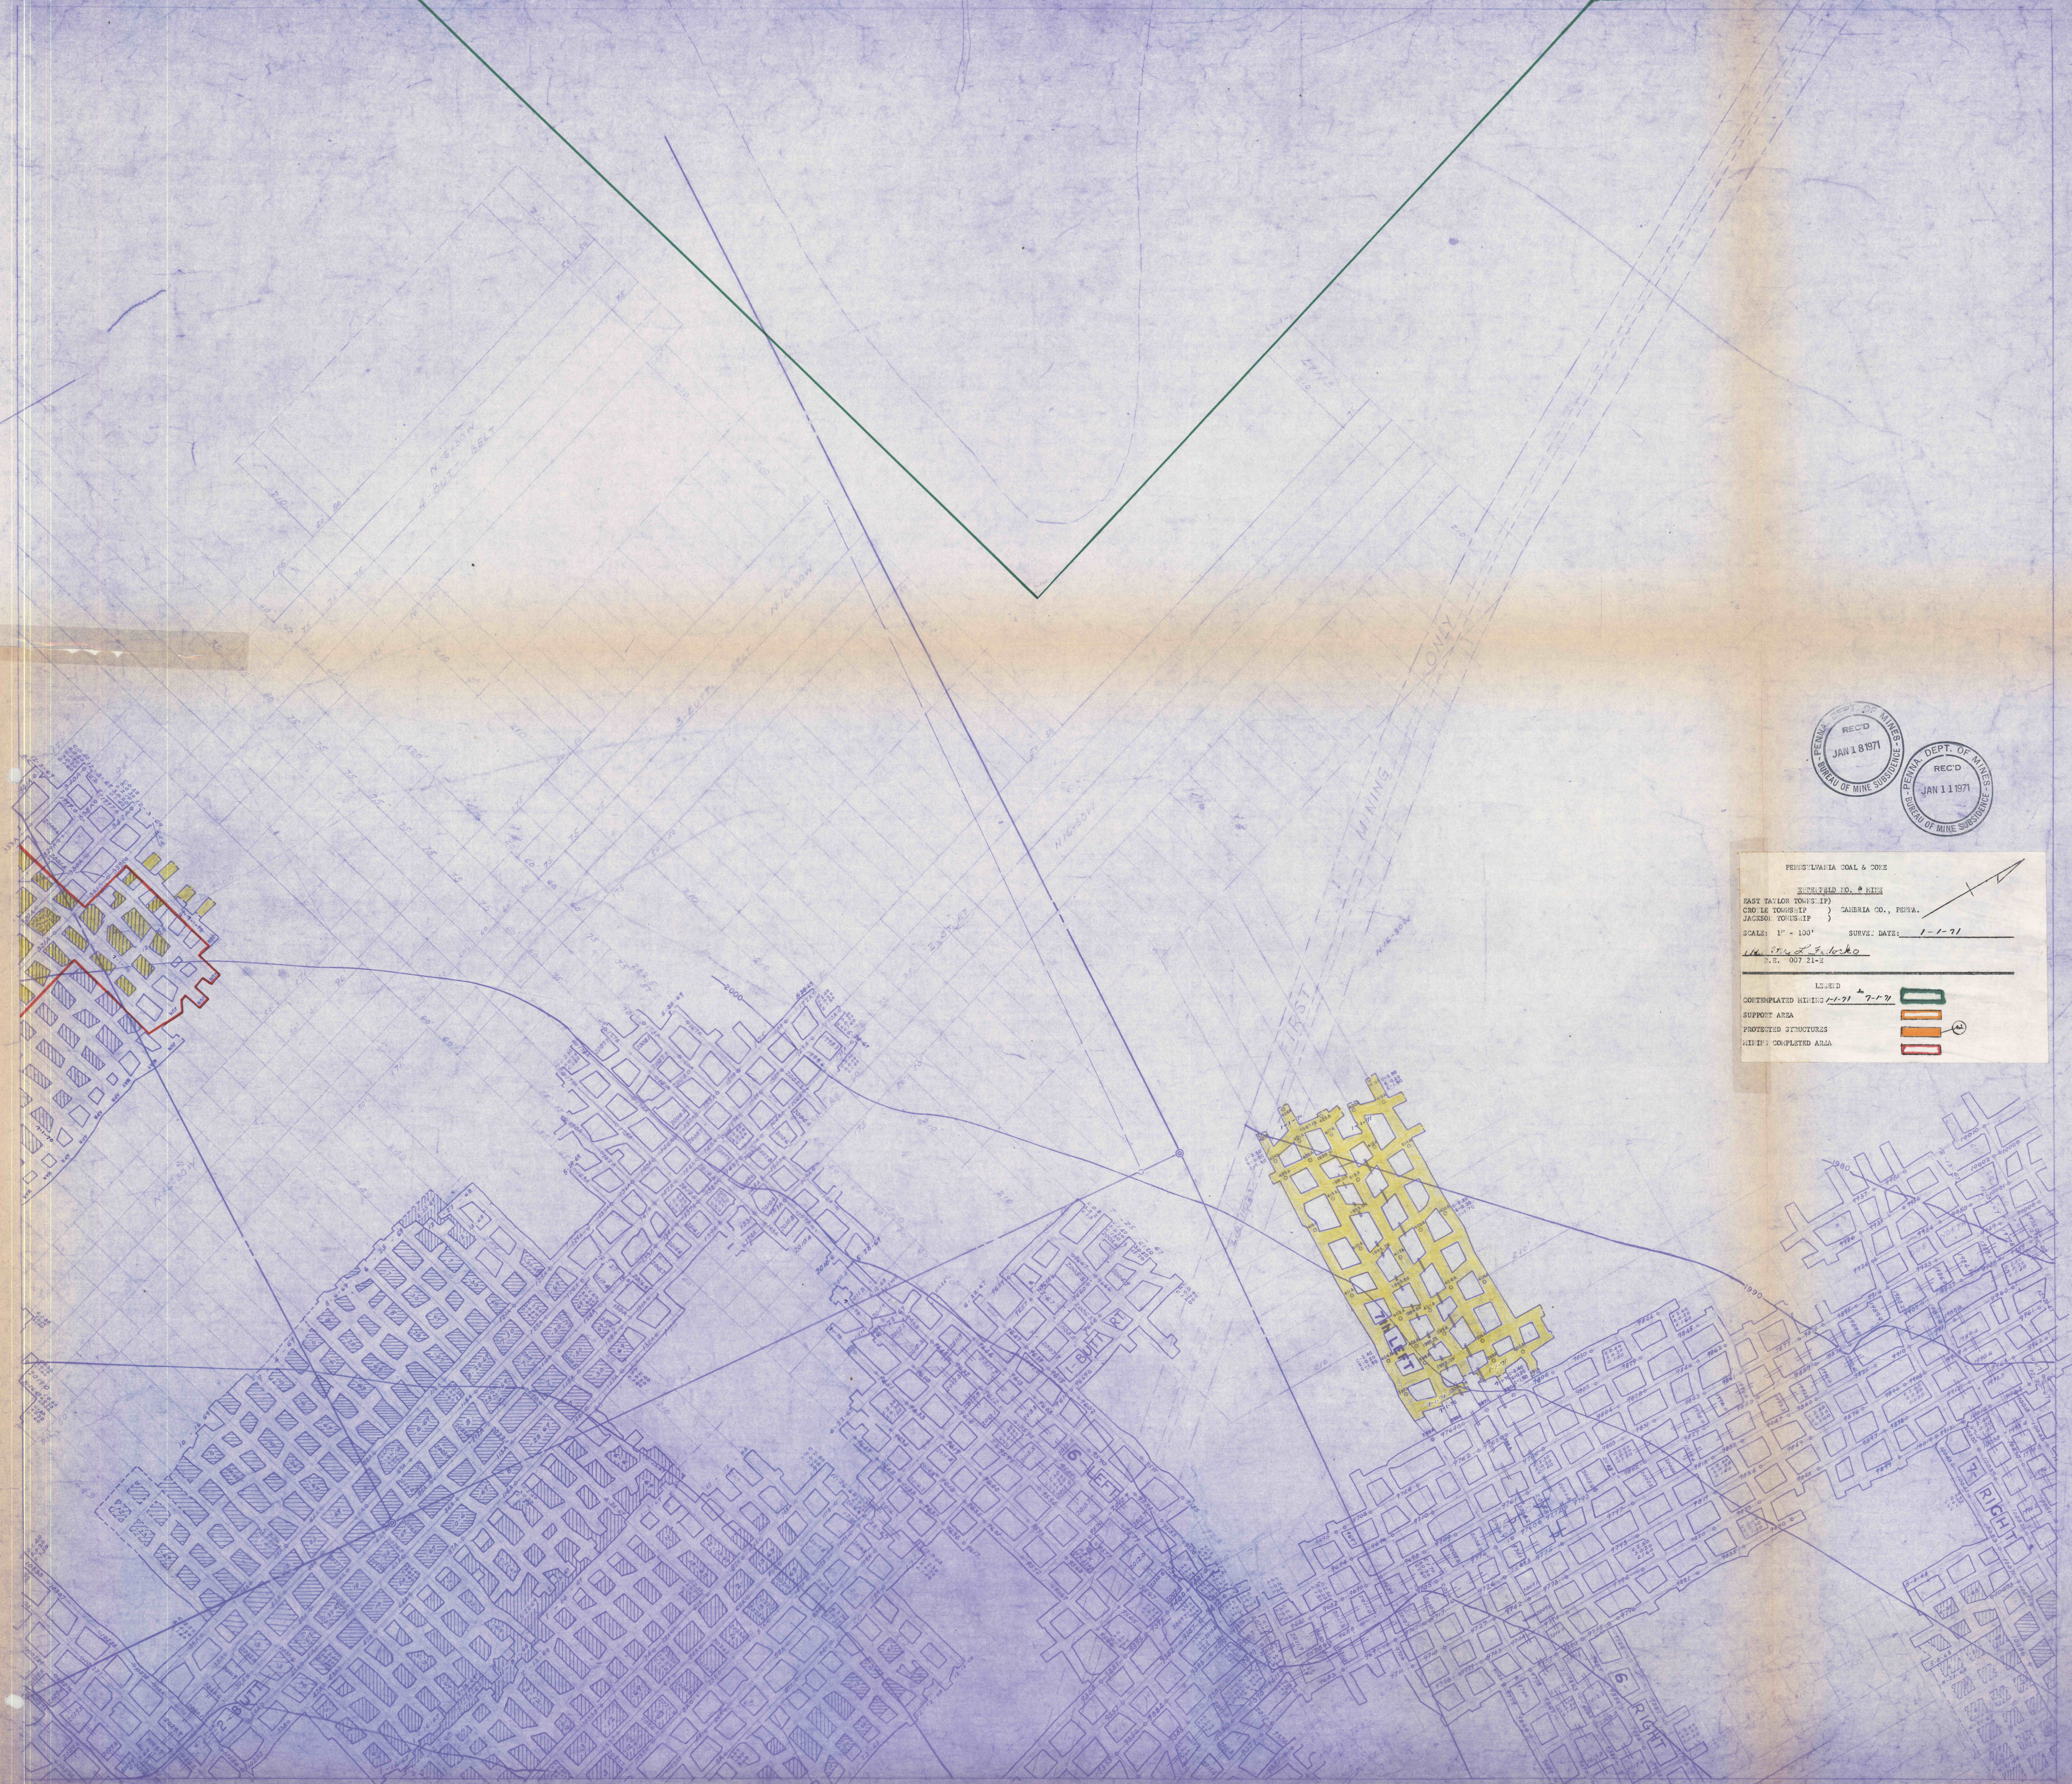

PENNSYLVANIA COAL & COKE
SHEPHERD CO. 8 MINE
EAST TAYLOR TOWNSHIP } CAMERIA CO., PENNA.
CROOK TOWNSHIP }
JACKSON TOWNSHIP }
SCALE: 1" = 100' SURVEY DATE: 1-1-71
W. R. 21-2
D.E. 007 21-2

LEGEND
CONTEMPLATED MINING 1-1-71 7-1-71
SUPPORT AREA
PROTECTED STRUCTURES
MINING COMPLETED AREA