


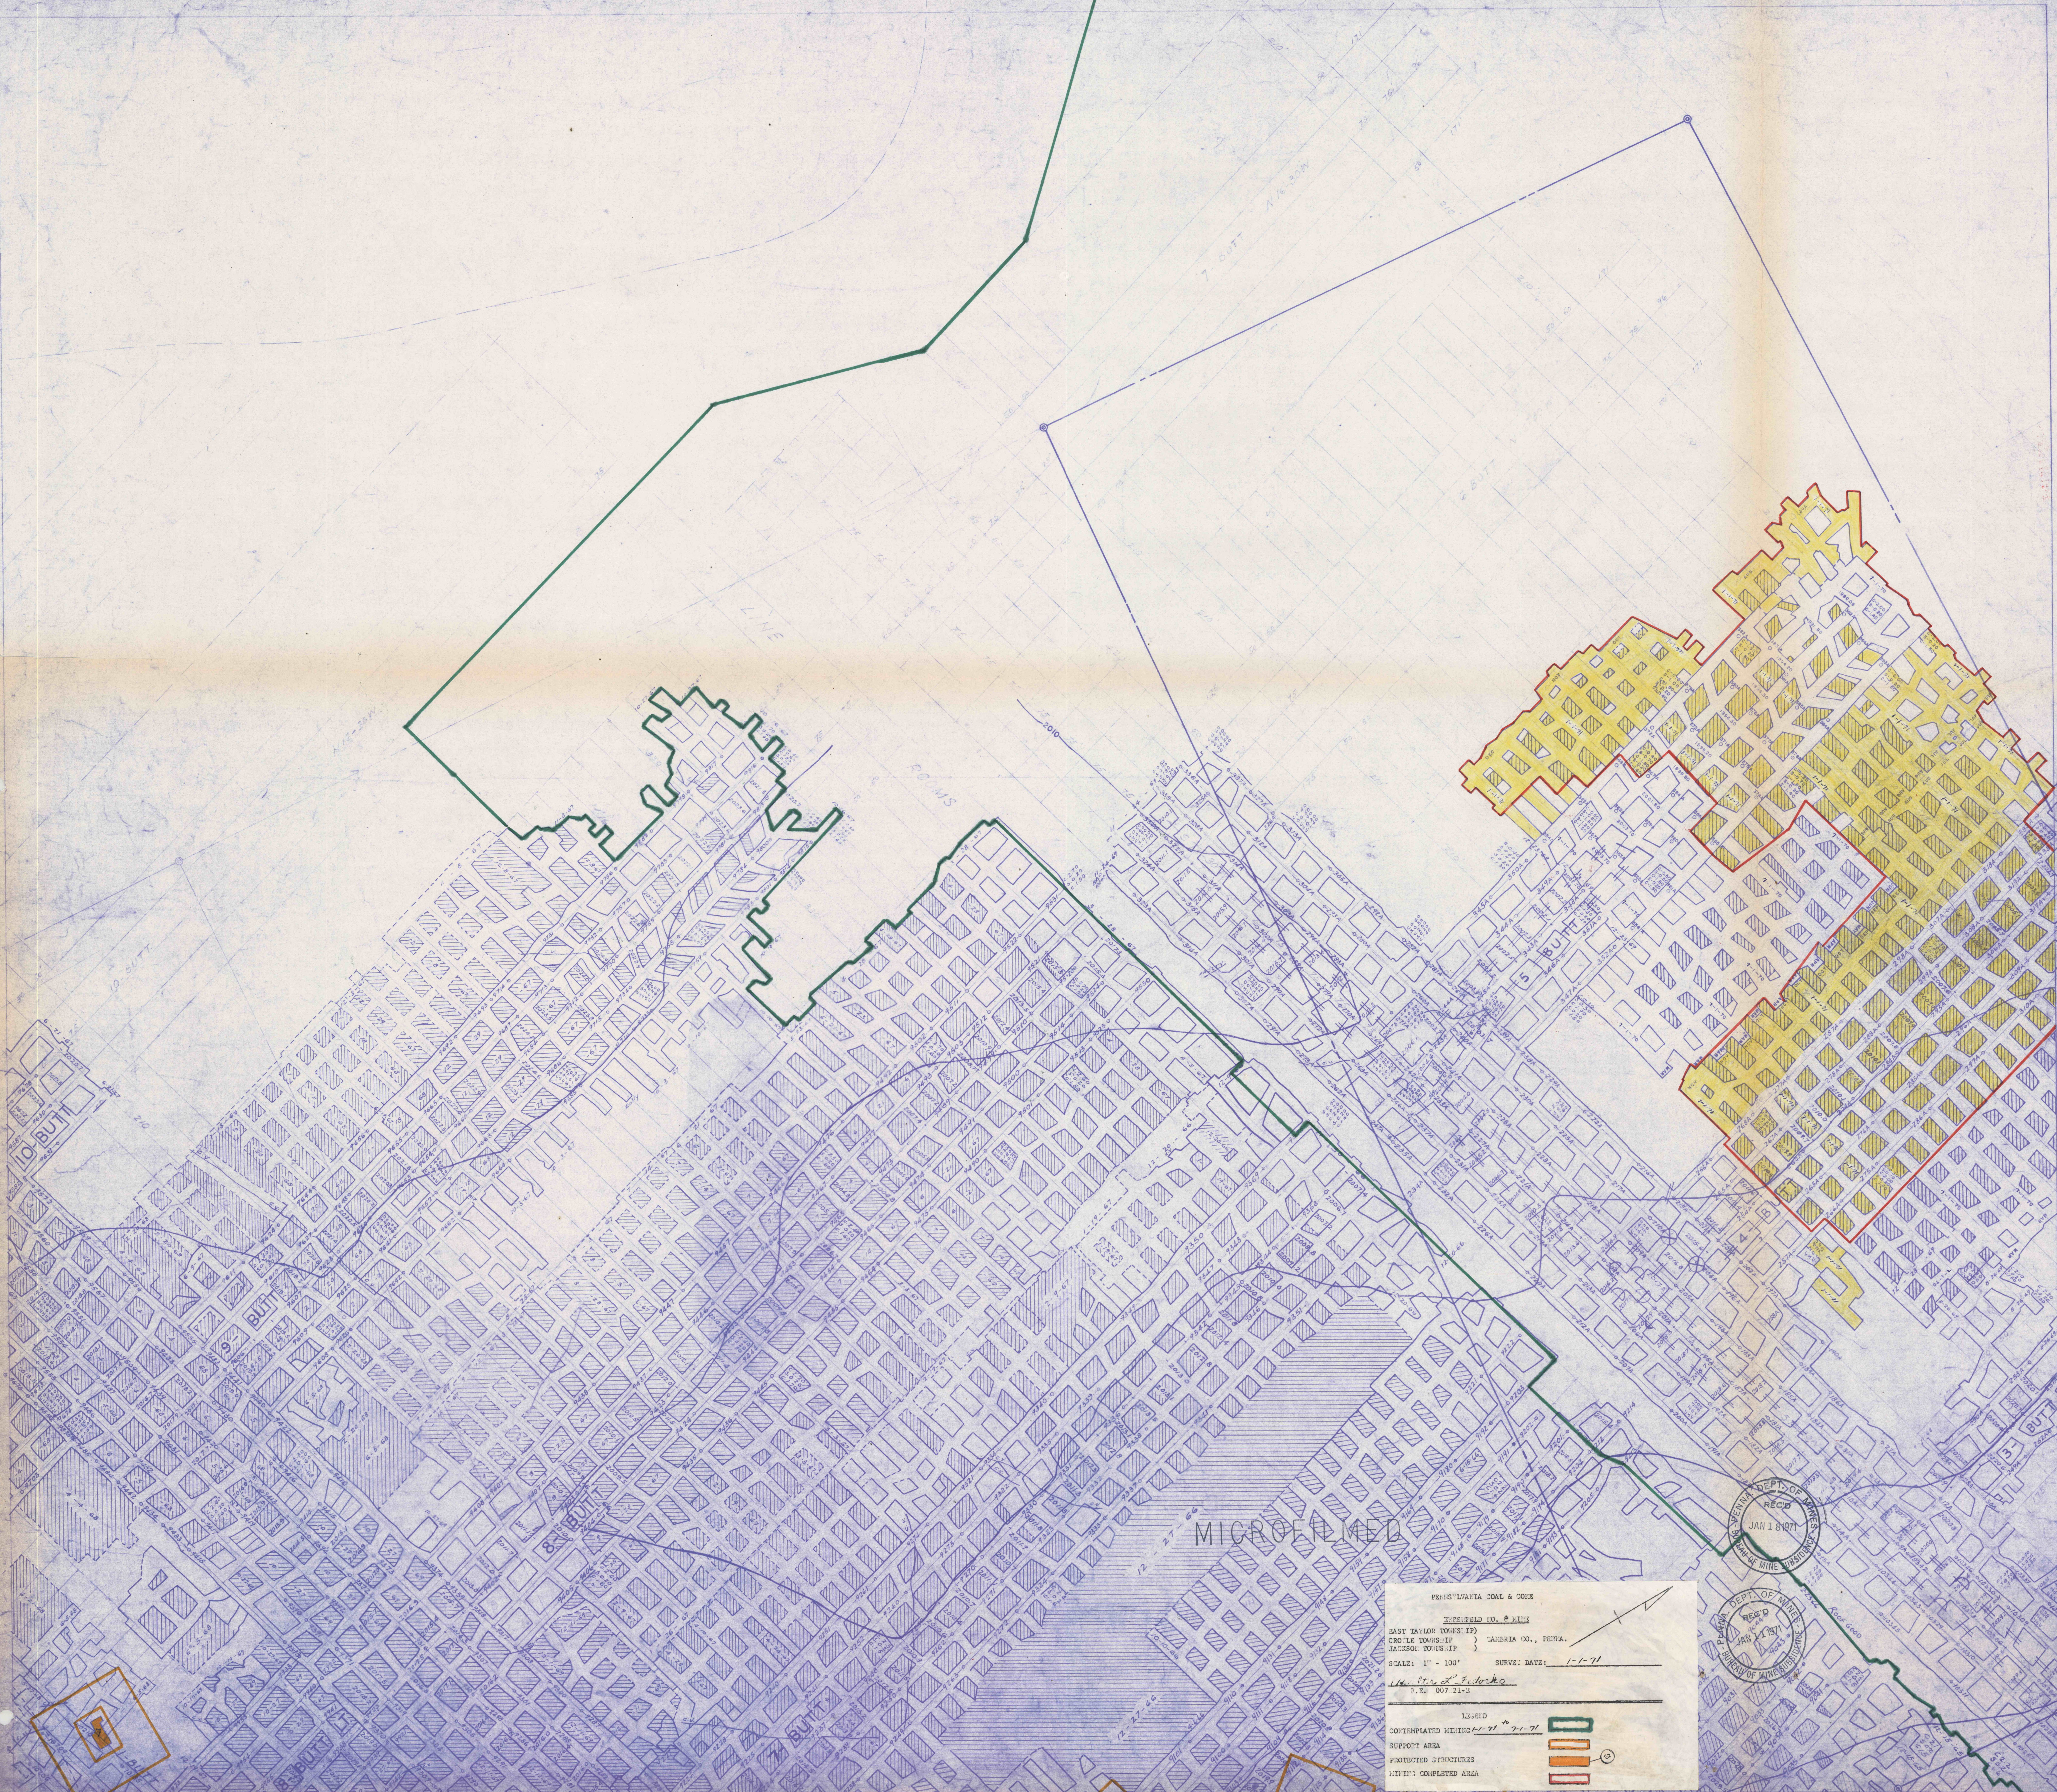

MICROFILMED

PENNSYLVANIA COAL & COKE
SUNBURD TOWNSHIP
EAST TAYLOR TOWNSHIP } CAMBRIA CO., PENNA.
CROYLE TOWNSHIP }
JACKSON TOWNSHIP }
SCALE: 1" = 100' SURVEY DATE: 1-1-71
P. O. BOX 21-2

LEGEND
CONTEMPLATED MINING 1-1-71 7-1-71
SUPPORT AREA
PROTECTED STRUCTURES
MINING COMPLETED AREA

REC'D
JAN 18 1971
DEPT. OF MINE INDUSTRY

REC'D
JAN 18 1971
DEPT. OF MINE INDUSTRY