


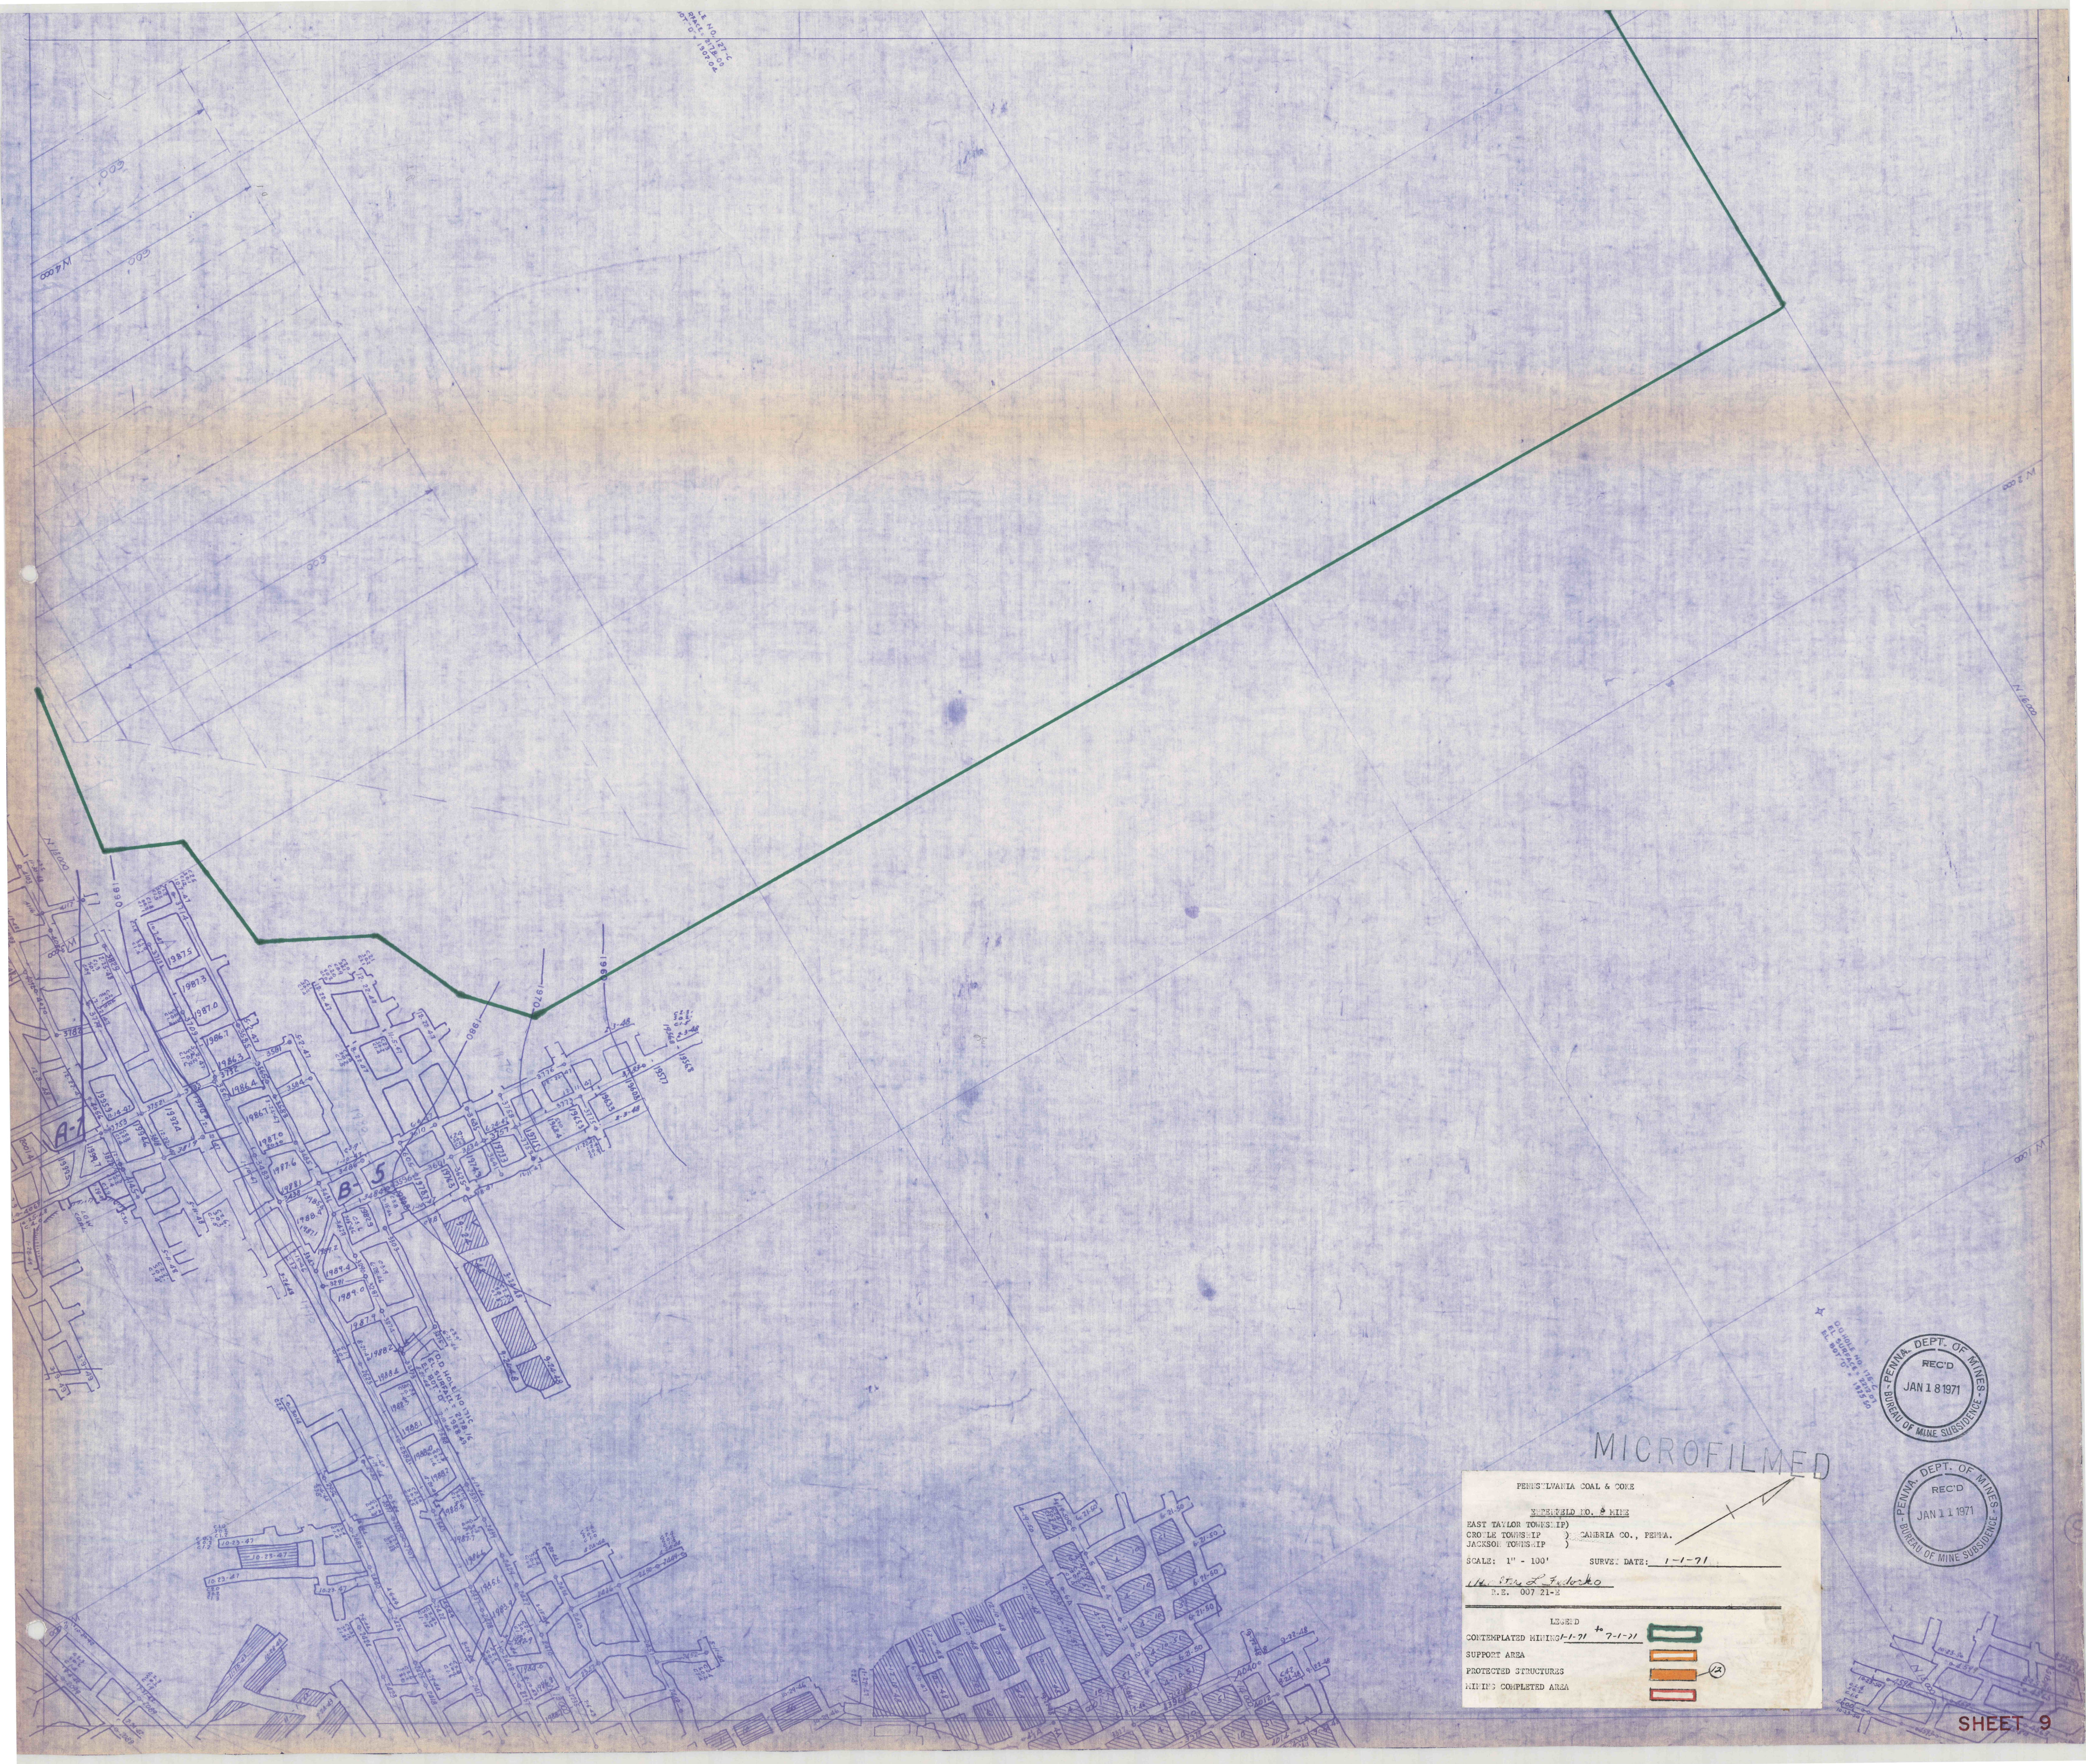

MICROFILMED

PENNSYLVANIA COAL & COKE
WESTFIELD NO. 8 MINE
CROYLE TOWNSHIP }
JACKSON TOWNSHIP }
SCALE: 1" = 100' SURVEY DATE: 1-1-71
114. 844 2 2 10 10
P.E. 007 21-E

LEGEND
CONTEMPLATED MINING 1-1-71 * 7-1-71
SUPPORT AREA
PROTECTED STRUCTURES
MINING COMPLETED AREA

114. 844 2 2 10 10

RECD
JAN 18 1971
BUREAU OF MINE SURVEILLANCE
PENNA. DEPT. OF MINES

RECD
JAN 11 1971
BUREAU OF MINE SURVEILLANCE
PENNA. DEPT. OF MINES