


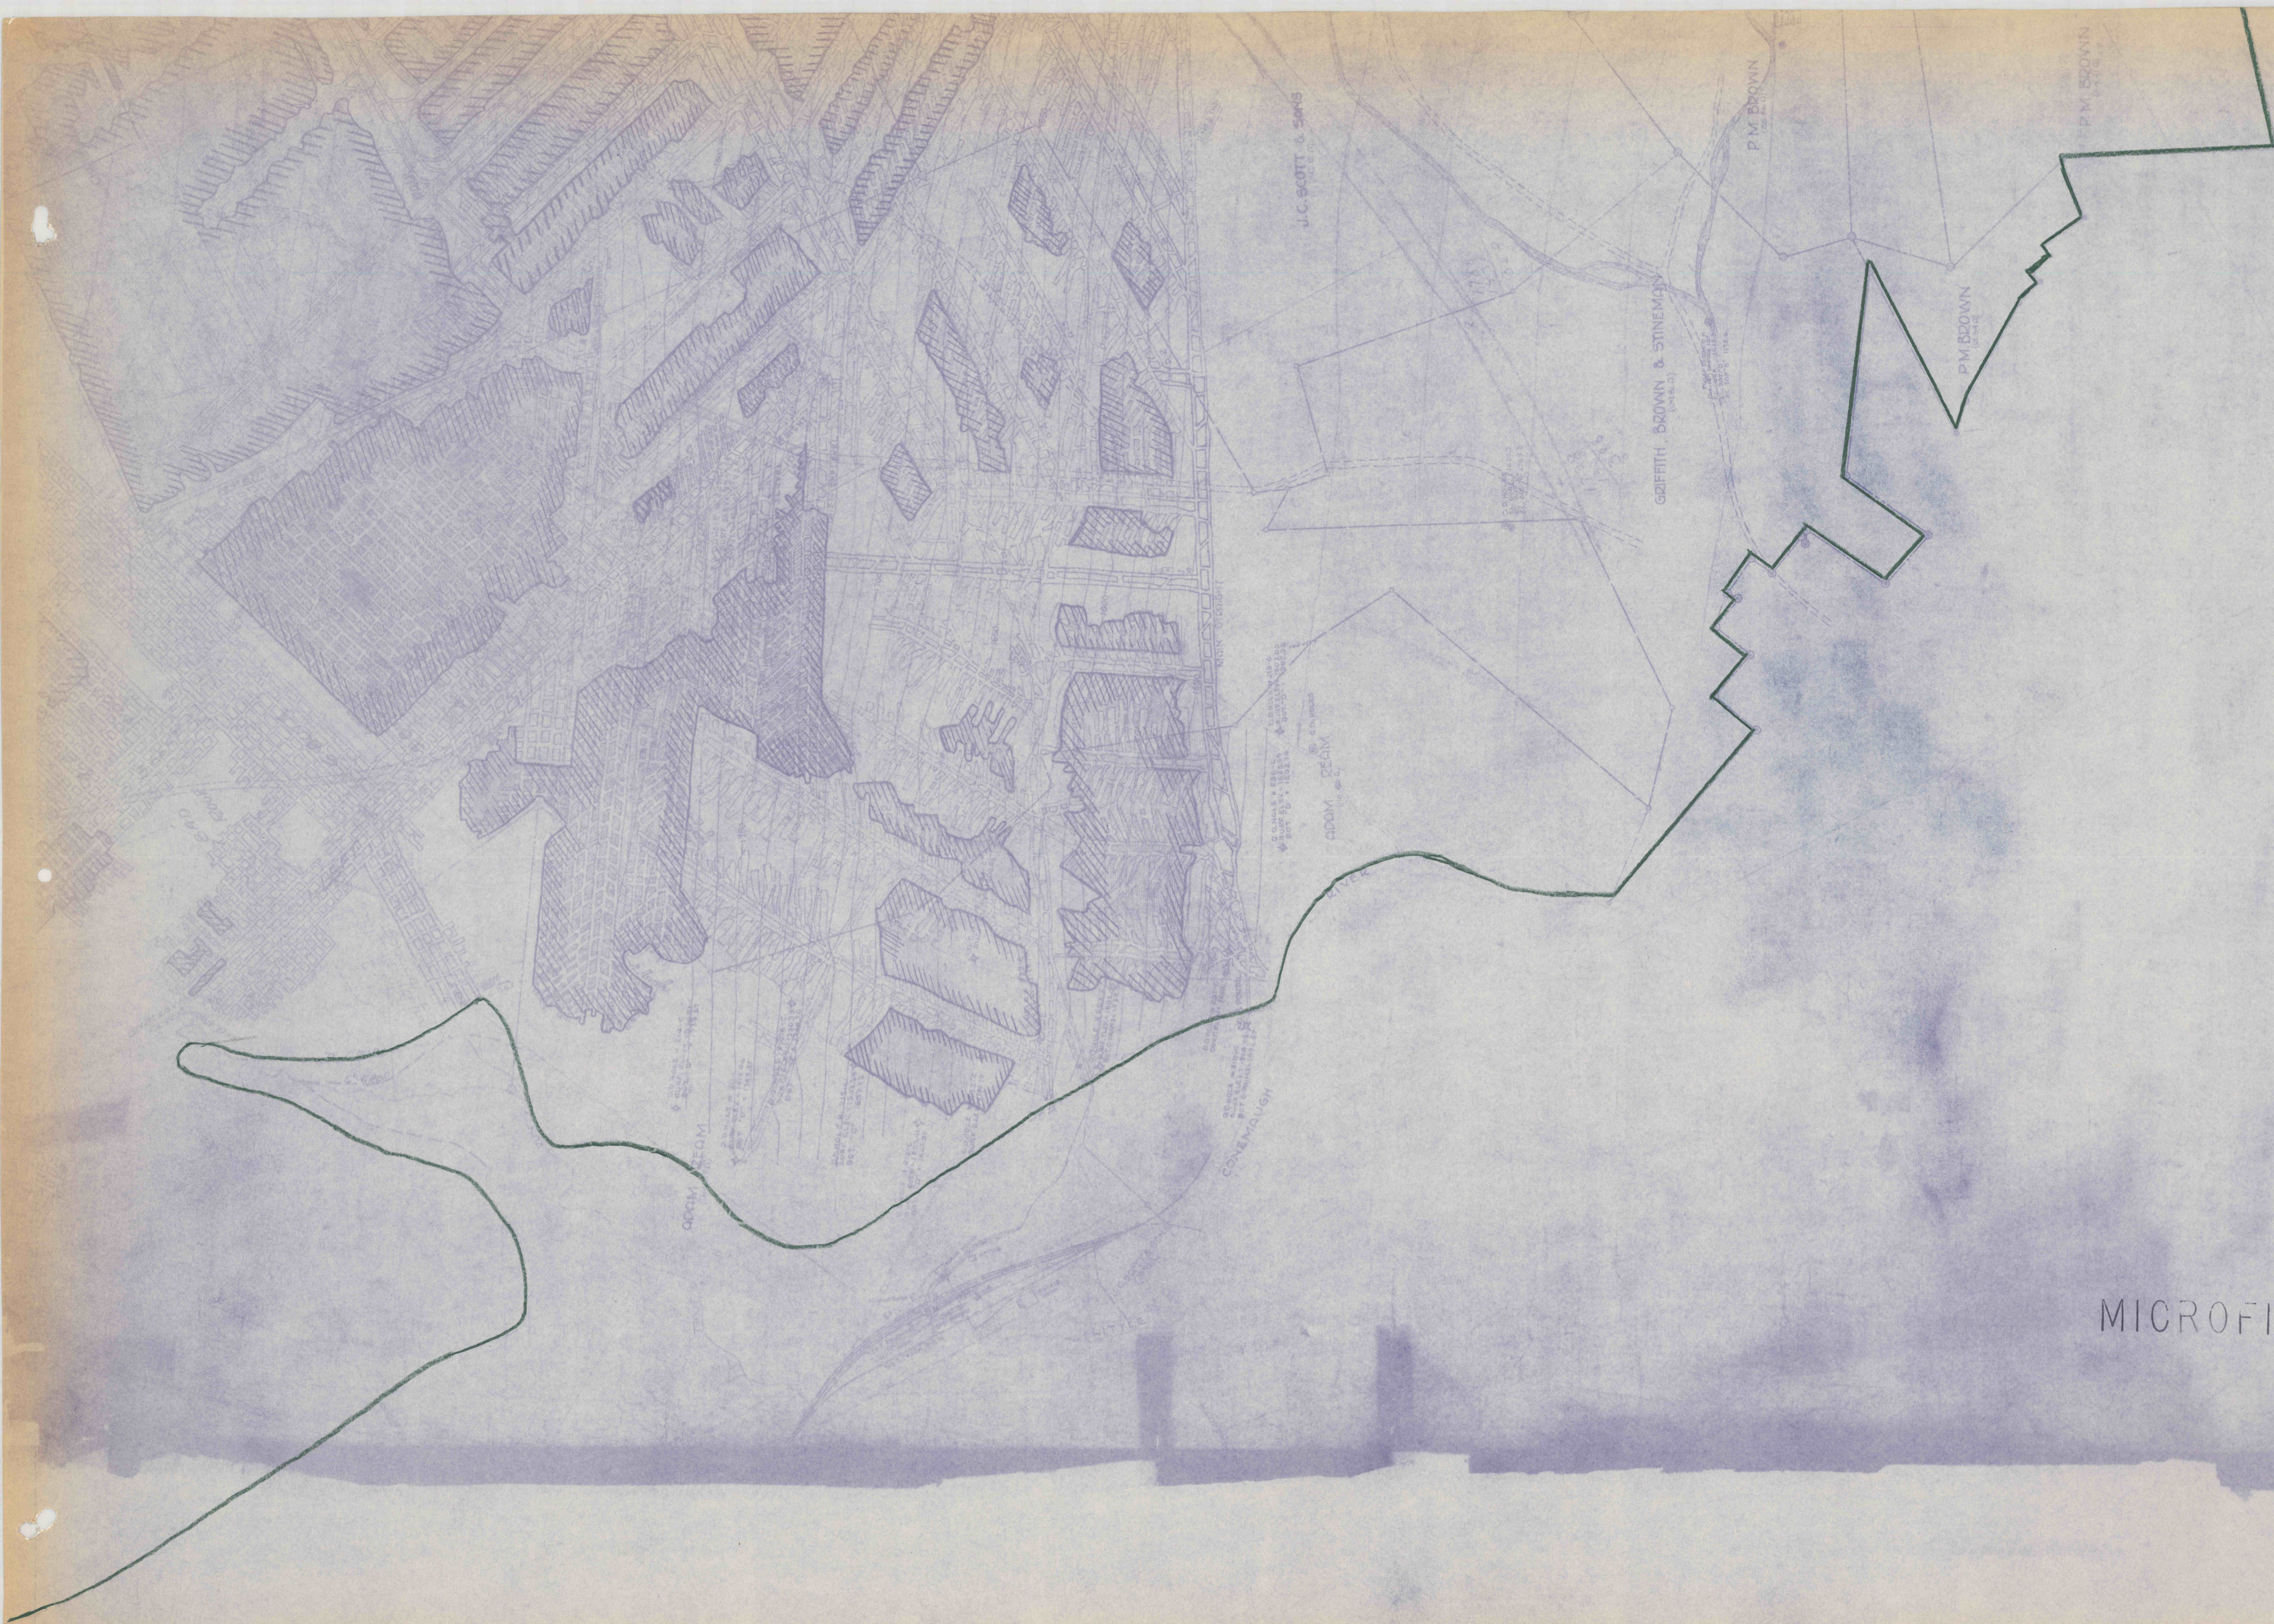

MICROFILMED