



MICROFILMED

MICROFILMED

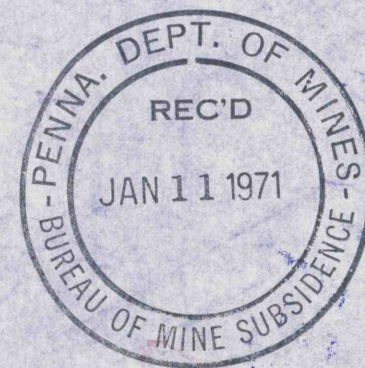

LEGEND:-
INDEX FOR 400' MAP
PROPERTY LINE
AREA MINED OUT

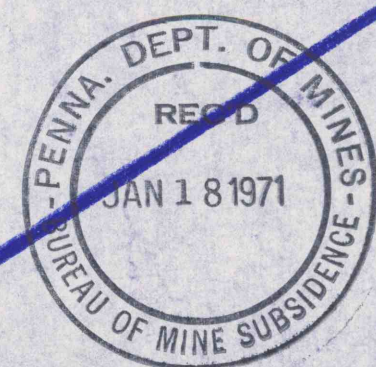

PENNSYLVANIA COAL & COKE CORPORATION
EHRENFELD NO. 8 COLLIERY
CREIGHTON, PA., JAN. 1ST 1920
CONDITIONS AS OF 1-1-71

DRAWING 1-1-71 W-553-A

