


MICROFILMED

LEGEND:-
INDEX FOR 100 MAP
PROPERTY LINE
PROJECTED MINING
LIMIT OF HOUSE SUPPORT

PENNSYLVANIA COAL & COKE CORPORATION
EHRENFELD NO. 8 COLLIERY
CRENSHAW, PA. JAN 1ST 1920
CONDITIONS AS OF 1-1-71

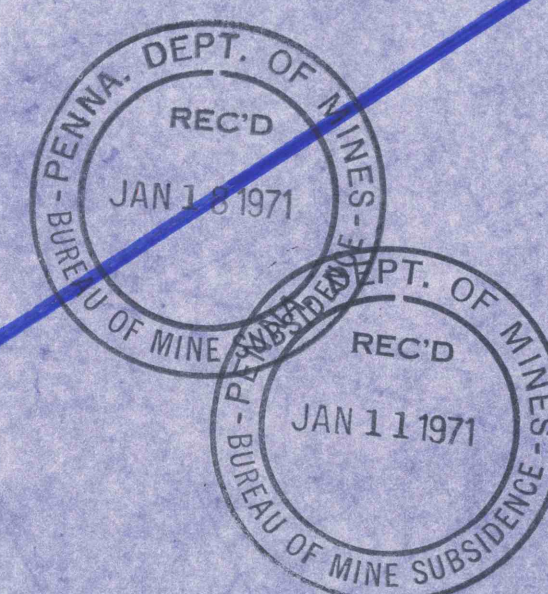

DRAWING NO. W-553-4