


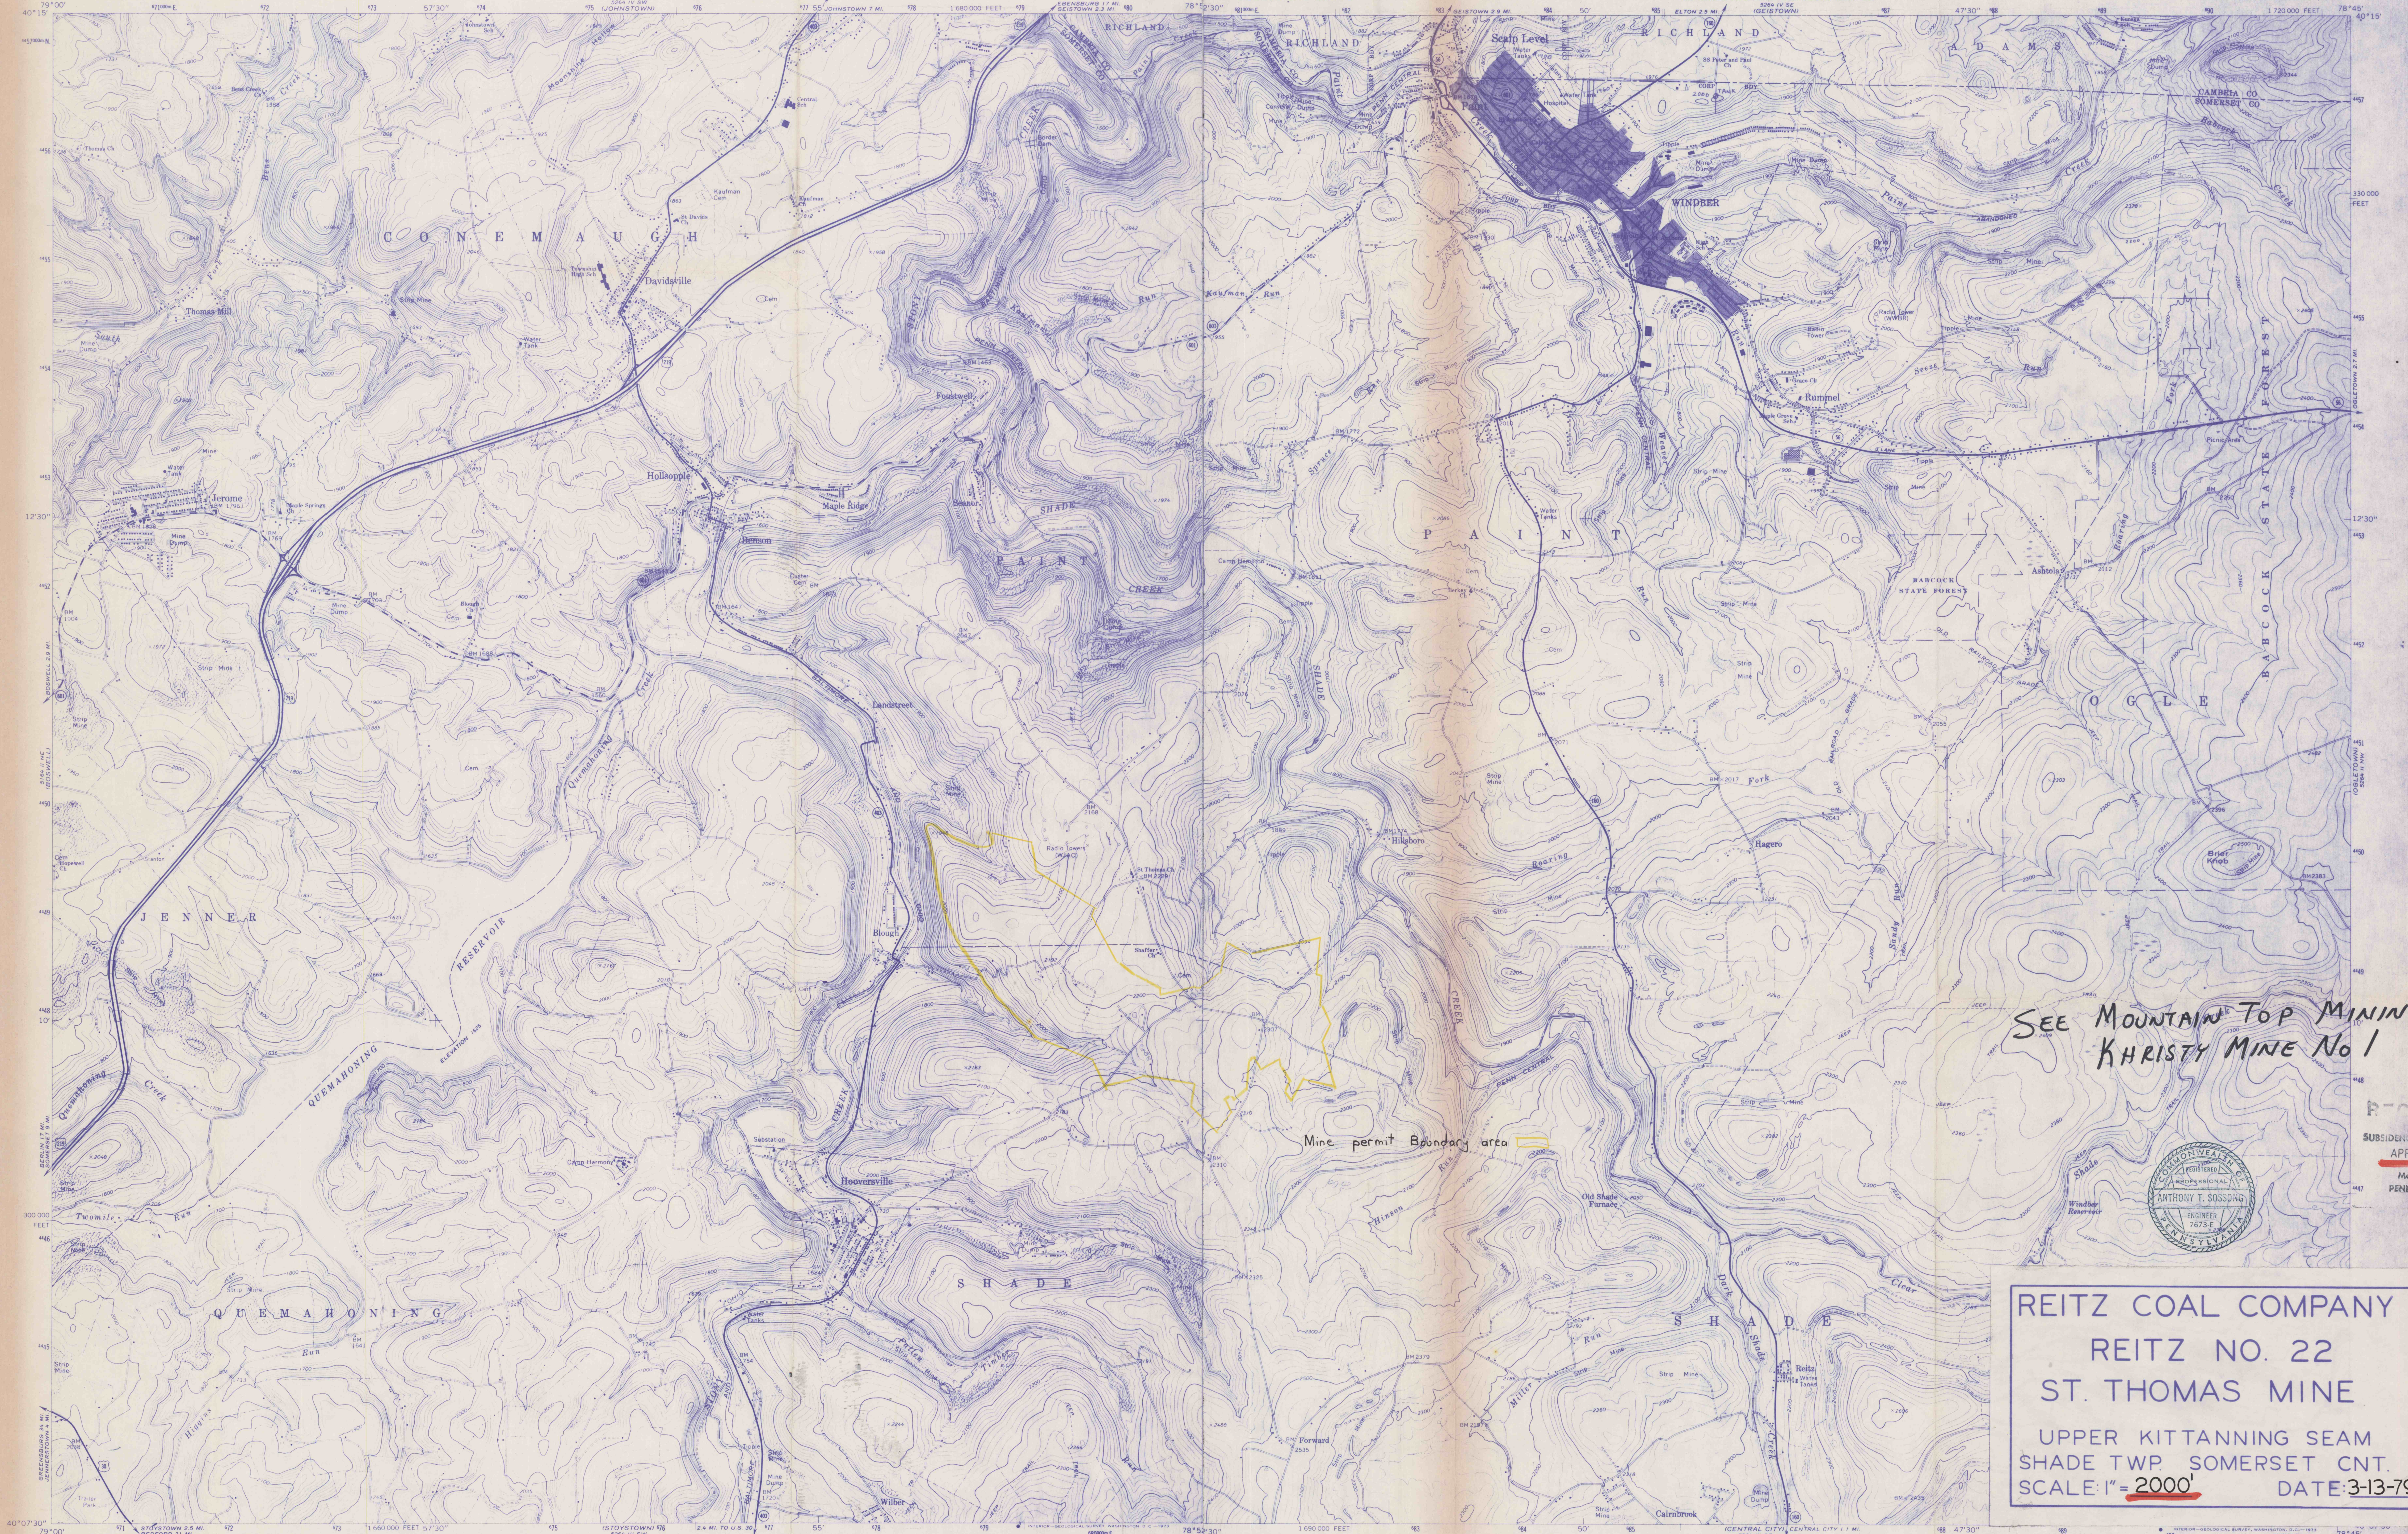

SEE MOUNTAIN TOP MINING, INC.
KRISTY MINE No 1



REITZ COAL COMPANY
REITZ NO. 22
ST. THOMAS MINE
UPPER KITTANNING SEAM
SHADE TWP. SOMERSET CNT.
SCALE: 1" = 2000'
DATE: 3-13-79

Mapped, edited, and published by the Geological Survey
Control by USGS and USC&GS
Topography by photogrammetric methods from aerial
photographs taken 1966 and 1967. Field checked 1971.
Polyconic projection, 1927 North American datum.
10,000-foot grid based on Pennsylvania coordinate system, south zone
1000-meter Universal Transverse Mercator grid ticks, zone 17, shown in blue.
Thin red dashed lines indicate selected fence and field lines where
generally visible on aerial photographs. This information is uncheck-

SCALE 1:24,000
CONTOUR INTERVAL 20 FEET
DATUM IS MEAN SEA LEVEL
ROAD CLASSIFICATION
Primary highway, hard surface
Secondary highway, hard surface
Unimproved road
Interstate Route
U.S. Route
State Route

Mapped, edited, and published by the Geological Survey
Control by USGS and USC&GS
Topography by photogrammetric methods from aerial
photographs taken 1966, 1967, and 1969. Field checked 1971.
Polyconic projection, 1927 North American datum.
10,000-foot grid based on Pennsylvania coordinate system, south zone
1000-meter Universal Transverse Mercator grid ticks, zone 17,
shown in blue.
Thin red dashed lines indicate selected fence and field lines where
generally visible on aerial photographs. This information is uncheck-

SCALE 1:24,000
CONTOUR INTERVAL 20 FEET
DATUM IS MEAN SEA LEVEL
ROAD CLASSIFICATION
Primary highway, hard surface
Secondary highway, hard surface
Unimproved road
Interstate Route
U.S. Route
State Route


