


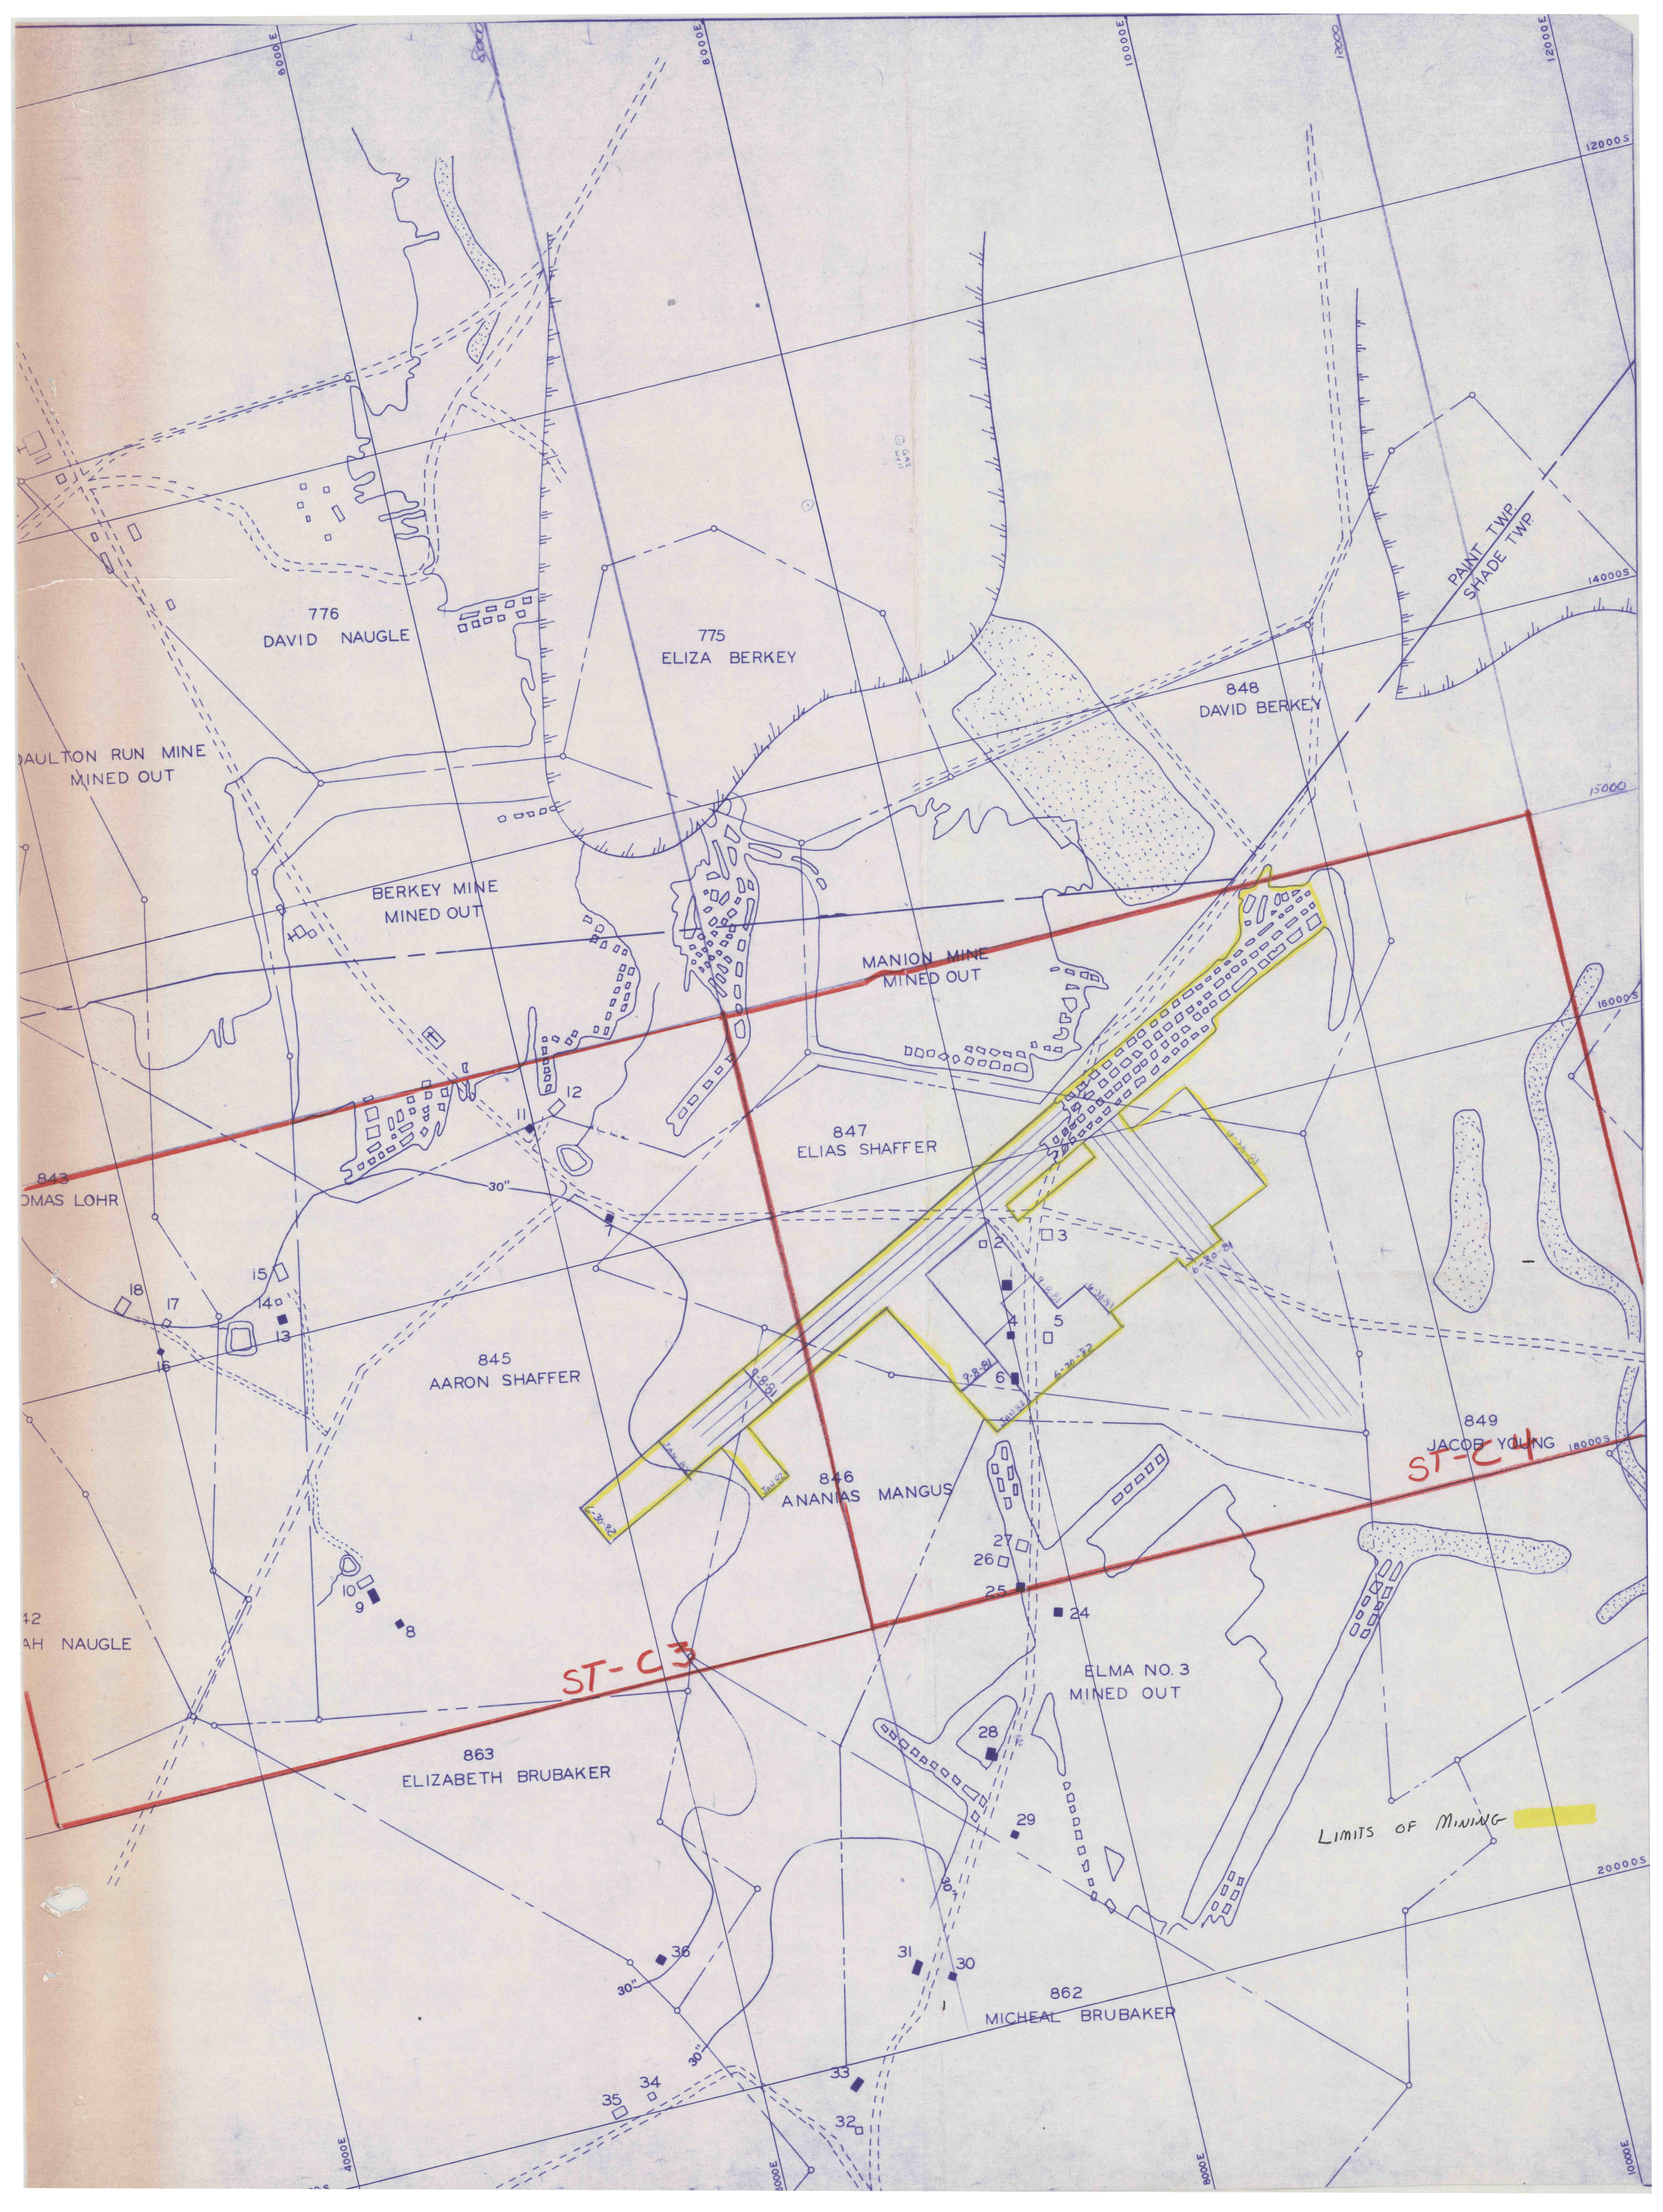

776
DAVID NAUGLE

775
ELIZA BERKEY

848
DAVID BERKEY

VAULTON RUN MINE
MINED OUT

BERKEY MINE
MINED OUT

MANION MINE
MINED OUT

847
ELIAS SHAFFER

843
THOMAS LOHR

845
AARON SHAFFER

846
ANANIAS MANGUS

849
JACOB YOUNG

ST-C3

ST-C4

842
AH NAUGLE

ELMA NO. 3
MINED OUT

863
ELIZABETH BRUBAKER

LIMITS OF MINING

862
MICHAEL BRUBAKER