




MATCH TO C-2

MATCH TO D-3

MATCH TO C-1

RECEIVED
DIVISION OF MINE
SUBSIDIARY REGULATION
JUL 29 1982
McMURRAY, PA

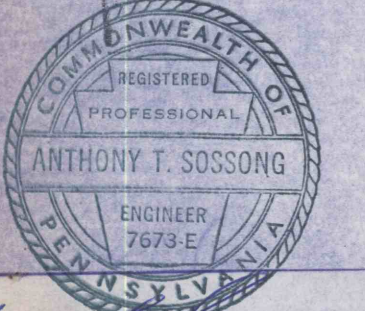

THIS MINE TEMPORARILY
CLOSED
EFFECTIVE 4-7-82

- SUBSIDENCE LEGEND**
- MINING COMPLETED AREA
 - PERMIT BOUNDARY
 - ADVANCED MINING
 - CONTEMPLATED MINING
FROM 6-30-82 TO 12-31-82
 - STRUCTURES - PROTECTED
 - STRUCTURES - OTHER
 - STRUCTURES - BUILT AFTER ACT
- CODED BY *STC* CHECKED BY *STC*

REITZ COAL COMPANY
REITZ NO. 22
ST. THOMAS MINE

UPPER KITTANNING SEAM
SHADE TWP. SOMERSET CO.
SCALE: 1"=100' SURVEY DATE 4-22-82

MATCH TO B-3

ST-C3