



NO MINING CONDUCTED ON
THIS SHEET 1-15-89 TO 7-15-89
NONE PROJECTED

TANOMA COAL COMPANY
TANOMA MINE


LOWER KITTANNING "B" SEAM
RAYNE TWP. INDIANA COUNTY, PA
GREEN TWP. INDIANA COUNTY, PA
CHERRYHILL TWP. INDIANA COUNTY, PA
WHITE TWP. INDIANA COUNTY, PA
SCALE 1" = 200' SURVEY DATE: 12/22/88

PROTECTED AREA 50% MINING ONLY
PROTECTED STRUCTURES
UNPROTECTED STRUCTURES
SUBSIDENCE BOUNDARY
SAFETY ZONE 50% MINING ONLY
SIX (6) MONTH MINE OUTLINE
PILLARED AREAS
SURFACE PROPERTY
COAL RIGHTS RETAINED BY SURFACE OWNER

NOTES:
1. COAL LEASED FROM CBC (EXCEPT AS NOTED)
2. TYPICAL ENTRY WIDTH IN PROTECTED AREA WILL BE 18 FEET (EXCEPT AS NOTED)
3. ANY PILLAR WHICH CROSSES THE PROTECTED LINE WILL BE CONSIDERED PART OF THE SUPPORT AREA.

FROM: 1/15/89 TO: 7/15/89

RECEIVED
FEB 10 1989
Dept. of Environmental Resources
McMurray District Office

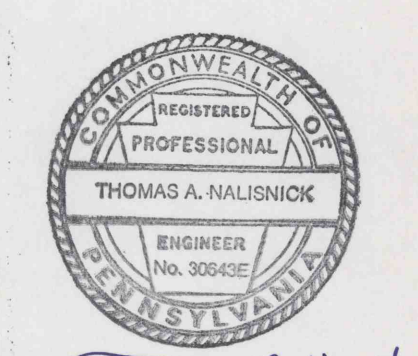

Thomas A. Nalisnick

TANOMA-006