


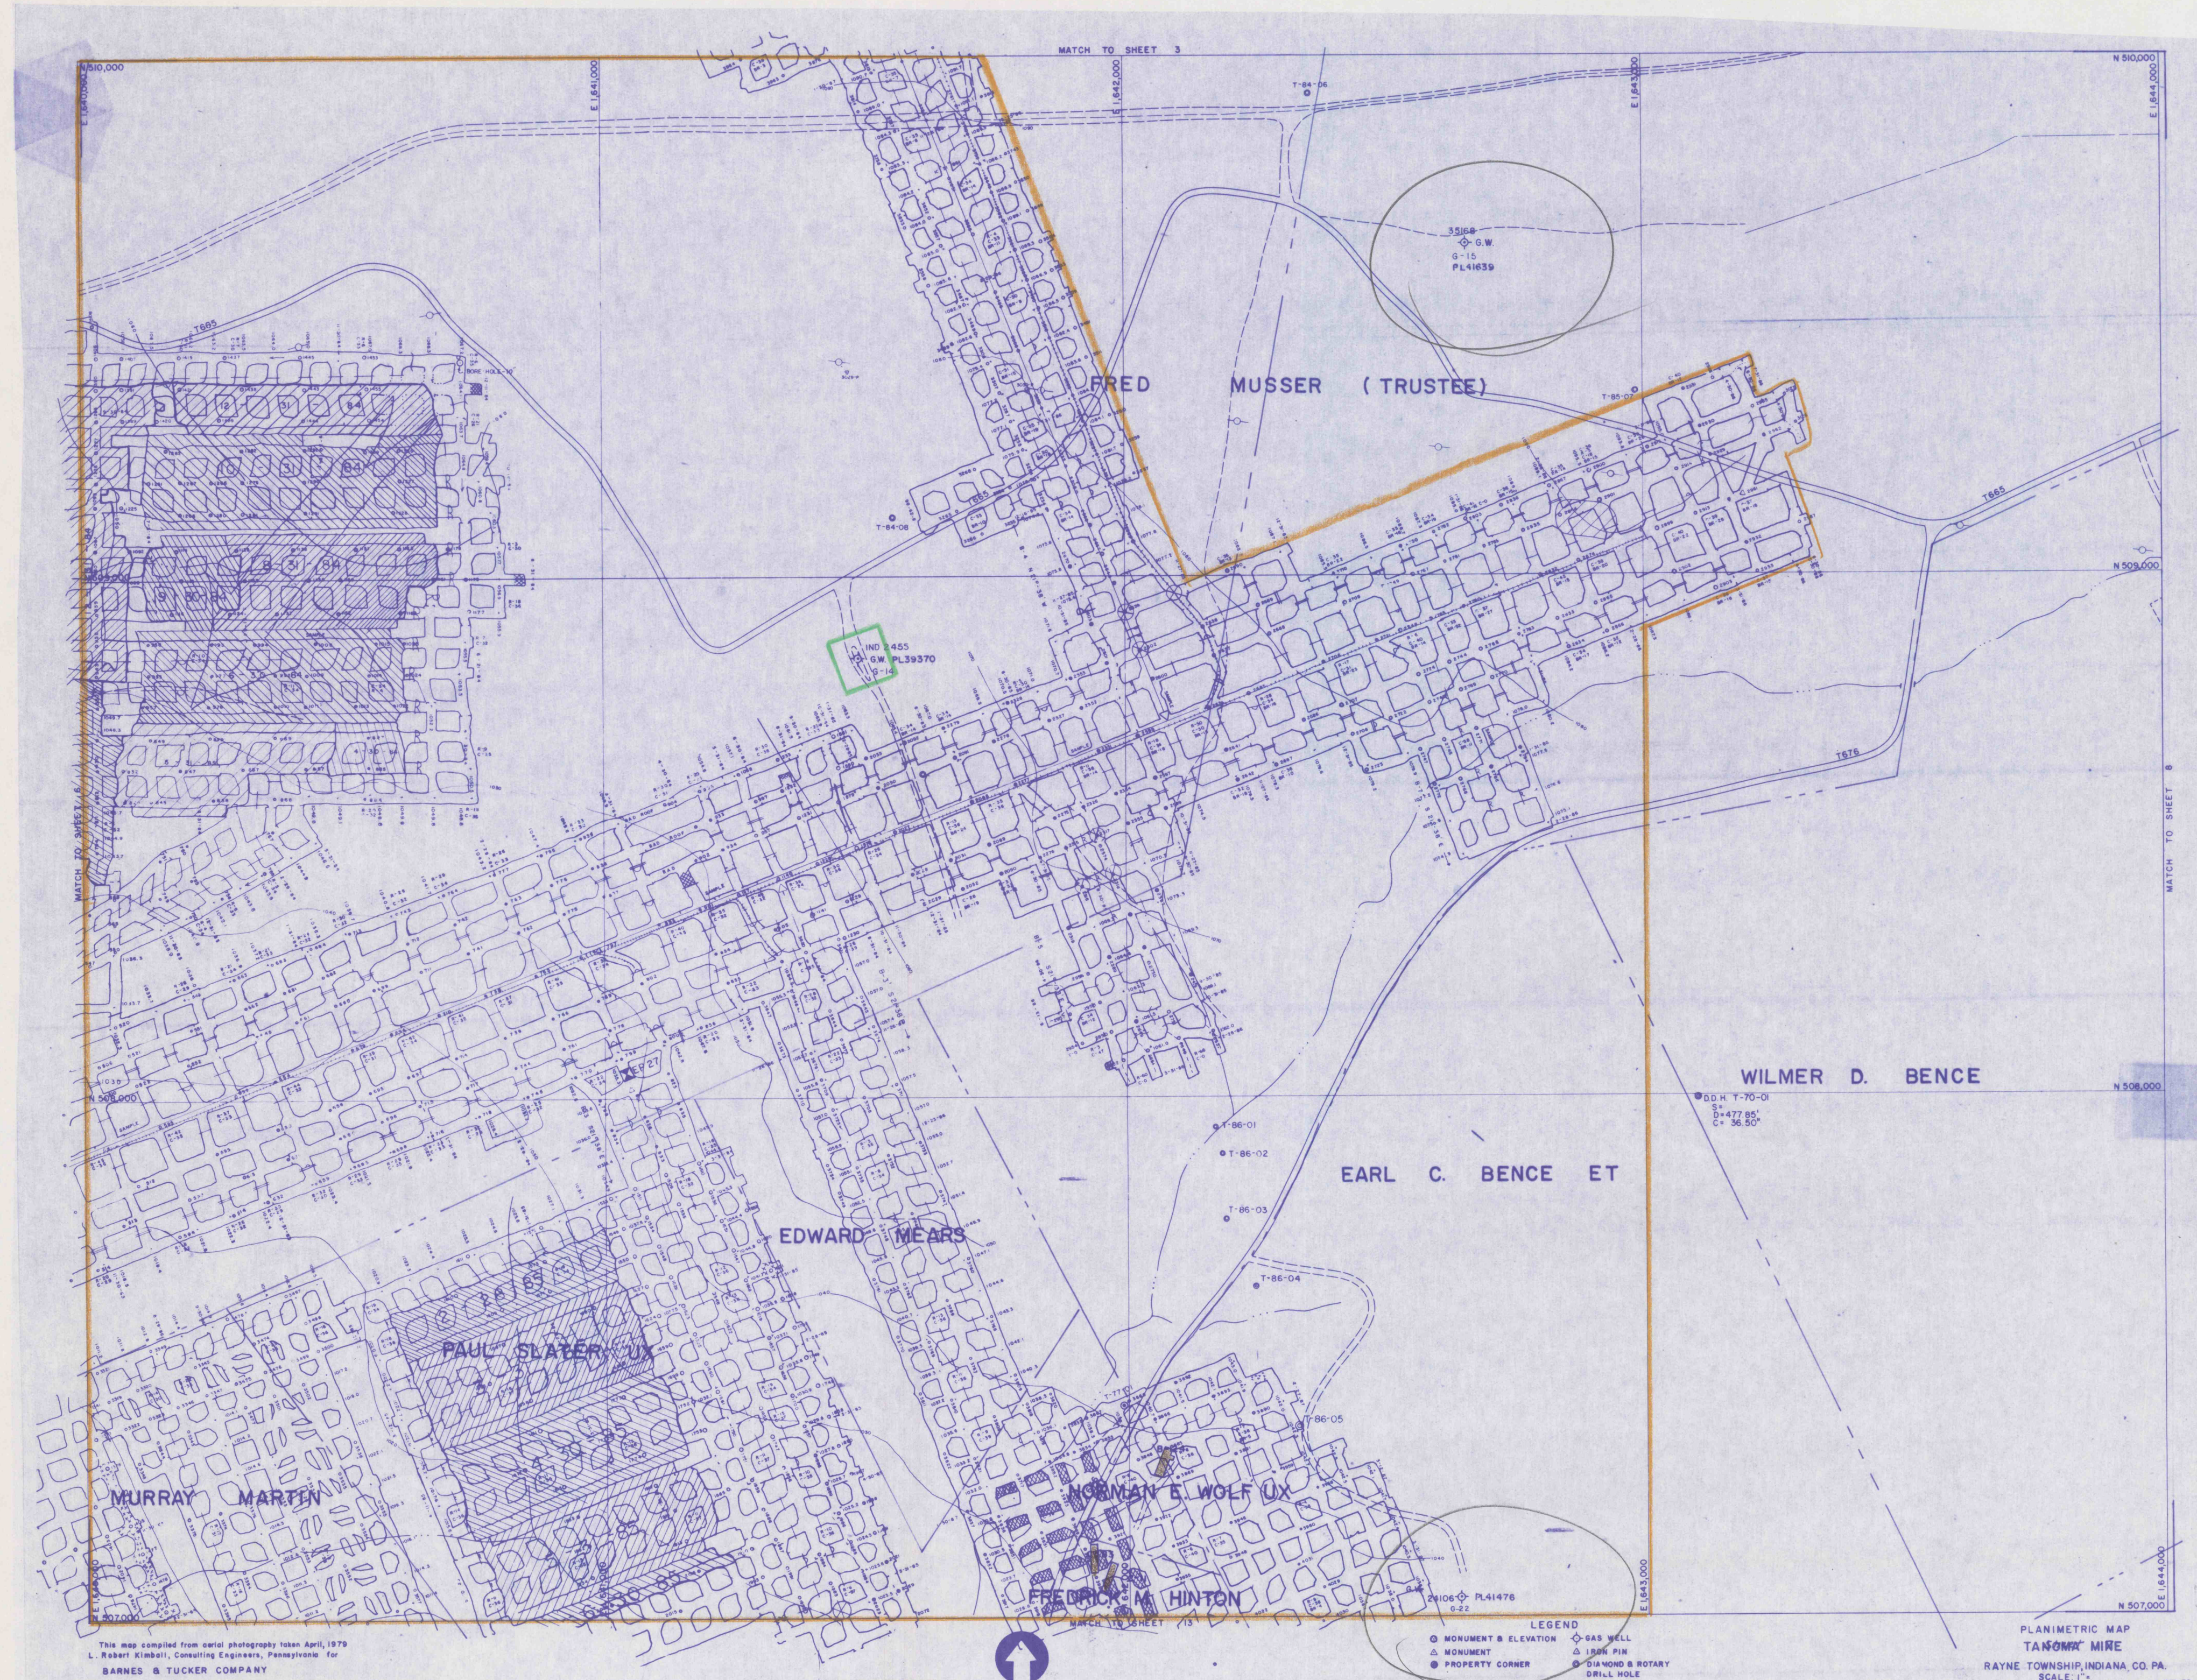

NO MINING CONDUCTED ON THIS SHEET
1-15-89 TO 7-15-89
NONE PROJECTED

TANOMA COAL COMPANY
TANOMA MINE

LOWER KITTANNING	"B" SEAM
RAYNE TWP.	INDIANA COUNTY, PA
GREEN TWP.	INDIANA COUNTY, PA
CHERRYHILL TWP.	INDIANA COUNTY, PA
WHITE TWP.	INDIANA COUNTY, PA


SCALE 1" = 200' SURVEY DATE: 12/22/88

PROTECTED AREA 50% MINING ONLY	
PROTECTED STRUCTURES	
UNPROTECTED STRUCTURES	
SUBSIDENCE BOUNDARY	
SAFETY ZONE 50% MINING ONLY	
SIX (6) MONTH MINE OUTLINE	
PILLARED AREAS	
SURFACE PROPERTY	
COAL RIGHTS RETAINED BY SURFACE OWNER	

NOTES:
1. COAL LEASED FROM CBC (EXCEPT AS NOTED)
2. TYPICAL ENTRY WIDTH IN PROTECTED AREA WILL BE 18 FEET (EXCEPT AS NOTED)
3. ANY PILLAR WHICH CROSSES THE PROTECTED LINE WILL BE CONSIDERED PART OF THE SUPPORT AREA.

FROM: 1/15/89 TO: 7/15/89

RECEIVED
JAN 23 1989
Dept. of Environmental Resources
McMurray District Office

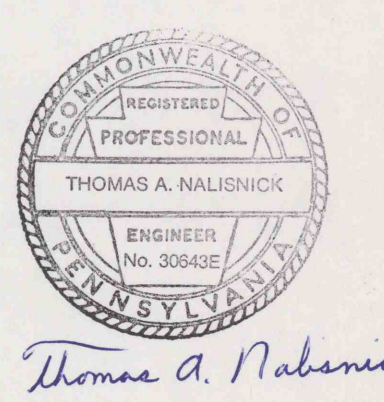

Thomas A. Nalensnick

TANOMA - 007