


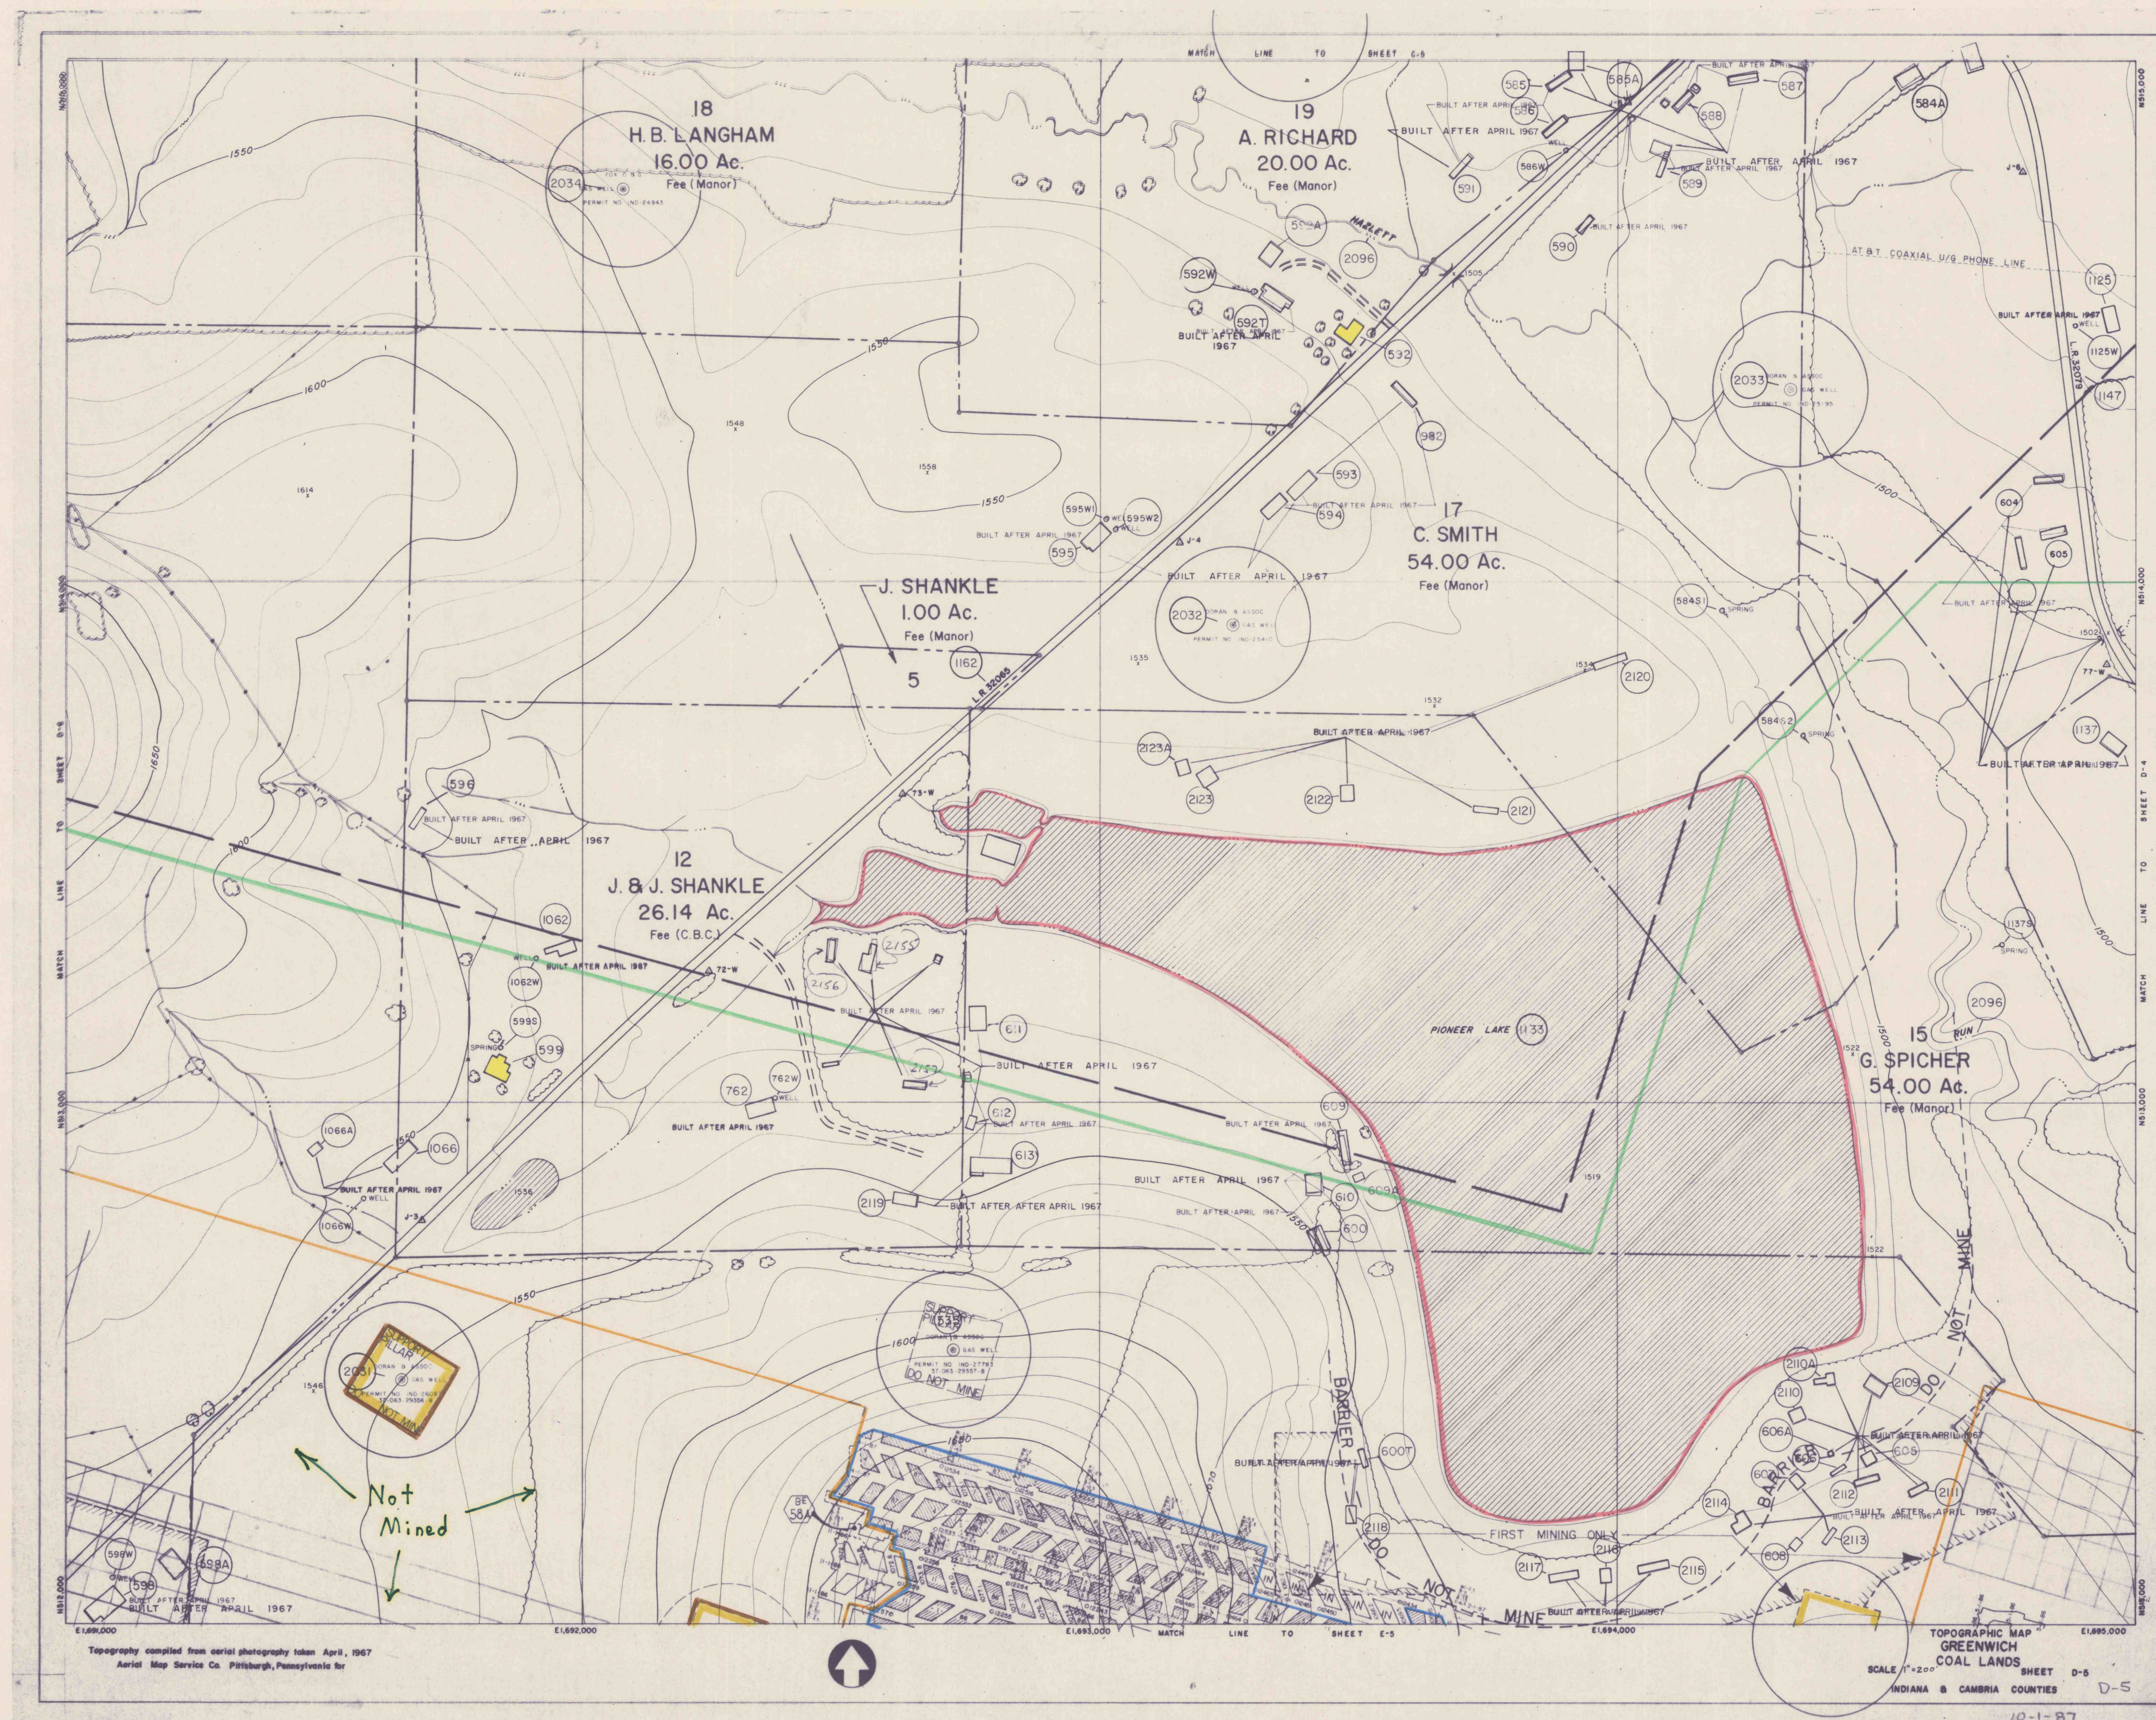

GREENWICH COLLIERIES NO'S 1 AND 2 MINES DIV. OF PENNSYLVANIA MINES CORP.

LOWER FREEPORT "D" SEAM

GREEN & MONTGOMERY TOWNSHIPS. INDIANA COUNTY, PA.

SCALE 1"=200' SURVEY DATE 10-1-87

PERIOD COVERED 10-1-87 TO 4-1-88

DWELLINGS & CEMETERIES (IN PLACE BEFORE 1966 ACT)

PUBLIC BUILDINGS; IMPOUNDMENTS (PLUS 20 AC. FEET)

BOUNDARY OF MINE

POLITICAL SUBDIVISION BOUNDARIES

SIX MONTH SUBSIDENCE CONTROL BOUNDARY

FIVE YEAR SUBSIDENCE CONTROL BOUNDARY

MINING COMPLETED AREA; PILLARS EXTRACTED

CALCULATED SUPPORT AREA

COAL PILLAR SUPPORT AREA

OUTCROP OF "D" SEAM

FEATURE IDENTIFICATION NO.

MINING WILL BE ON PROJECTED CENTERLINES AND ENTRY WIDTHS NOT TO EXCEED 20 FEET IN SUPPORT AREAS.


MINERAL OWNERSHIP

SURFACE OWNERSHIP (ON PROPERTY MAP PRINTS)

No Mining Done

RECEIVED
NOV - 2 1987

Dept. of Environmental Resources
McMurray District Office

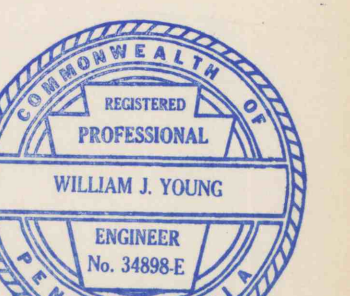

William J. Young

Green - D5

D5