

**GREENWICH COLLIERIES**  
**NO'S 1 AND 2 MINES**  
**DIV. OF PENNSYLVANIA MINES CORP.**  
**LOWER FREEPORT "D" SEAM**

GREEN & MONTGOMERY TOWNS. INDIANA COUNTY, PA.  
 SCALE 1"=200' SURVEY DATE 10-1-87  
 PERIOD COVERED 10-1-87 TO 4-1-88

**LEGEND**


- DWELLINGS & CEMETERIES (IN PLACE BEFORE 1966 ACT) [Yellow box]
- PUBLIC BUILDINGS; IMPOUNDMENTS (PLUS 20 AC. FEET) [Red box]
- BOUNDARY OF MINE [Orange line]
- POLITICAL SUBDIVISION BOUNDARIES [Purple line]
- SIX MONTH SUBSIDENCE CONTROL BOUNDARY [Green line]
- FIVE YEAR SUBSIDENCE CONTROL BOUNDARY [Blue line]
- MINING COMPLETED AREA; PILLARS EXTRACTED [Hatched box]
- CALCULATED SUPPORT AREA [White box]
- COAL PILLAR SUPPORT AREA [Brown box]
- OUTCROP OF "D" SEAM [Black line]
- FEATURE IDENTIFICATION NO. [Circle with number]
- MINING WILL BE ON PROJECTED CENTERLINES AND ENTRY WIDTHS NOT TO EXCEED 20 FEET IN SUPPORT AREAS.
- MINERAL OWNERSHIP [Blue box]
- SURFACE OWNERSHIP (ON PROPERTY MAP PRINTS) [Blue box]

No Mining Done

Not Mined


**RECEIVED**  
 NOV - 2 1987  
 Dept. of Environmental Resources  
 McMurray District Office

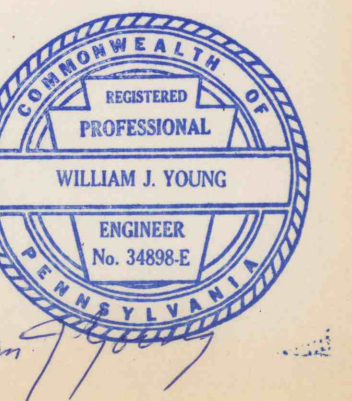

*William J. Young*