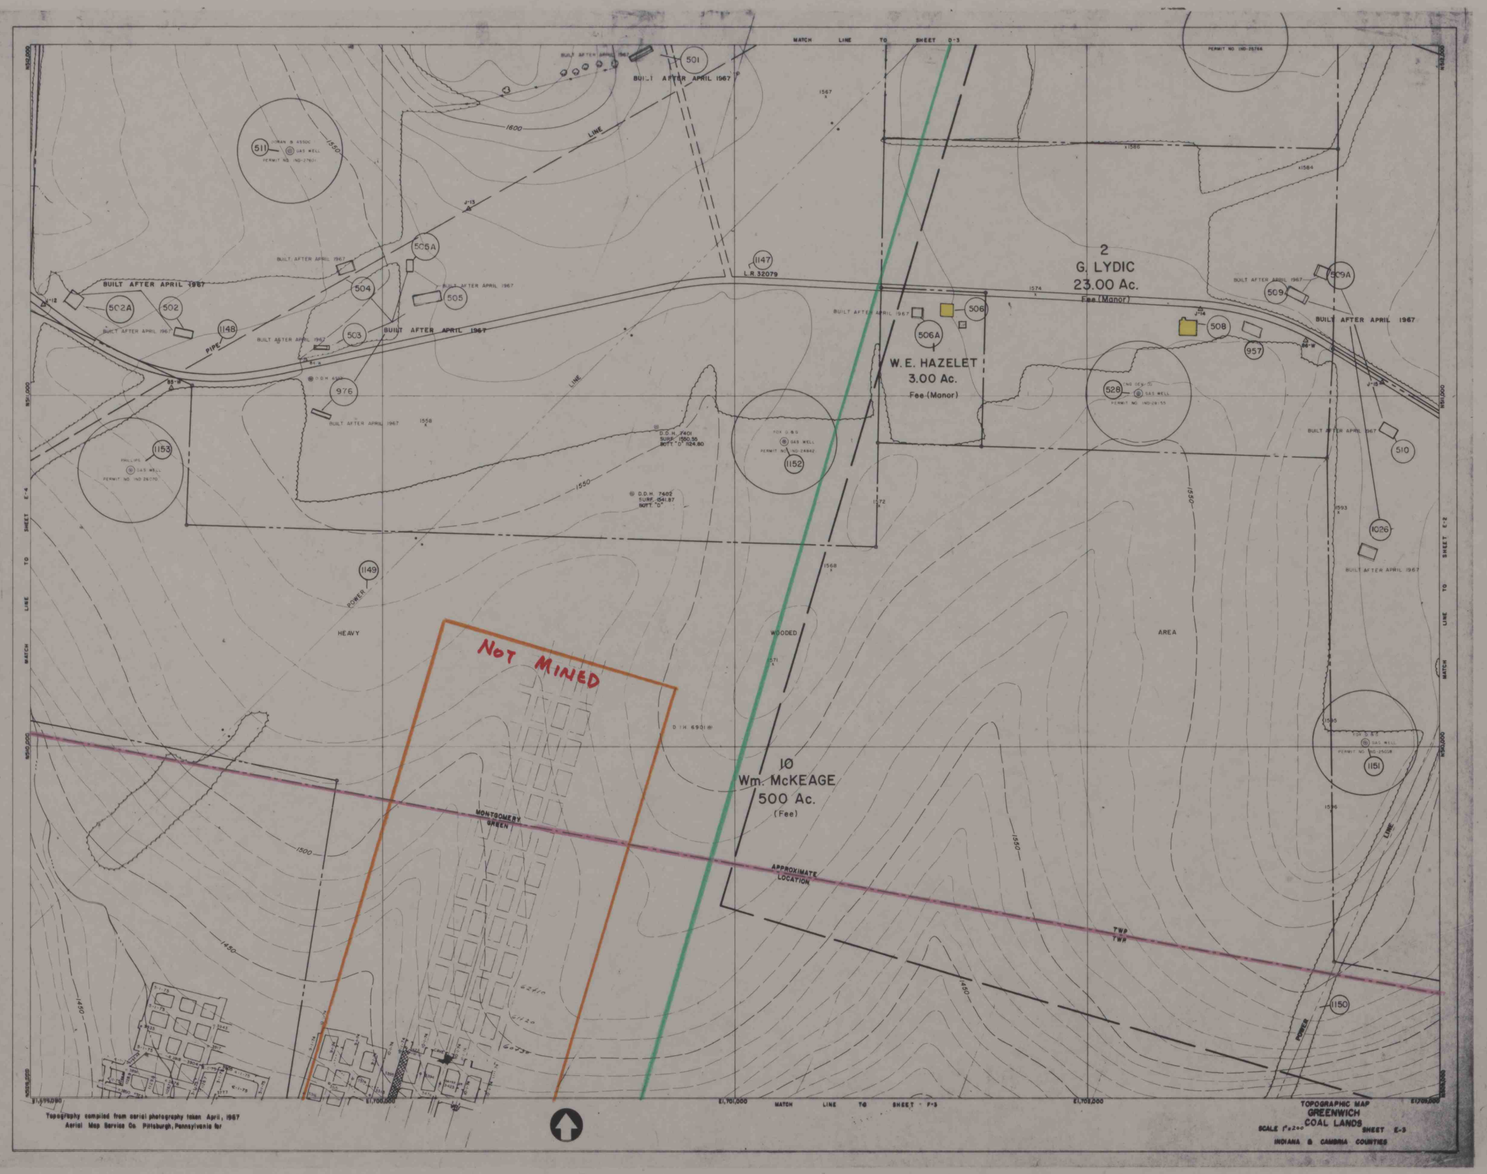

GREENWICH COLLIERIES

NO'S 1 AND 2 MINES

DIV. OF PENNSYLVANIA MINES CORP.

LOWER FREEPORT "D" SEAM

GREEN & MONTGOMERY TWPS. INDIANA COUNTY, PA.

SCALE 1" = 200' SURVEY DATE 4-1-85

PERIOD COVERED No Mining 4-1-85 TO 10-1-85

DWELLINGS & CEMETERIES (IN PLACE BEFORE 1966 ACT)

PUBLIC BUILDINGS; IMPOUNDMENTS (PLUS 20 AC. FEET)

BOUNDARY OF MINE

POLITICAL SUBDIVISION BOUNDARIES

SIX MONTH MINE OUTLINE No Mining

MINING LIMITS

MINING COMPLETED AREA; PILLARS EXTRACTED

CALCULATED SUPPORT AREA

COAL PILLAR SUPPORT AREA

OUTCROP OF "D" SEAM

FEATURE IDENTIFICATION NO. (1)

MINING WILL BE ON PROJECTED CENTERLINES AND ENTRY WIDTHS NOT TO EXCEED 20 FEET IN SUPPORT AREAS.



RECEIVED
DIVISION OF MINE
SUBSIDENCE REGULATION
MAY 01 1985
McMURRAY, PA

E-3