


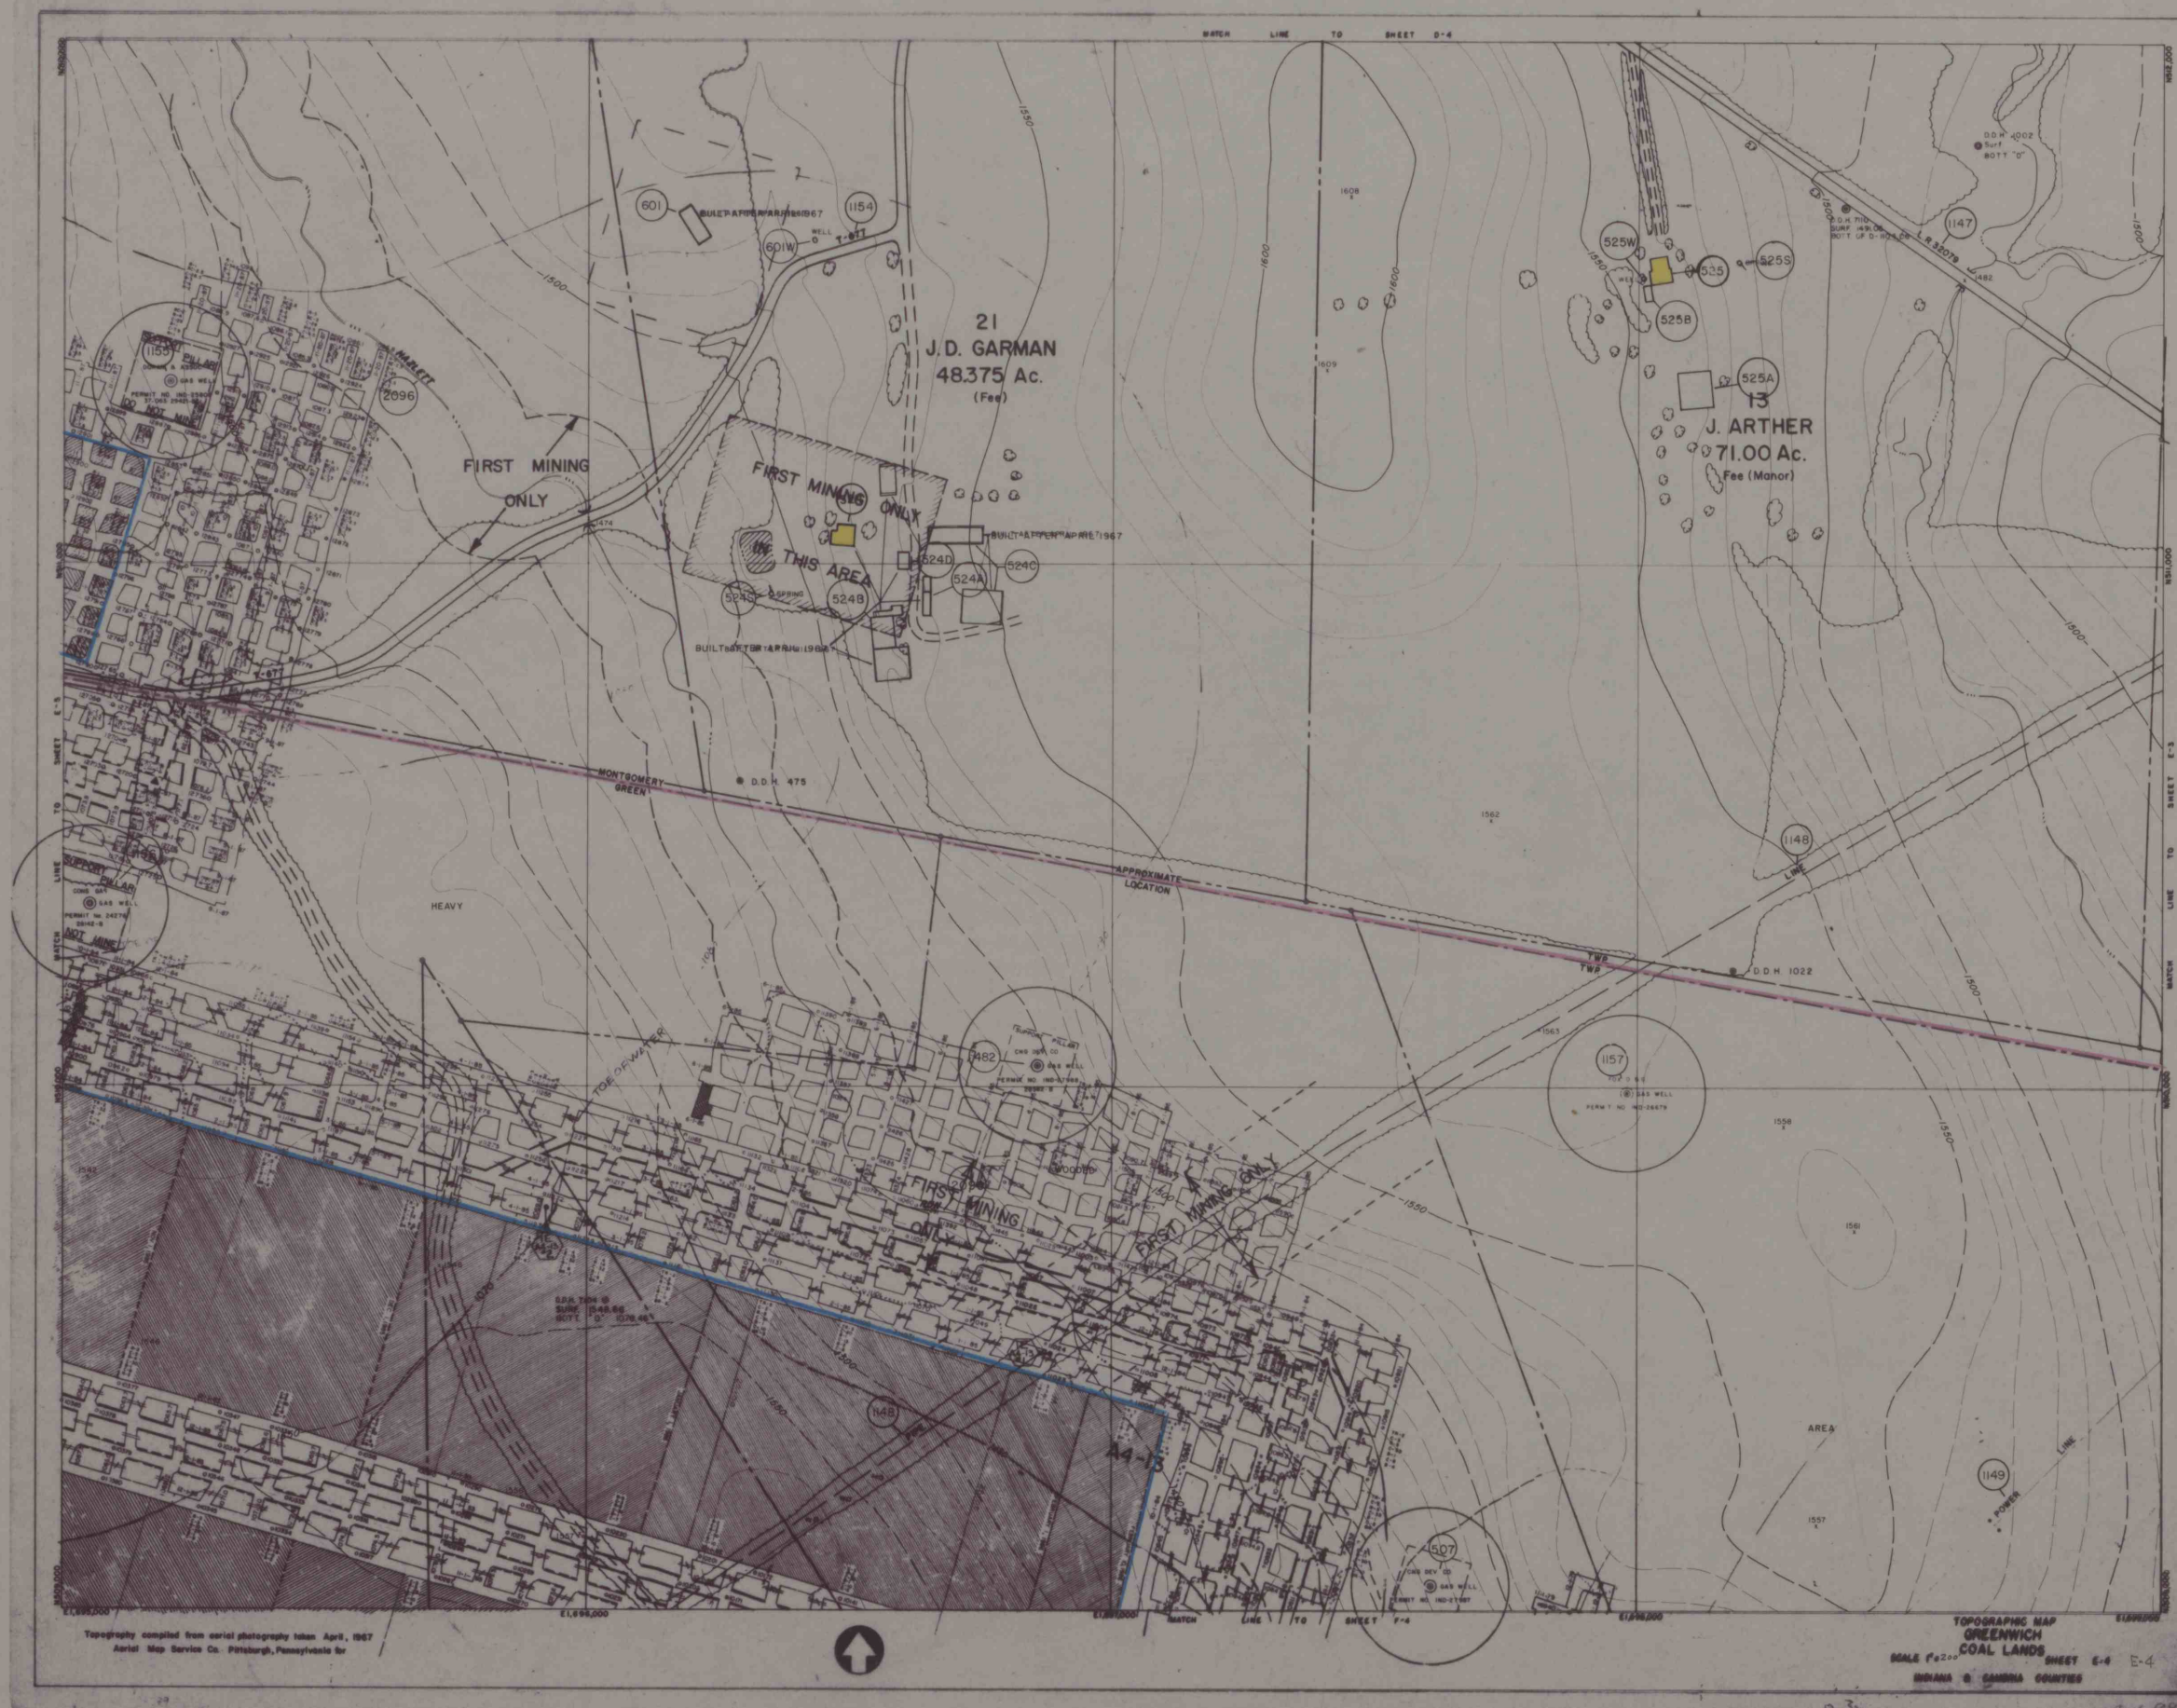


GREENWICH COLLIERIES NO'S 1 AND 2 MINES DIV. OF PENNSYLVANIA MINES CORP. LOWER FREEPORT "D" SEAM

GREEN & MONTGOMERY TWPS. INDIANA COUNTY, PA.
SCALE 1"=200' SURVEY DATE 4-1-88
PERIOD COVERED 4-1-88 TO 10-1-88

DWELLINGS & CEMETERIES (IN PLACE BEFORE 1966 ACT) ■
PUBLIC BUILDINGS; IMPOUNDMENTS (PLUS 20 AC. FEET) ■
BOUNDARY OF MINE —
POLITICAL SUBDIVISION BOUNDARIES —
SIX MONTH SUBSIDENCE CONTROL BOUNDARY —
FIVE YEAR SUBSIDENCE CONTROL BOUNDARY —
MINING COMPLETED AREA; PILLARS EXTRACTED ▨
CALCULATED SUPPORT AREA ▨
COAL PILLAR SUPPORT AREA ▨
OUTCROP OF "D" SEAM ▨
FEATURE IDENTIFICATION NO. ○
MINING WILL BE ON PROJECTED CENTERLINES AND ENTRY WIDTHS NOT TO EXCEED 20 FEET IN SUPPORT AREAS.
MINERAL OWNERSHIP ○
SURFACE OWNERSHIP (ON PROPERTY MAP PRINTS) ○

RECEIVED
MAY 02 1988

Dept. of Environmental Resources
McMurry District Office

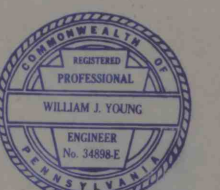

William J. Young