



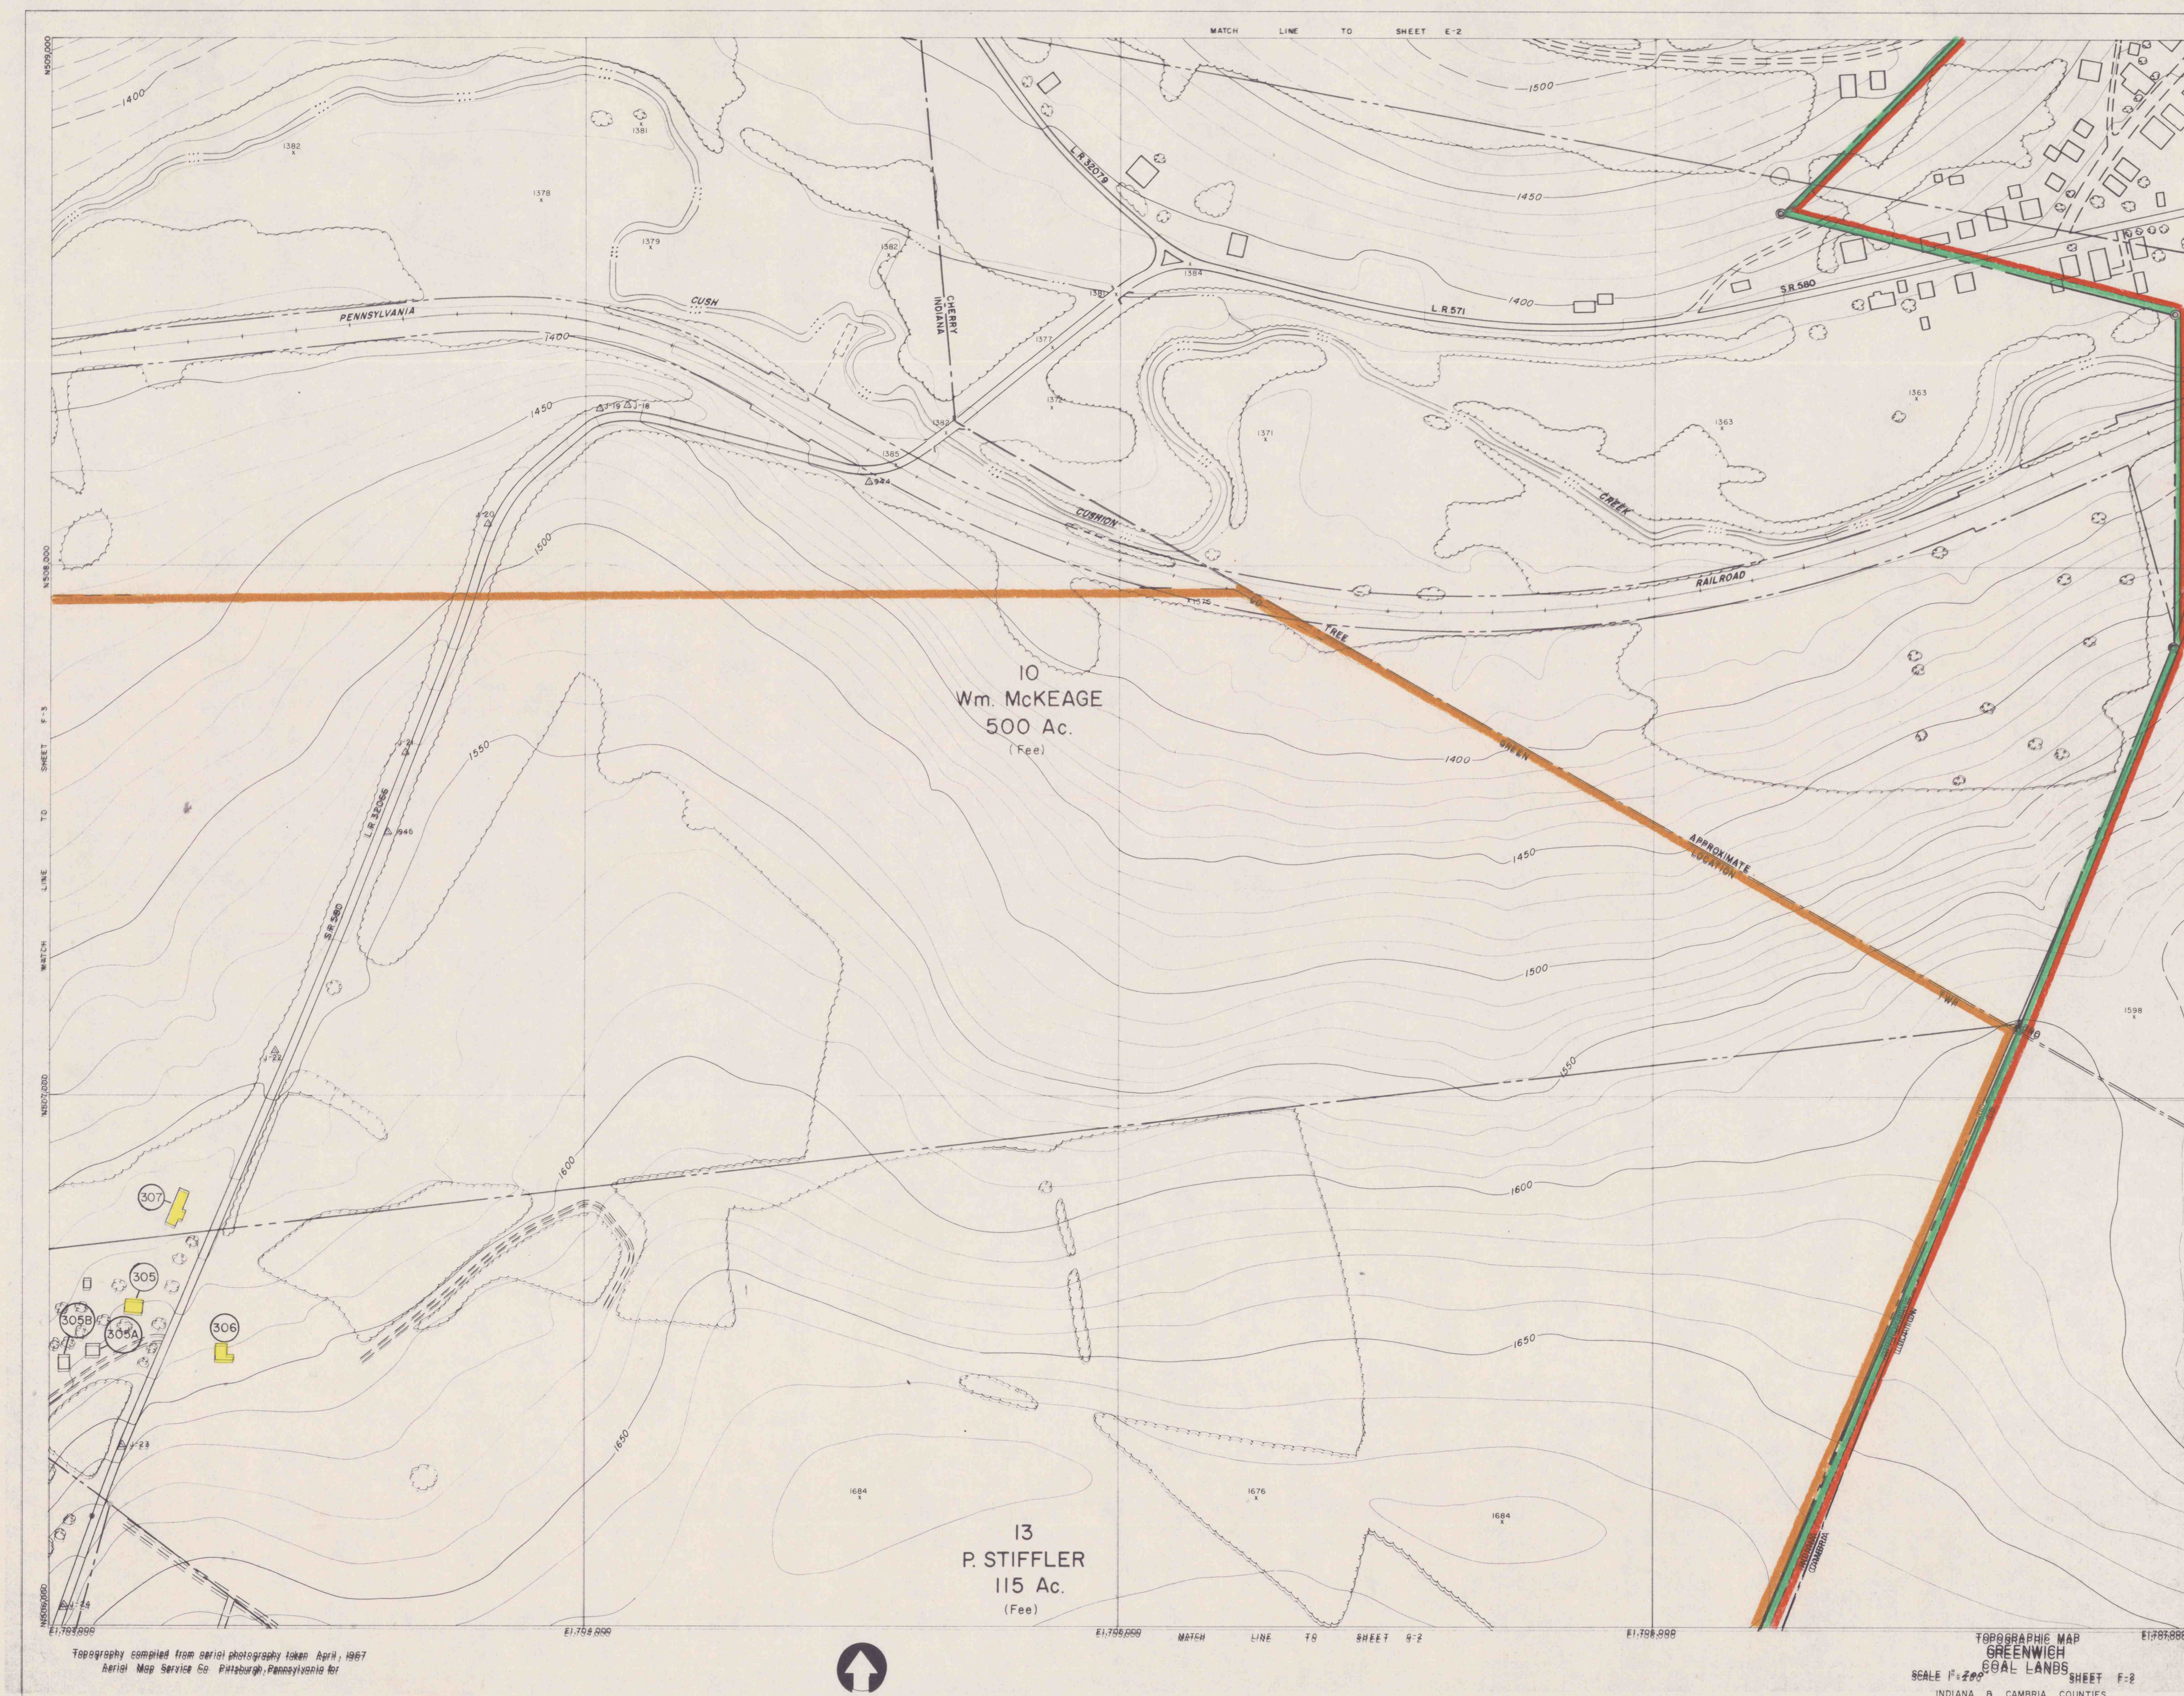

RECEIVED
DIVISION OF MINE
SUBSIDENCE REGULATION
APR 19 1974
McMURRAY
PENNSYLVANIA

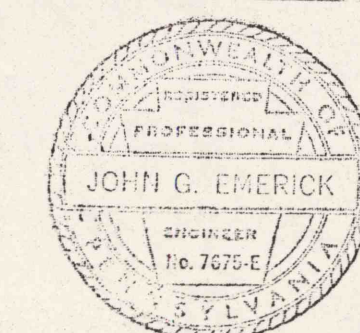

John G. Emerick

GREENWICH COLLIERIES CO.
NO'S 1 AND 2 MINES

GREEN TWP INDIANA COUNTY, PA
SCALE 1"=200' SURVEY DATE 4-1-74

PROTECTED STRUCTURES
MINING COMPLETED AREA
BOUNDARY OF MINE
6 MONTH MINE OUTLINE
OUTCROP OF "D" SEAM
MINING LIMITS
PERIOD COVERED

4-1-74 TO 10-1-74

APRIL 74 F-2