
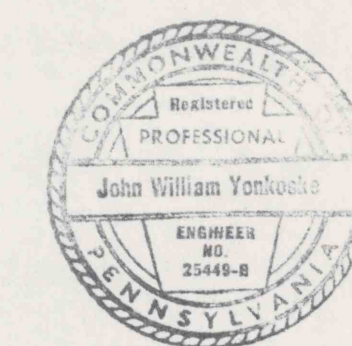


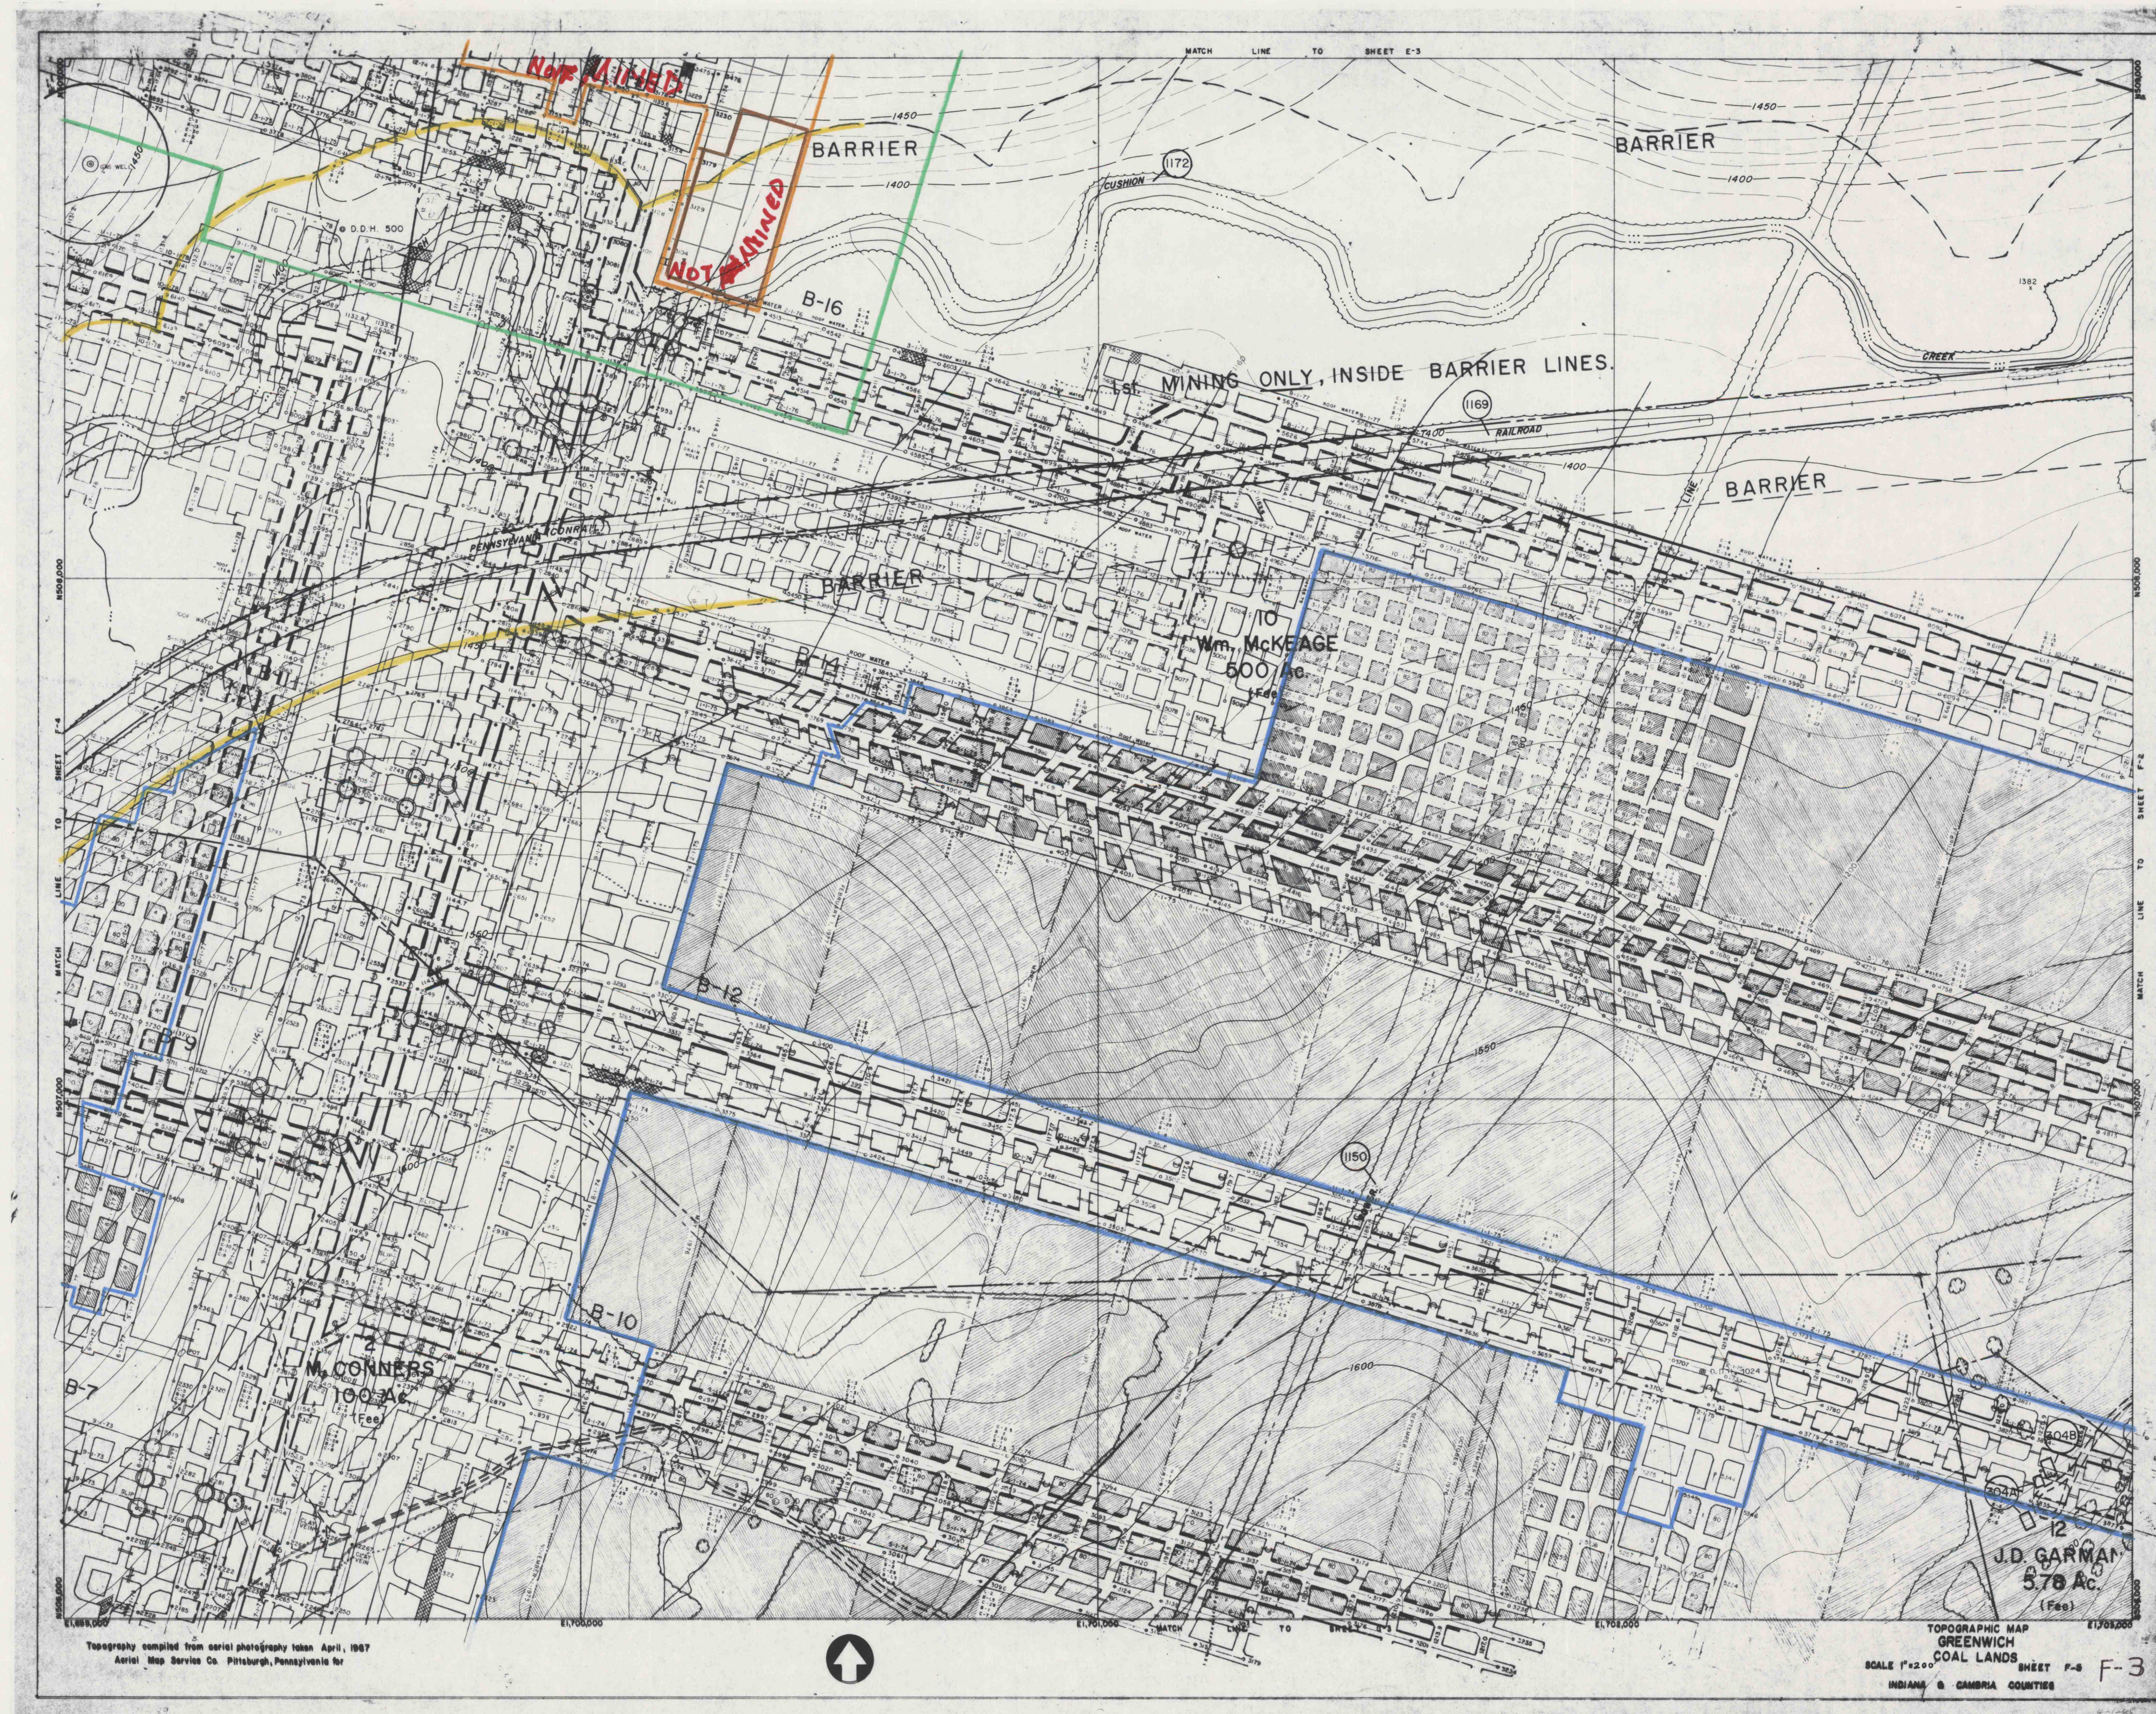


GREENWICH COLLIERIES
NO'S 1 AND 2 MINES
DIV. OF PENNSYLVANIA MINES CORP.
LOWER FREEPORT "D" SEAM

GREEN & MONTGOMERY TWPS. INDIANA COUNTY, PA.
SCALE 1"=200' SURVEY DATE 4-1-85
PERIOD COVERED ~~4-1-85~~ **No MINING** 4-1-85 TO 10-1-85
DWELLINGS & CEMETERIES (IN PLACE BEFORE 1966 ACT) ■
PUBLIC BUILDINGS; IMPOUNDMENTS (PLUS 20 AC. FEET) ■
BOUNDARY OF MINE —
POLITICAL SUBDIVISION BOUNDARIES —
SIX MONTH MINE OUTLINE **No MINING** —
MINING LIMITS —
MINING COMPLETED AREA; PILLARS EXTRACTED —
CALCULATED SUPPORT AREA —
COAL PILLAR SUPPORT AREA —
OUTCROP OF "D" SEAM —
FEATURE IDENTIFICATION NO. 1
MINING WILL BE ON PROJECTED CENTERLINES AND ENTRY WIDTHS
NOT TO EXCEED 20 FEET IN SUPPORT AREAS.
00.000 AC.
(Fav./Lease)
SURFACE OWNERSHIP (ON TAX ASSESSMENT MAP PRINTS) 00.00 AC.
•

RECEIVED
DIVISION OF MINE
SUBSIDENCE REGISTRATION
MAY 01 1985
McMURRAY, PA