




GREENWICH COLLIERIES NO'S 1 AND 2 MINES DIV. OF PENNSYLVANIA MINES CORP. LOWER FREEPORT "D" SEAM

GREEN & MONTGOMERY TOWNSHIPS, INDIANA COUNTY, PA.
SCALE 1"=200' SURVEY DATE 4-1-88
PERIOD COVERED 4-1-88 TO 10-1-88

- DWELLINGS & CEMETERIES (IN PLACE BEFORE 1966 ACT)
- PUBLIC BUILDINGS; IMPOUNDMENTS (PLUS 20 AC. FEET)
- BOUNDARY OF MINE
- POLITICAL SUBDIVISION BOUNDARIES
- SIX MONTH SUBSIDENCE CONTROL BOUNDARY
- FIVE YEAR SUBSIDENCE CONTROL BOUNDARY
- MINING COMPLETED AREA; PILLARS EXTRACTED
- CALCULATED SUPPORT AREA
- COAL PILLAR SUPPORT AREA
- OUTCROP OF "D" SEAM
- FEATURE IDENTIFICATION NO.
- MINING WILL BE ON PROJECTED CENTERLINES AND ENTRY WIDTHS
NOT TO EXCEED 20 FEET IN SUPPORT AREAS.
- MINERAL OWNERSHIP
- SURFACE OWNERSHIP (ON PROPERTY MAP PRINTS)

RECEIVED
MAY 02 1988
Dept. of Environmental Resources
McMurry District Office

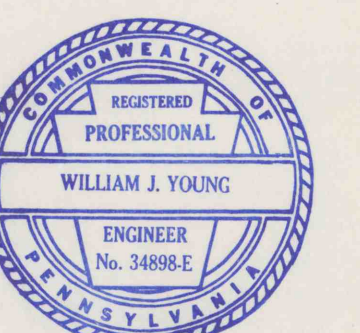

William J. Young