
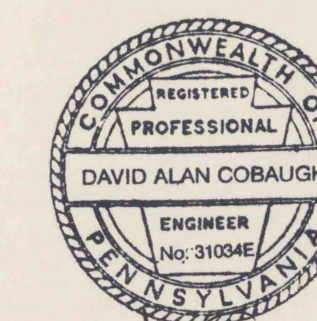


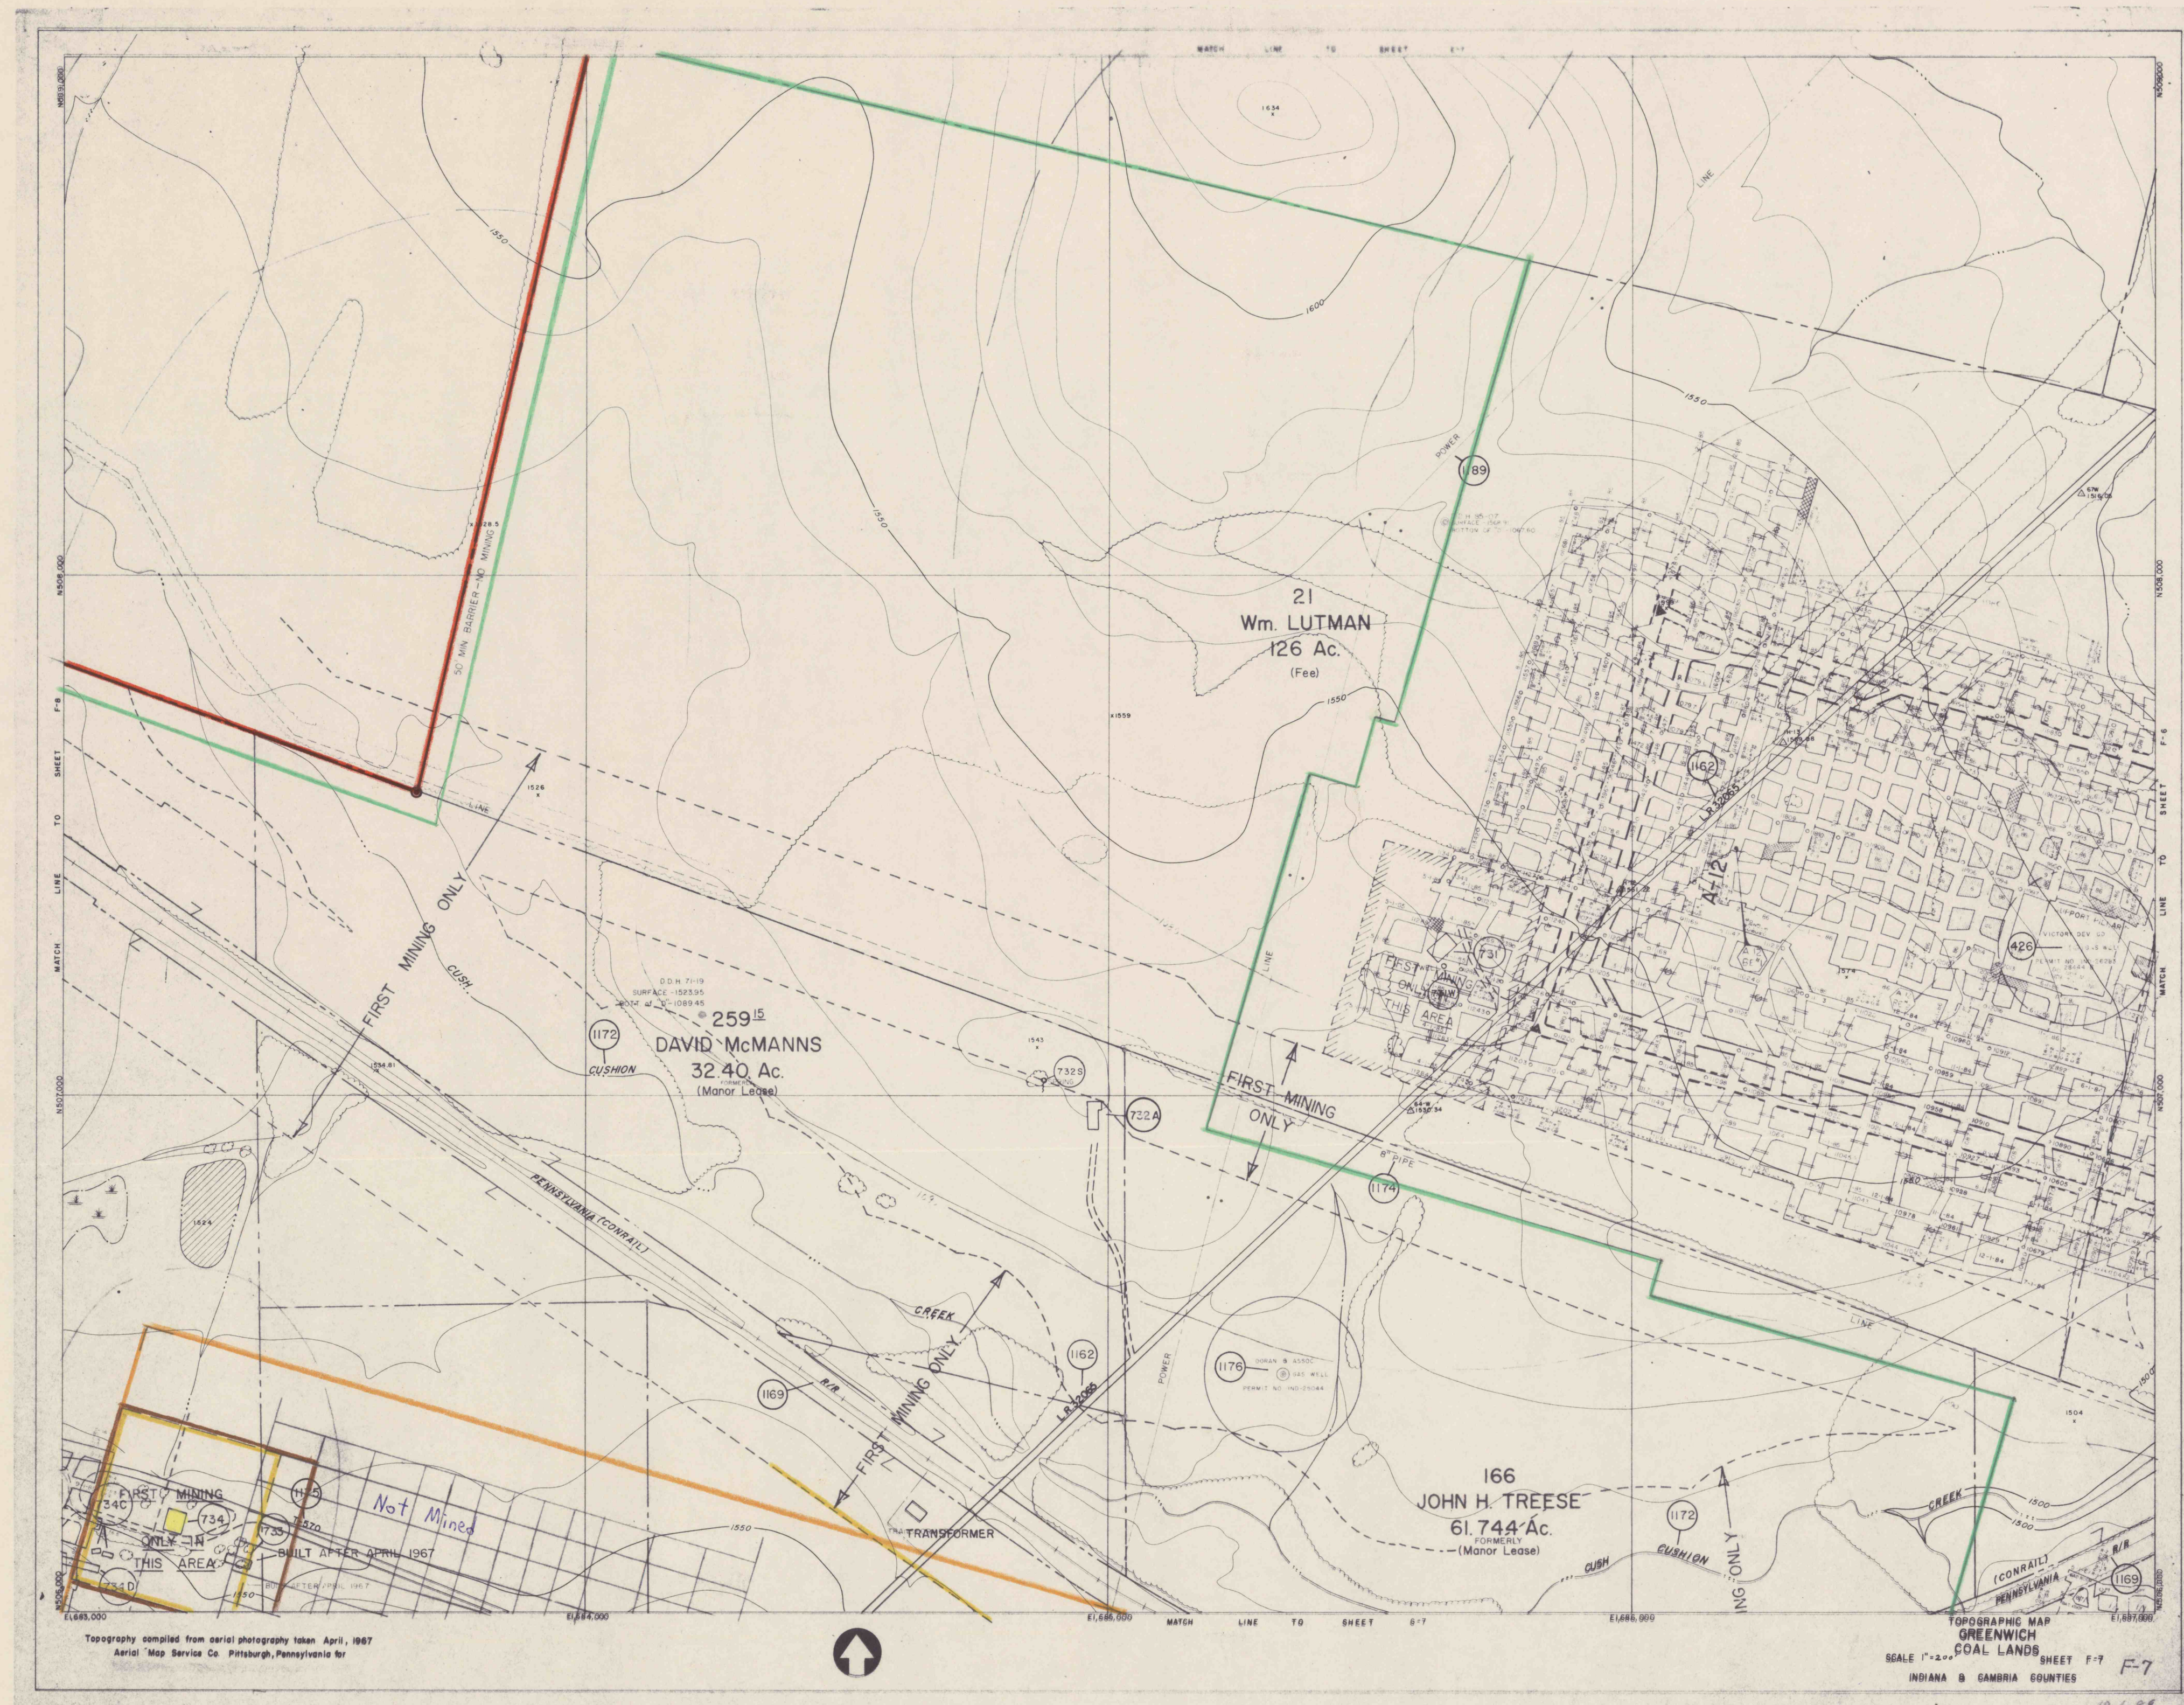

David A. Coblough

RECEIVED

OCT 29 1991

Dept. of Environmental Resources
McMurray District Office

GREENWICH COLLIERIES NO'S 1 AND 2 MINES DIV. OF PENNSYLVANIA MINES CORP.

LOWER FREEPORT "D" SEAM

GREEN & MONTGOMERY TOWNSHIPS, INDIANA COUNTY, PA.

SCALE 1"=200' SURVEY DATE 10-1-91

PERIOD COVERED 10-1-91 TO 4-1-92

No mining on this sheet during this period.

DWELLINGS & CEMETERIES (IN PLACE BEFORE 1966 ACT)

PUBLIC BUILDINGS; IMPOUNDMENTS (PLUS 20 AC. FEET)

BOUNDARY OF MINE

POLITICAL SUBDIVISION BOUNDARIES

SIX MONTH SUBSIDENCE CONTROL BOUNDARY

FIVE YEAR SUBSIDENCE CONTROL BOUNDARY

MINING COMPLETED AREA; PILLARS EXTRACTED

CALCULATED SUPPORT AREA

COAL PILLAR SUPPORT AREA

OUTCROP OF "D" SEAM

FEATURE IDENTIFICATION NO.

MINING IN SUPPORT AREAS WILL BE ON PROJECTED CENTERLINES WITH ENTRY WIDTHS NOT TO EXCEED 20 FEET EXCEPT IN COMBINATION BELT/TRACK ENTRIES WITH ENTRY WIDTH NOT TO EXCEED 22 FEET

MINERAL OWNERSHIP

SURFACE OWNERSHIP (ON PROPERTY MAP PRINTS)

JOHN DOE
00.000 AC.
(Fee/Lease)

01-1-01