
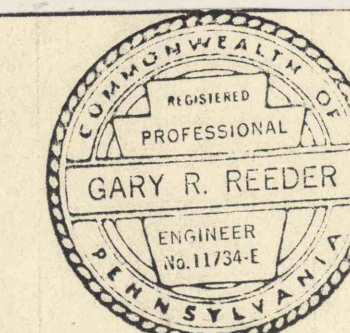


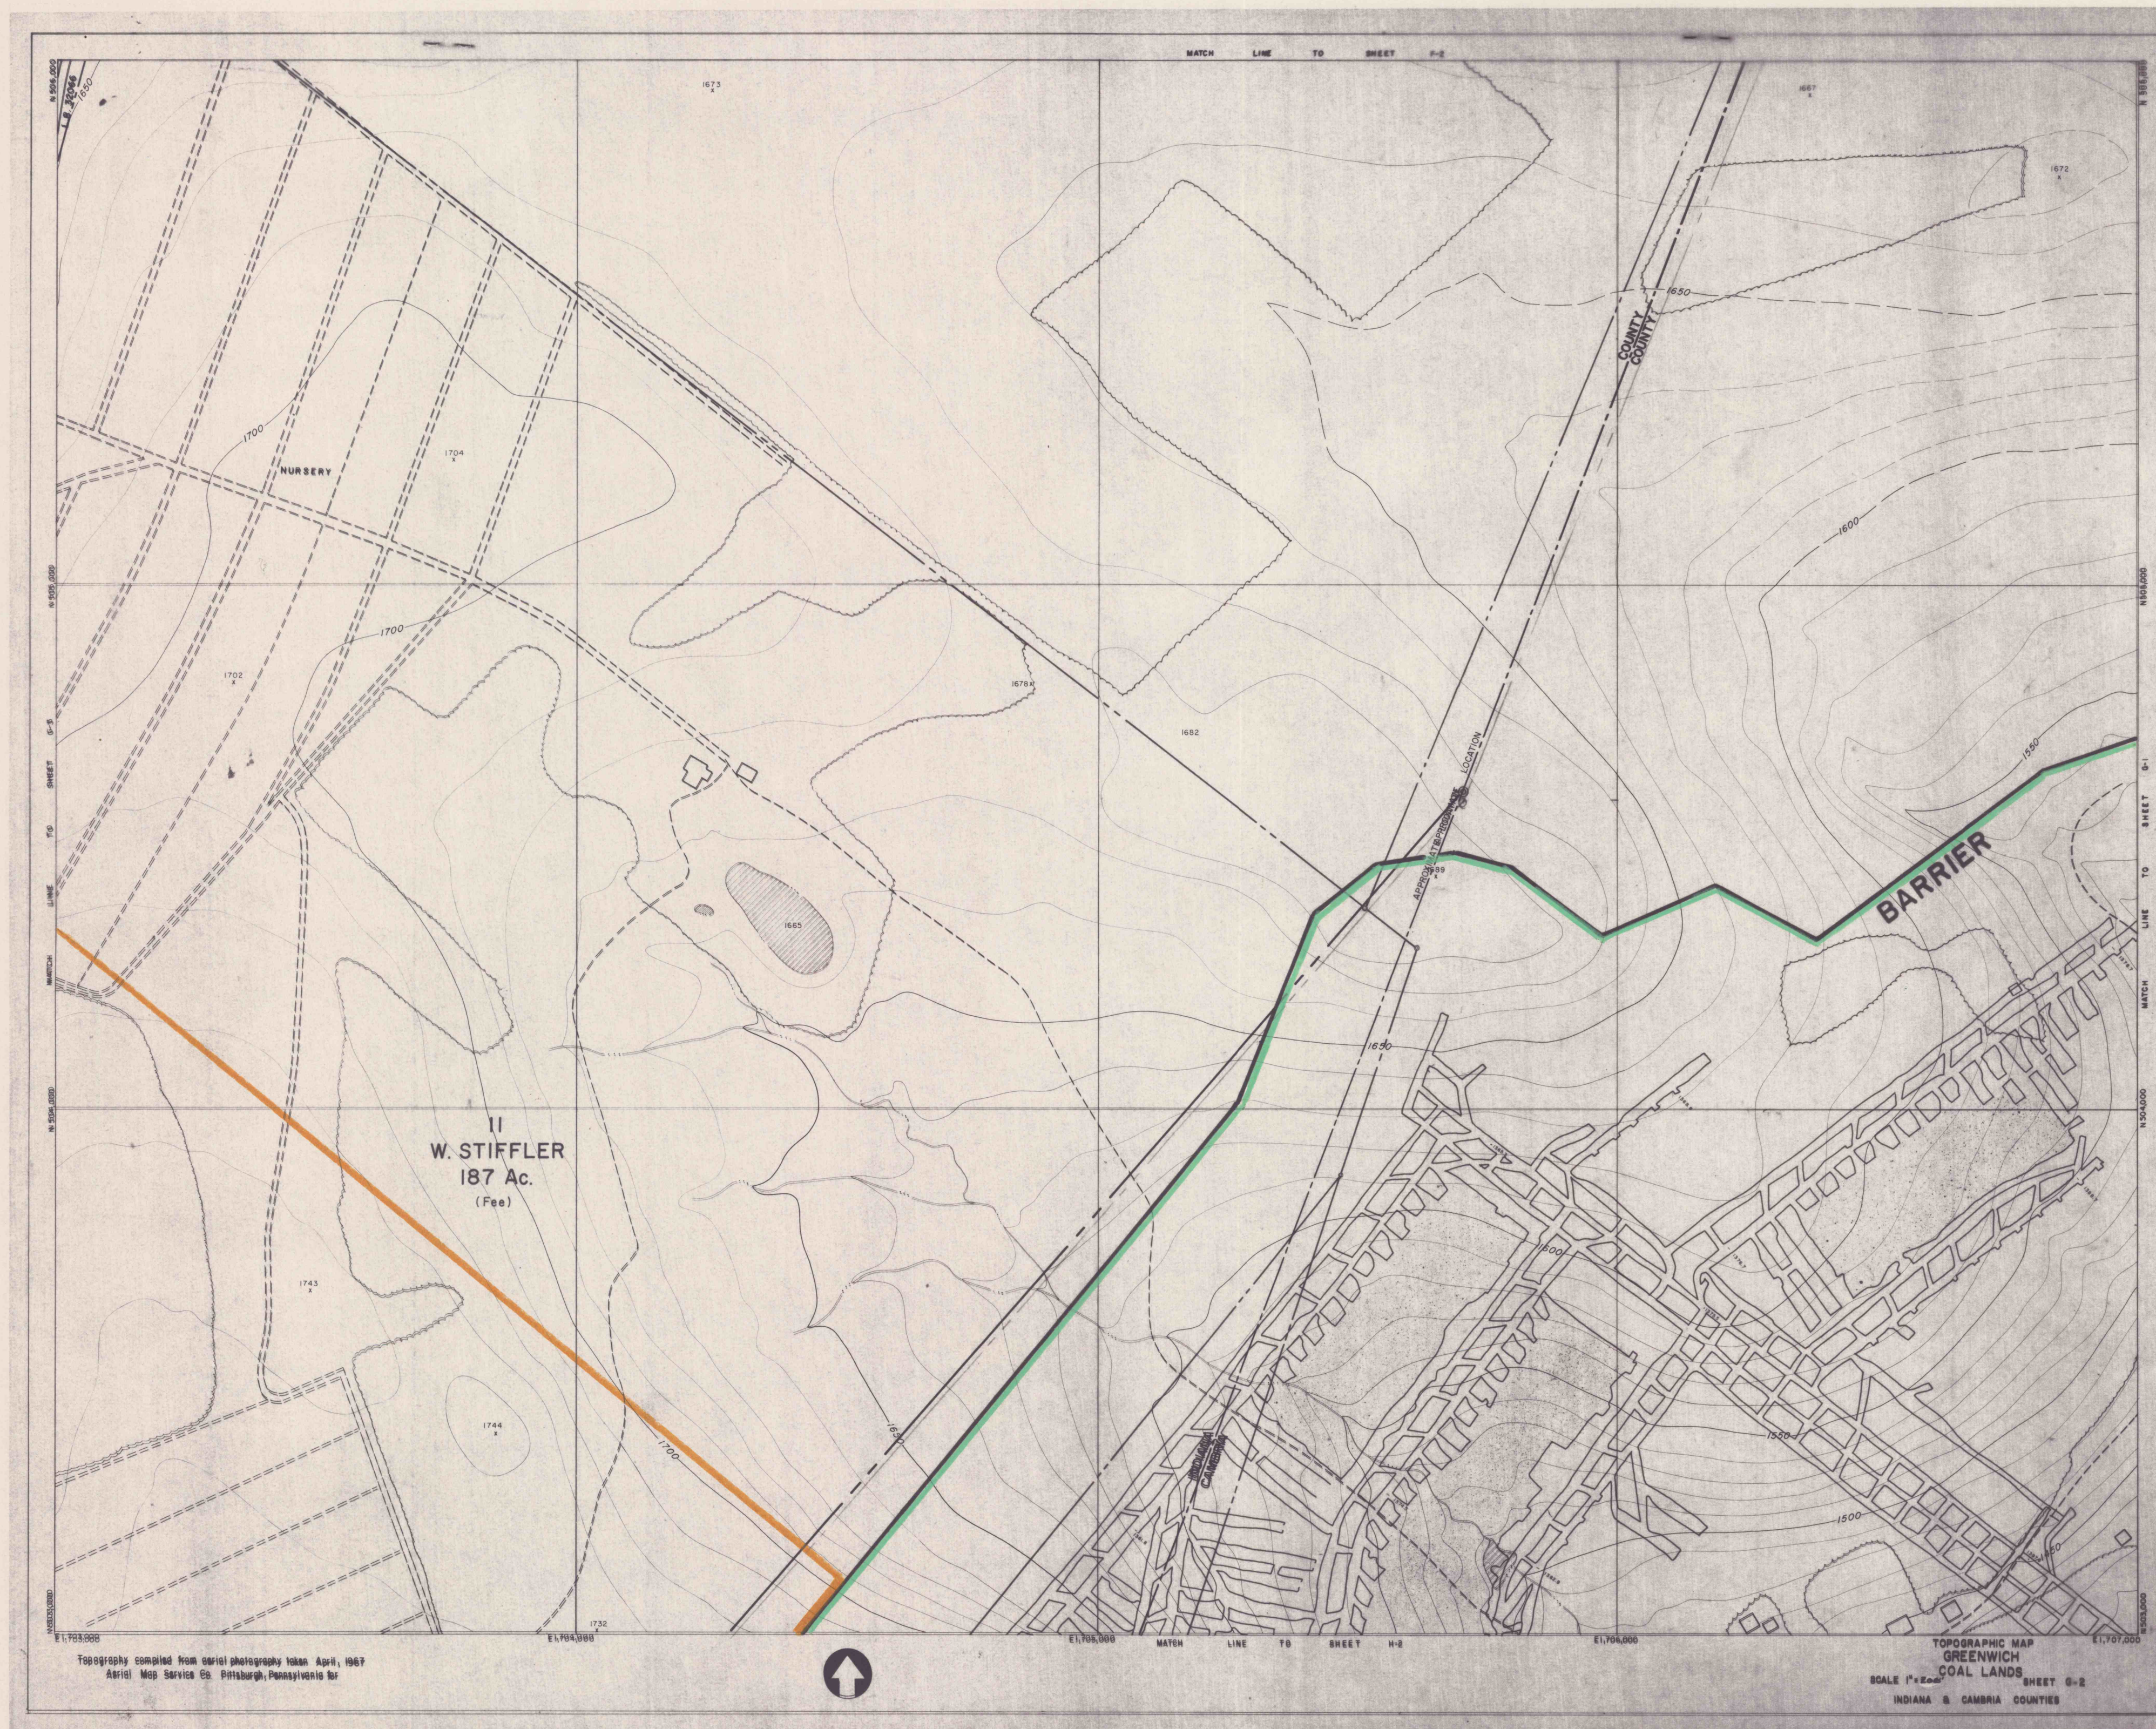

Gary R. Reeder

**GREENWICH COLLIERIES CO.
NO'S 1 AND 2 MINES**

GREEN TWP INDIANA COUNTY, PA.
SCALE 1"=200' SURVEY DATE 10-1-72

PROTECTED STRUCTURES
MINING COMPLETED AREA
BOUNDARY OF MINE
6 MONTH MINE OUTLINE
OUTCROP OF "D" SEAM
MINING LIMITS
PERIOD COVERED 10-1-72 TO 4-1-73



RECEIVED
DIVISION OF MINE
SUBSIDENCE REGULATION
NOV 3 1972
McMURRAY
PENNSYLVANIA

NOV. 72

G-2

Not Latest Map