




RECEIVED
APR 29 1992

Dept. of Environmental Resources
McMurray District Office

4-24-92

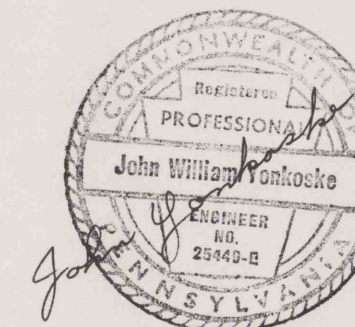

GREENWICH COLLIERIES
NO'S 1 AND 2 MINES
DIV. OF PENNSYLVANIA MINES CORP.

LOWER FREEPORT "D" SEAM

GREEN & MONTGOMERY TOWNSHIPS, INDIANA COUNTY, PA.

SCALE 1"=200' FINAL SURVEY DATE 3-28-92

- DWELLINGS & CEMETERIES (IN PLACE BEFORE 1966 ACT) ■
- PUBLIC BUILDINGS; IMPOUNDMENTS (PLUS 20 AC. FEET) ■
- BOUNDARY OF MINE ■
- POLITICAL SUBDIVISION BOUNDARIES ■
- SIX MONTH SUBSIDENCE CONTROL BOUNDARY —
- FIVE YEAR SUBSIDENCE CONTROL BOUNDARY —
- PILLARS EXTRACTED ▨
- CALCULATED SUPPORT AREA ▨
- COAL PILLAR SUPPORT AREA ▨
- OUTCROP OF "D" SEAM ▨

FEATURE IDENTIFICATION NO. 1

MINING IN SUPPORT AREAS WILL BE ON PROJECTED CENTERLINES WITH ENTRY WIDTHS NOT TO EXCEED 20 FEET EXCEPT IN COMBINATION BELT/TRACK ENTRIES WITH ENTRY WIDTH NOT TO EXCEED 22 FEET

MINERAL OWNERSHIP

SURFACE OWNERSHIP (ON PROPERTY MAP PRINTS)

JOHN DOE
00.000 Ac.
(Free Lease)

01-1-91