

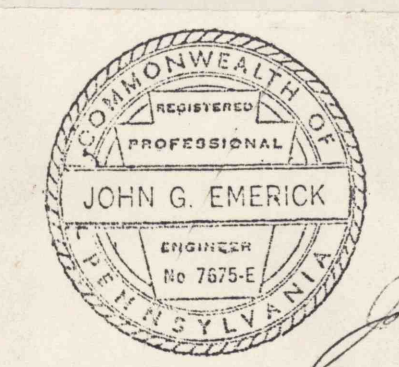


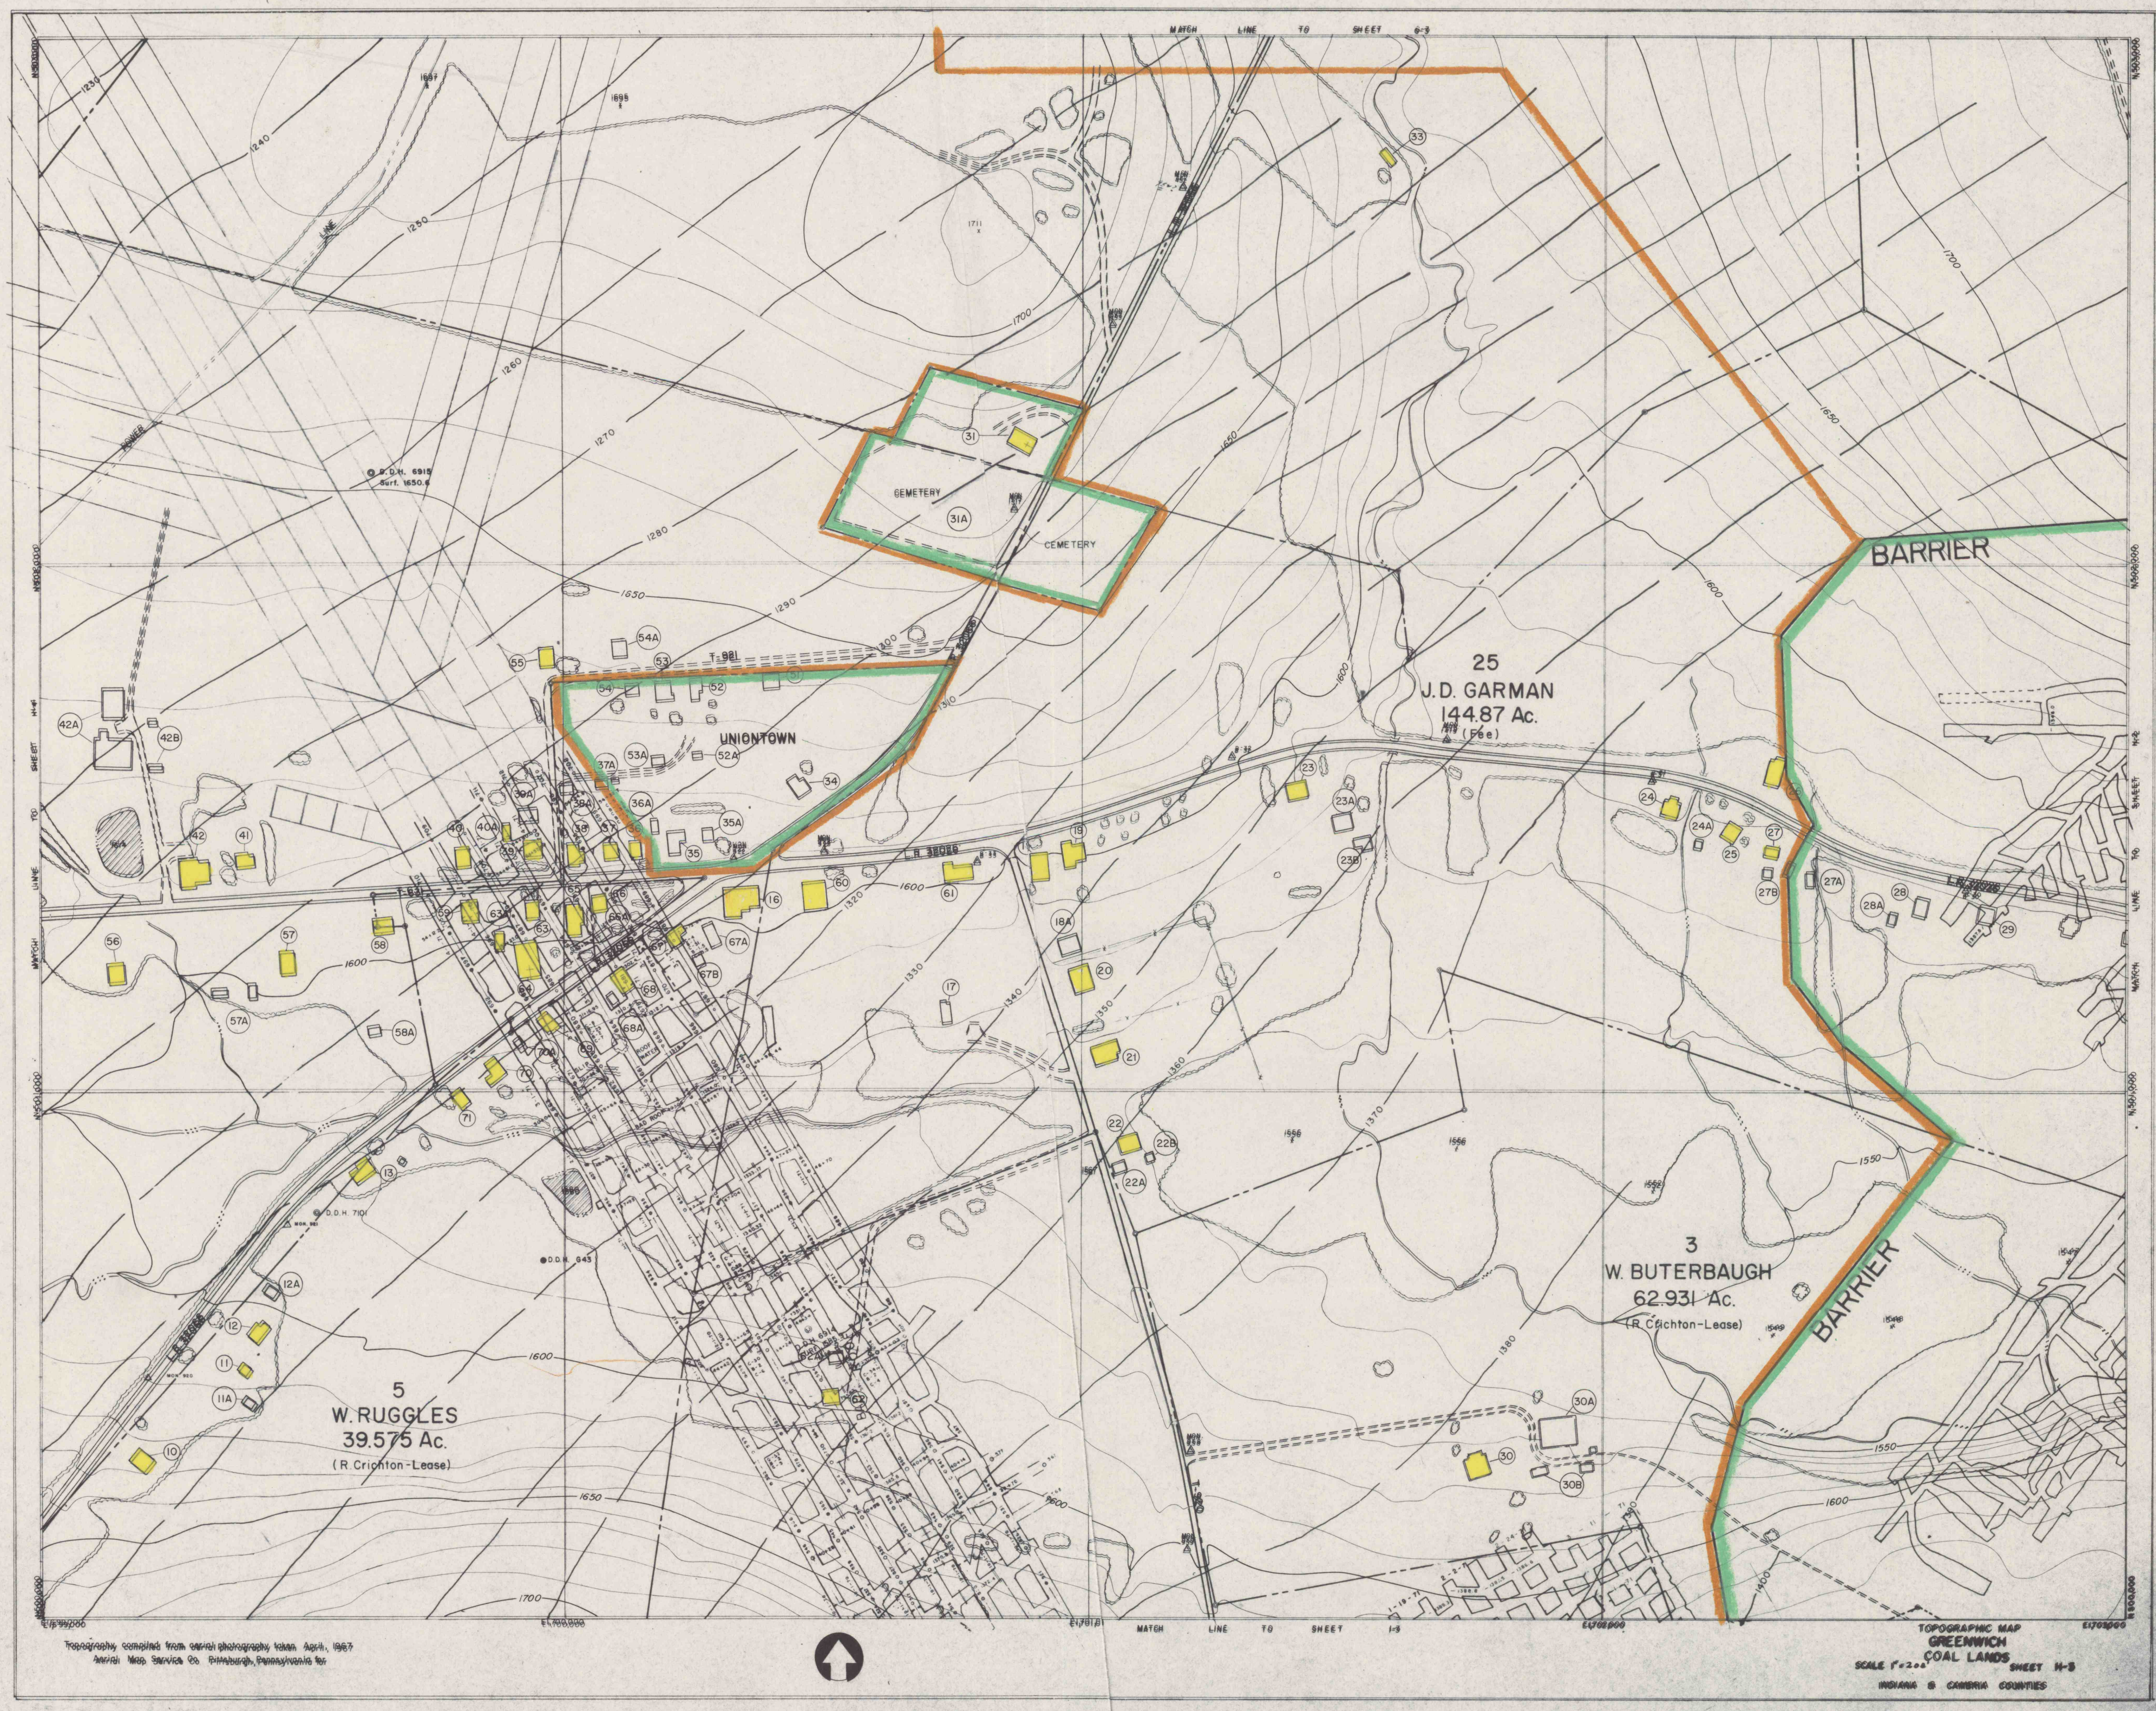

John G. Emerick
GREENWICH COLLIERIES CO.
NO'S 1 AND 2 MINES

GREEN TWP INDIANA COUNTY, PA.
SCALE 1"=200' SURVEY DATE 4-1-71

PROTECTED STRUCTURES
MINING COMPLETED AREA
BOUNDARY OF MINE
6 MONTH MINE OUTLINE
OUTCROP OF "D" SEAM
MINING LIMITS
PERIOD COVERED

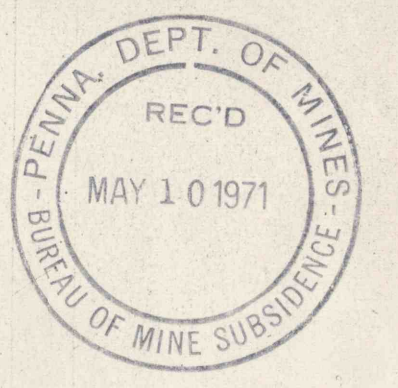

-
-
-
-
-

4-1-71 TO 10-1-71

Not Latest Map
May 71
H-3