
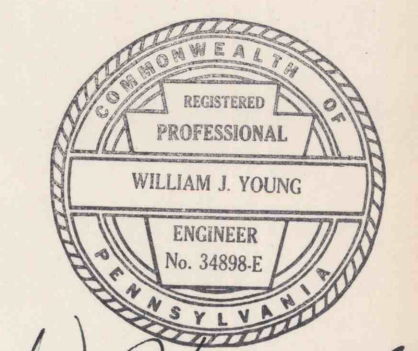


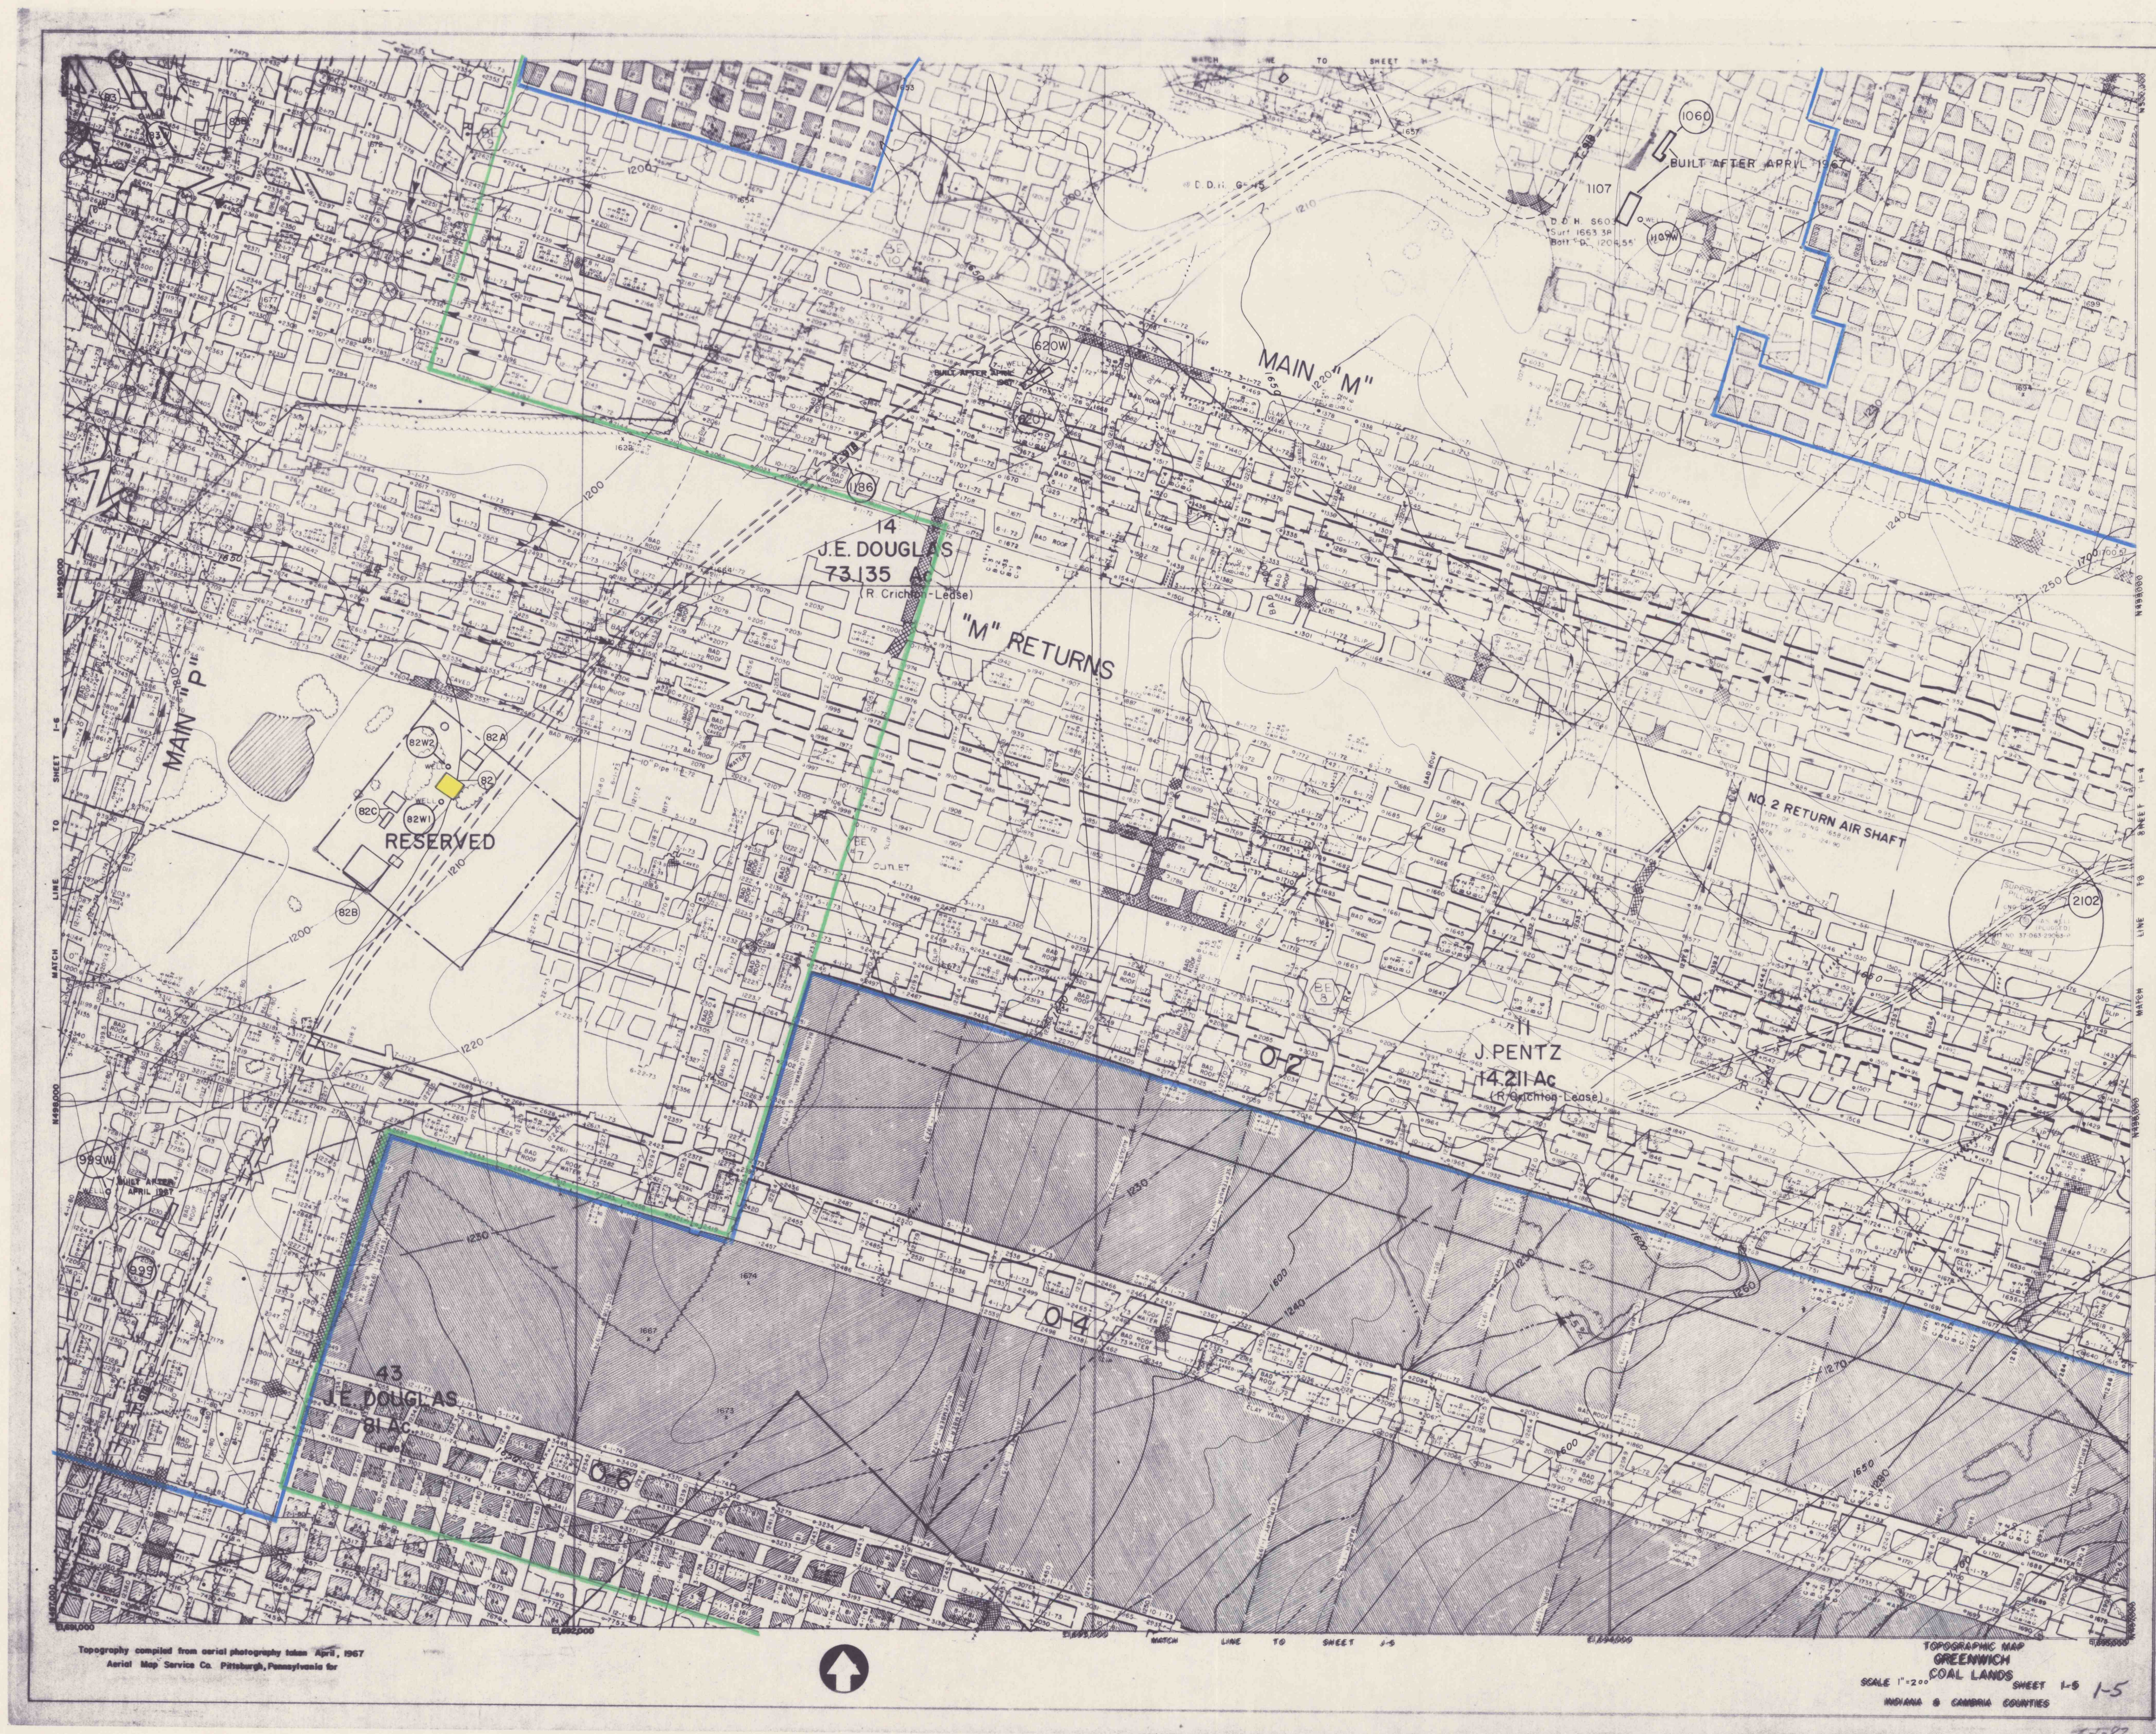

W. J. Young, Division Engineer
Rochester & Pittsburgh Coal Co.,
Agent for PA Mines Corporation