


$\frac{40 \times 45}{60 \times 65} = 46\%$
 $\frac{40 \times 65}{60 \times 85} = 51\%$

Not
Pillars

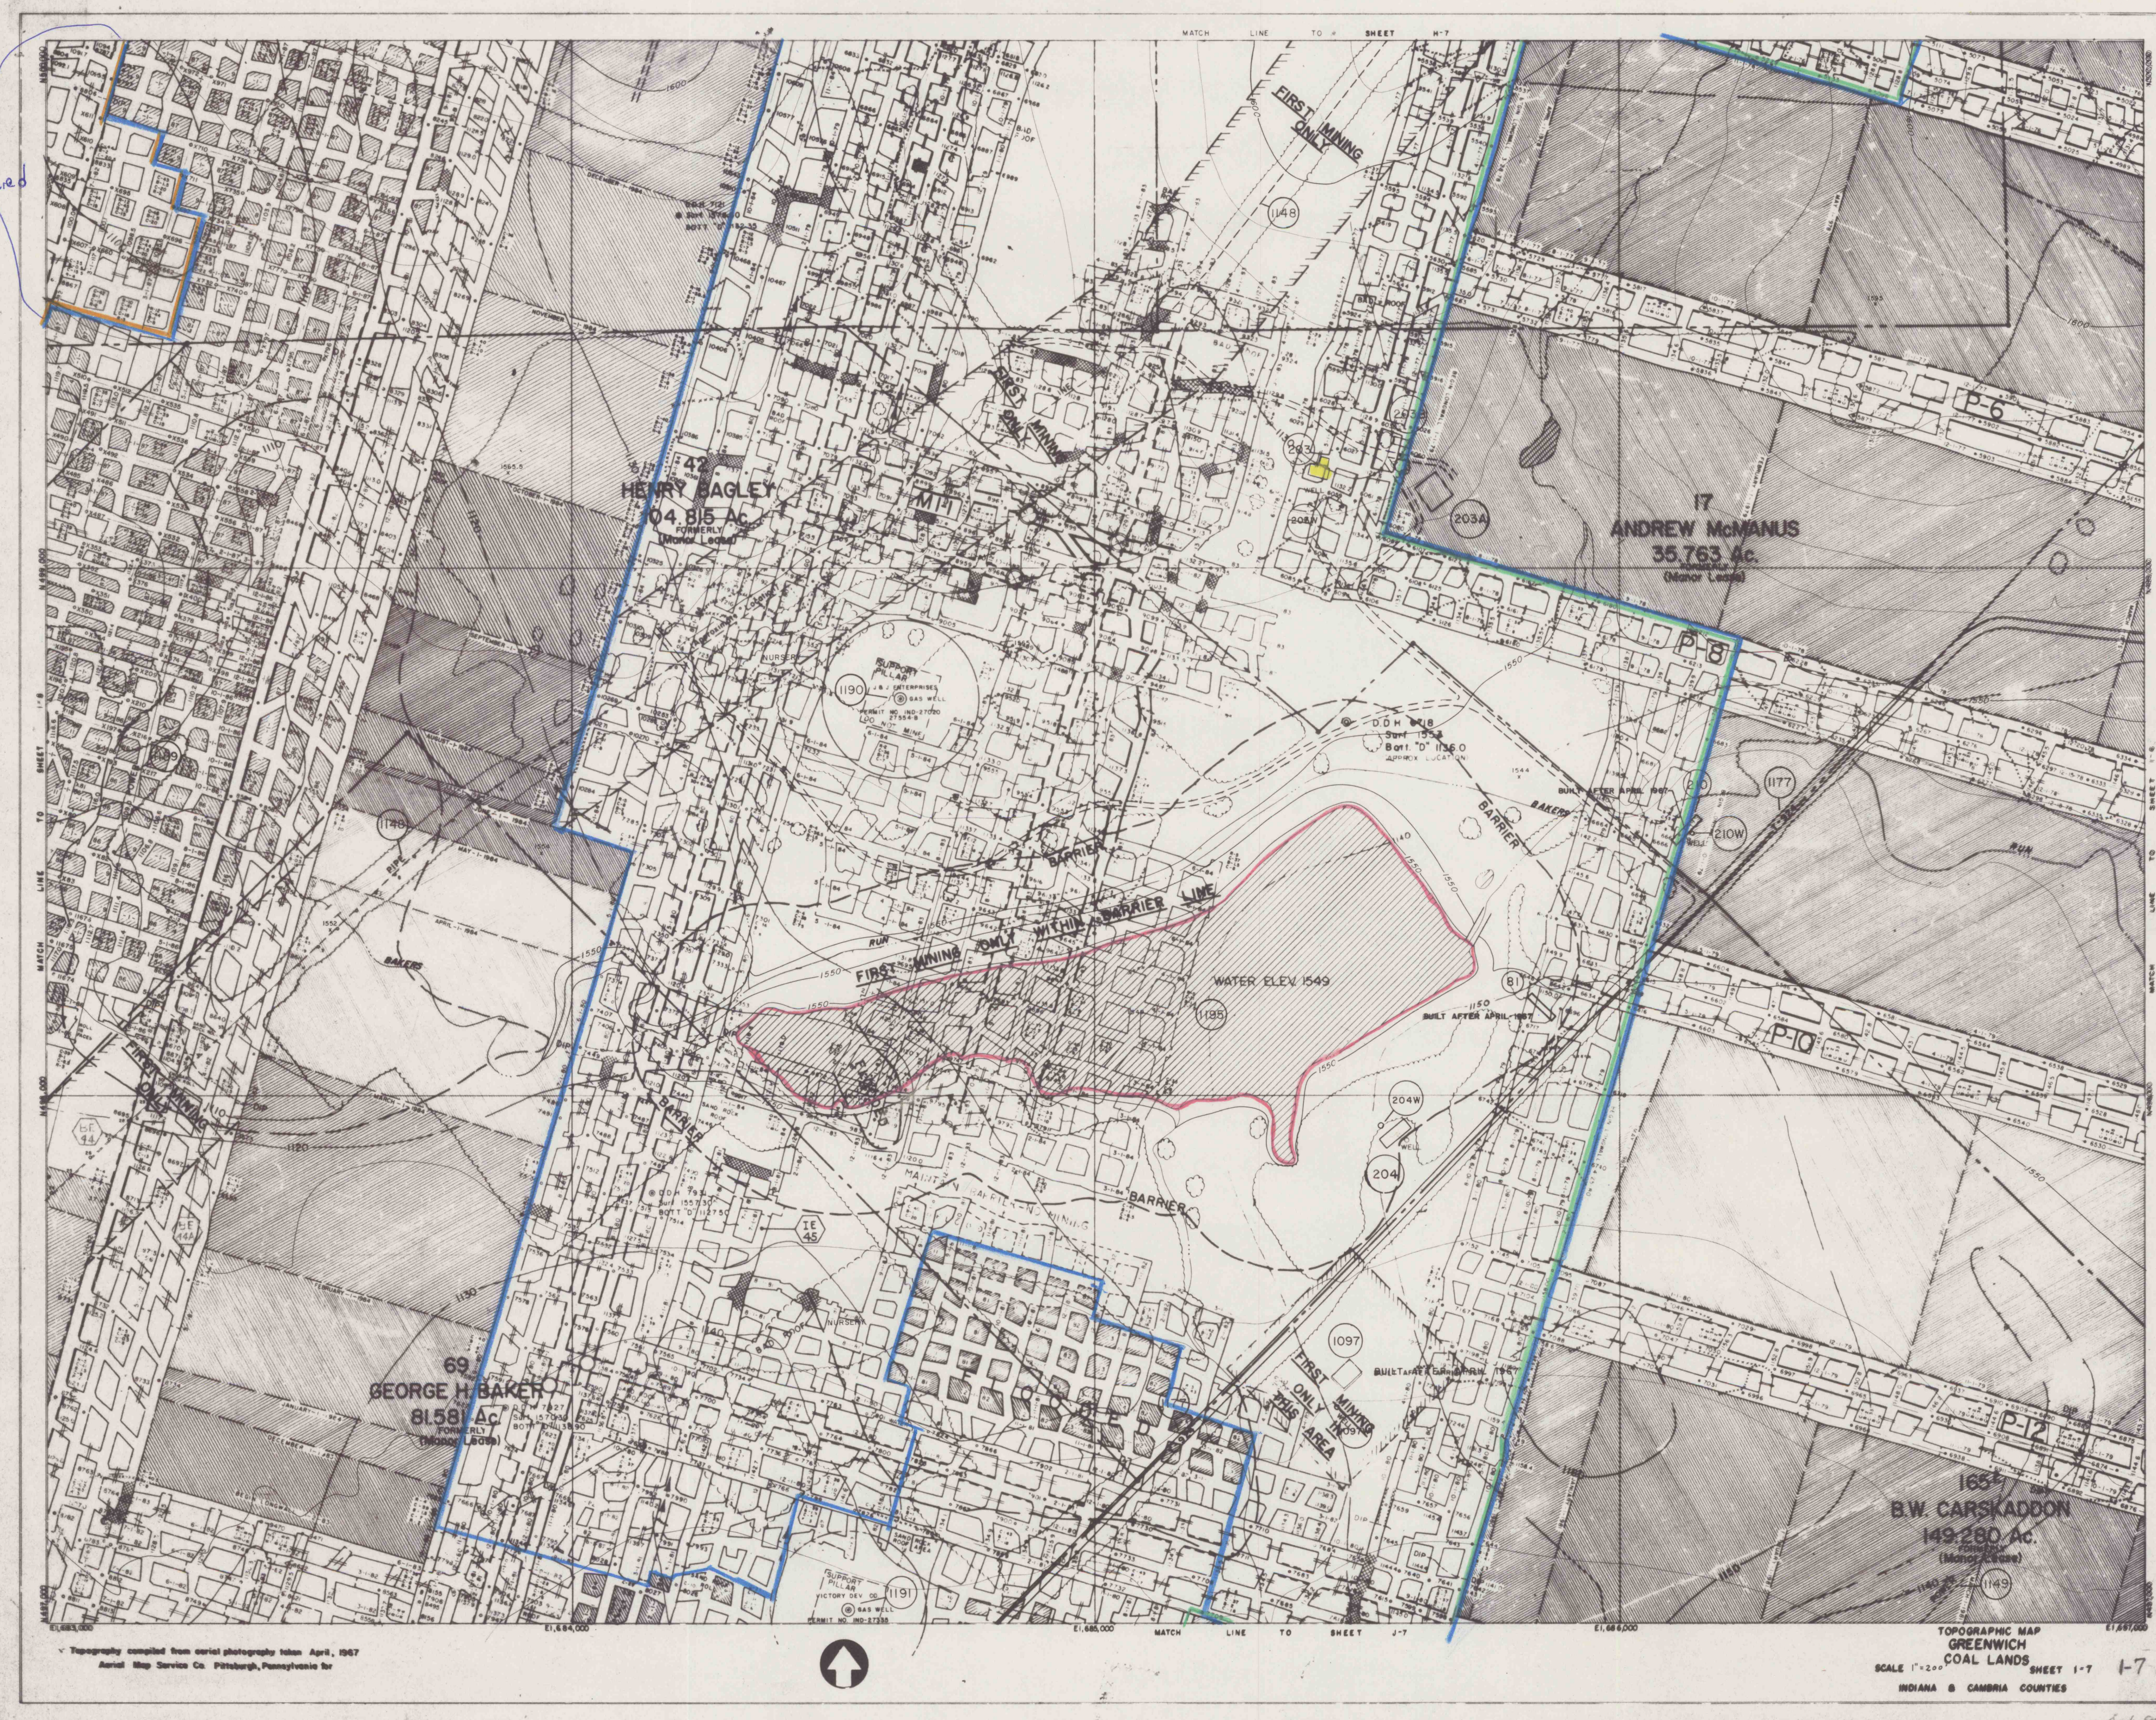

GREENWICH COLLIERIES **NO'S 1 AND 2 MINES** **DIV. OF PENNSYLVANIA MINES CORP.**

LOWER FREEPORT "D" SEAM
 GREEN & MONTGOMERY TWPS. INDIANA COUNTY, PA.
 SCALE 1"=200' SURVEY DATE 4-1-88
 PERIOD COVERED 4-1-88 TO 10-1-88
 DWELLINGS & CEMETERIES (IN PLACE BEFORE 1966 ACT) ■
 PUBLIC BUILDINGS; IMPOUNDMENTS (PLUS 20 AC. FEET) ■
 BOUNDARY OF MINE ■
 POLITICAL SUBDIVISION BOUNDARIES ■
 SIX MONTH SUBSIDENCE CONTROL BOUNDARY ■
 FIVE YEAR SUBSIDENCE CONTROL BOUNDARY ■
 MINING COMPLETED AREA; PILLARS EXTRACTED ▨
 CALCULATED SUPPORT AREA ▨
 COAL PILLAR SUPPORT AREA ▨
 OUTCROP OF "D" SEAM ■
 FEATURE IDENTIFICATION NO. 1
 MINING WILL BE ON PROJECTED CENTERLINES AND ENTRY WIDTHS NOT TO EXCEED 20 FEET IN SUPPORT AREAS.

RECEIVED
 MAY 02 1988
 Dept. of Environmental Resources
 Harrisburg District Office

REGISTERED
 PROFESSIONAL
 WILLIAM J. YOUNG
 ENGINEER
 No. 34886-E
William J. Young