


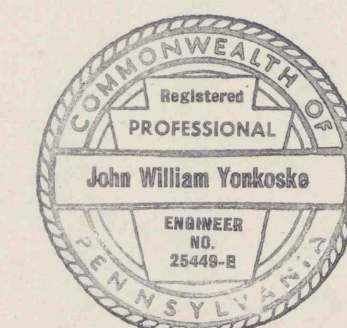

John W. Yonkosko
10/31/86

GREENWICH COLLIERIES NO'S 1 AND 2 MINES DIV. OF PENNSYLVANIA MINES CORP.

LOWER FREEPORT "D" SEAM

GREEN & MONTGOMERY TOWNSHIPS. INDIANA COUNTY, PA.

SCALE 1"=200'

SURVEY DATE 10-1-86

PERIOD COVERED 10-1-86 TO 4-1-87

DWELLINGS & CEMETERIES (IN PLACE BEFORE 1966 ACT)

PUBLIC BUILDINGS; IMPOUNDMENTS (PLUS 20 AC. FEET)

BOUNDARY OF MINE

POLITICAL SUBDIVISION BOUNDARIES

SIX MONTH SUBSIDENCE CONTROL BOUNDARY

MINING LIMITS

MINING COMPLETED AREA; PILLARS EXTRACTED

CALCULATED SUPPORT AREA

COAL PILLAR SUPPORT AREA

OUTCROP OF "D" SEAM

FEATURE IDENTIFICATION NO.

MINING WILL BE ON PROJECTED CENTERLINES AND ENTRY WIDTHS

NOT TO EXCEED 20 FEET IN SUPPORT AREAS.

MINERAL OWNERSHIP

SURFACE OWNERSHIP (ON PROPERTY MAP PRINTS)

JOHN DOE
20,000 Ac.
(FARM LEASE)

01-1-01

RECEIVED
NOV 03 1986
Dept. of Environmental Resources
McMurray District Office