



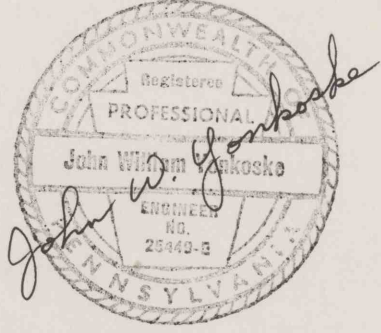

4-24-92

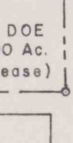

GREENWICH COLLIERIES
NO'S 1 AND 2 MINES
DIV. OF PENNSYLVANIA MINES CORP.
LOWER FREEPORT "D" SEAM
GREEN & MONTGOMERY TWP. INDIANA COUNTY, PA.
SCALE 1"=200' FINAL SURVEY DATE 3-28-92

DWELLINGS & CEMETERIES (IN PLACE BEFORE 1966 ACT)	
PUBLIC BUILDINGS; IMPOUNDMENTS (PLUS 20 AC. FEET)	
BOUNDARY OF MINE	
POLITICAL SUBDIVISION BOUNDARIES	
SIX MONTH SUBSIDENCE CONTROL BOUNDARY	
FIVE YEAR SUBSIDENCE CONTROL BOUNDARY	
PILLARS EXTRACTED	
CALCULATED SUPPORT AREA	
COAL PILLAR SUPPORT AREA	
OUTCROP OF "D" SEAM	
FEATURE IDENTIFICATION NO.	
MINING IN SUPPORT AREAS WILL BE ON PROJECTED CENTERLINES WITH ENTRY WIDTHS NOT TO EXCEED 20 FEET EXCEPT IN COMBINATION BELT/TRACK ENTRIES WITH ENTRY WIDTH NOT TO EXCEED 22 FEET	
MINERAL OWNERSHIP	
SURFACE OWNERSHIP (ON PROPERTY MAP PRINTS)	

RECEIVED
APR 29 1992
Dept. of Environmental Resources
McMurray District Office