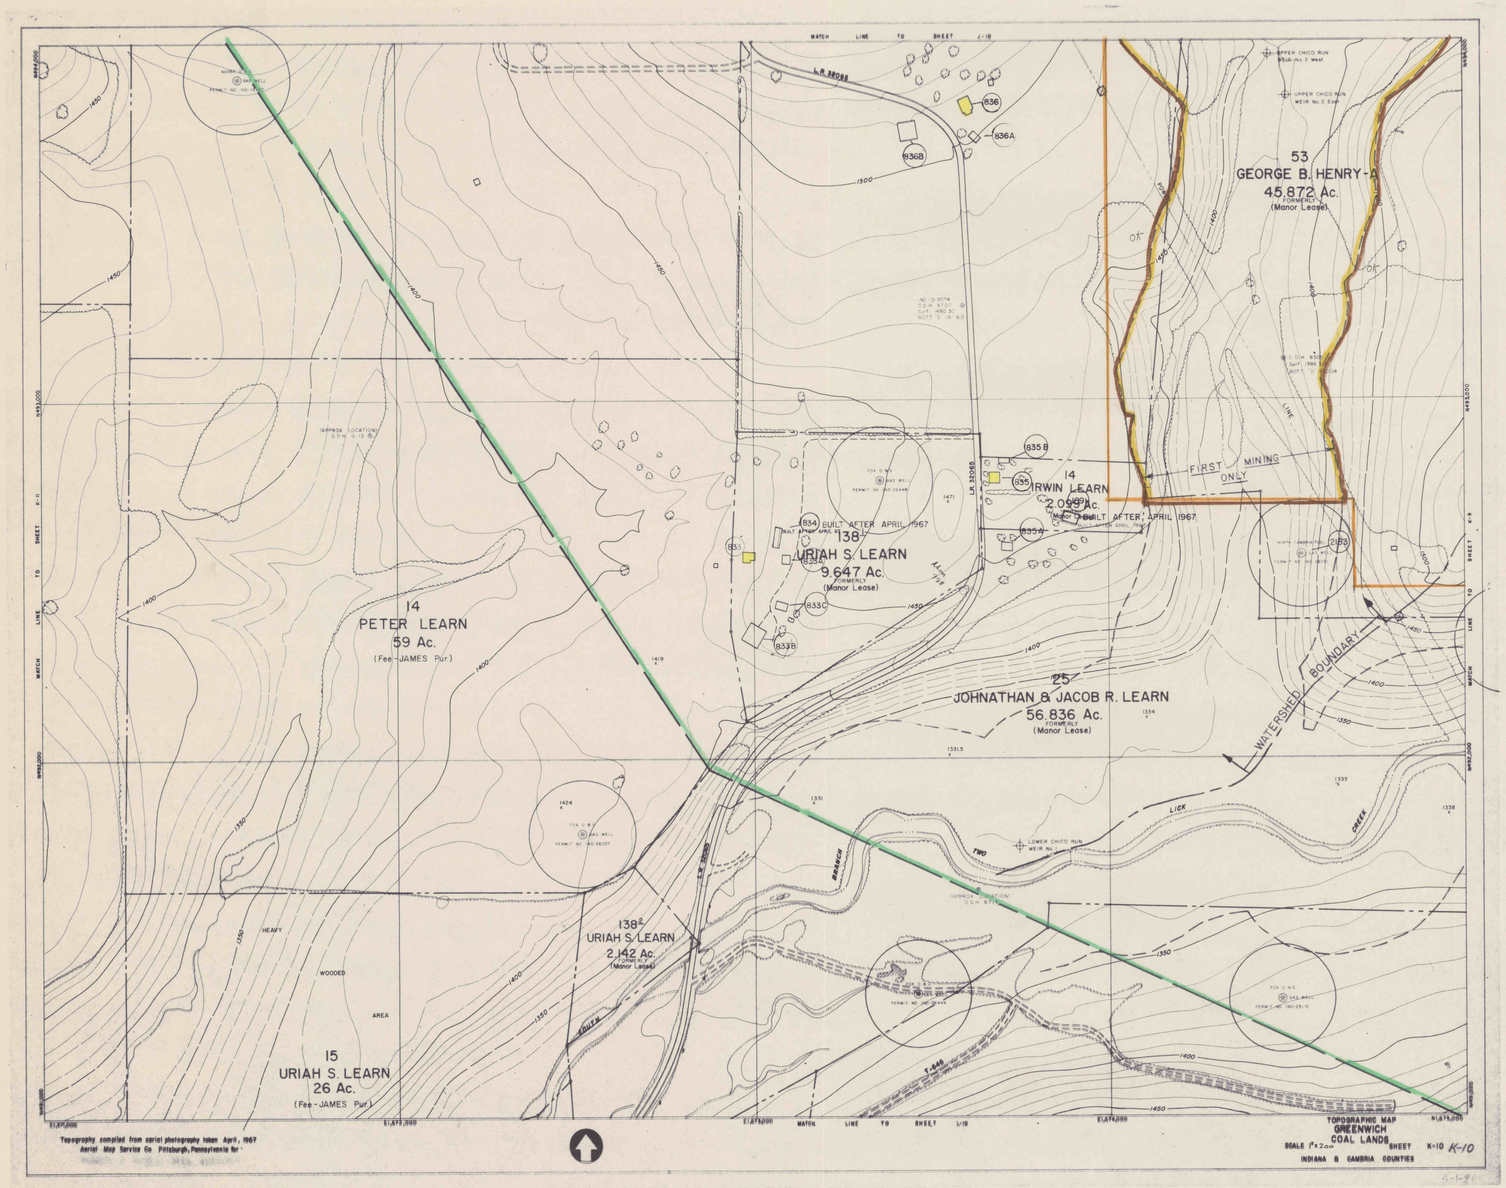

COMMONWEALTH OF PENNSYLVANIA
REGISTERED PROFESSIONAL
DAVID ALAN COBAUGH
ENGINEER
No: 31034E

David A Cobaugh

RECEIVED
OCT 29 1991
Dept. of Environmental Resources
McMurray District Office

GREENWICH COLLIERIES
NO'S 1 AND 2 MINES
DIV. OF PENNSYLVANIA MINES CORP.

LOWER FREEPORT "D" SEAM

GREEN & MONTGOMERY TWPS. INDIANA COUNTY, PA.

SCALE 1" = 200' SURVEY DATE 10-1-91

PERIOD COVERED ———— 10-1-91 TO 4-1-92

DWELLINGS & CEMETERIES (IN PLACE BEFORE 1966 ACT)

PUBLIC BUILDINGS; IMPOUNDMENTS (PLUS 20 AC. FEET)

BOUNDARY OF MINE

POLITICAL SUBDIVISION BOUNDARIES

SIX MONTH SUBSIDENCE CONTROL BOUNDARY

FIVE YEAR SUBSIDENCE CONTROL BOUNDARY

MINING COMPLETED AREA; PILLARS EXTRACTED

CALCULATED SUPPORT AREA

COAL PILLAR SUPPORT AREA

OUTCROP OF "D" SEAM

FEATURE IDENTIFICATION NO. (1)

MINING IN SUPPORT AREAS WILL BE ON PROJECTED CENTERLINES WITH ENTRY WIDTHS NOT TO EXCEED 20 FEET EXCEPT IN COMBINATION BELT/TRACK ENTRIES WITH ENTRY WIDTH NOT TO EXCEED 22 FEET



K10