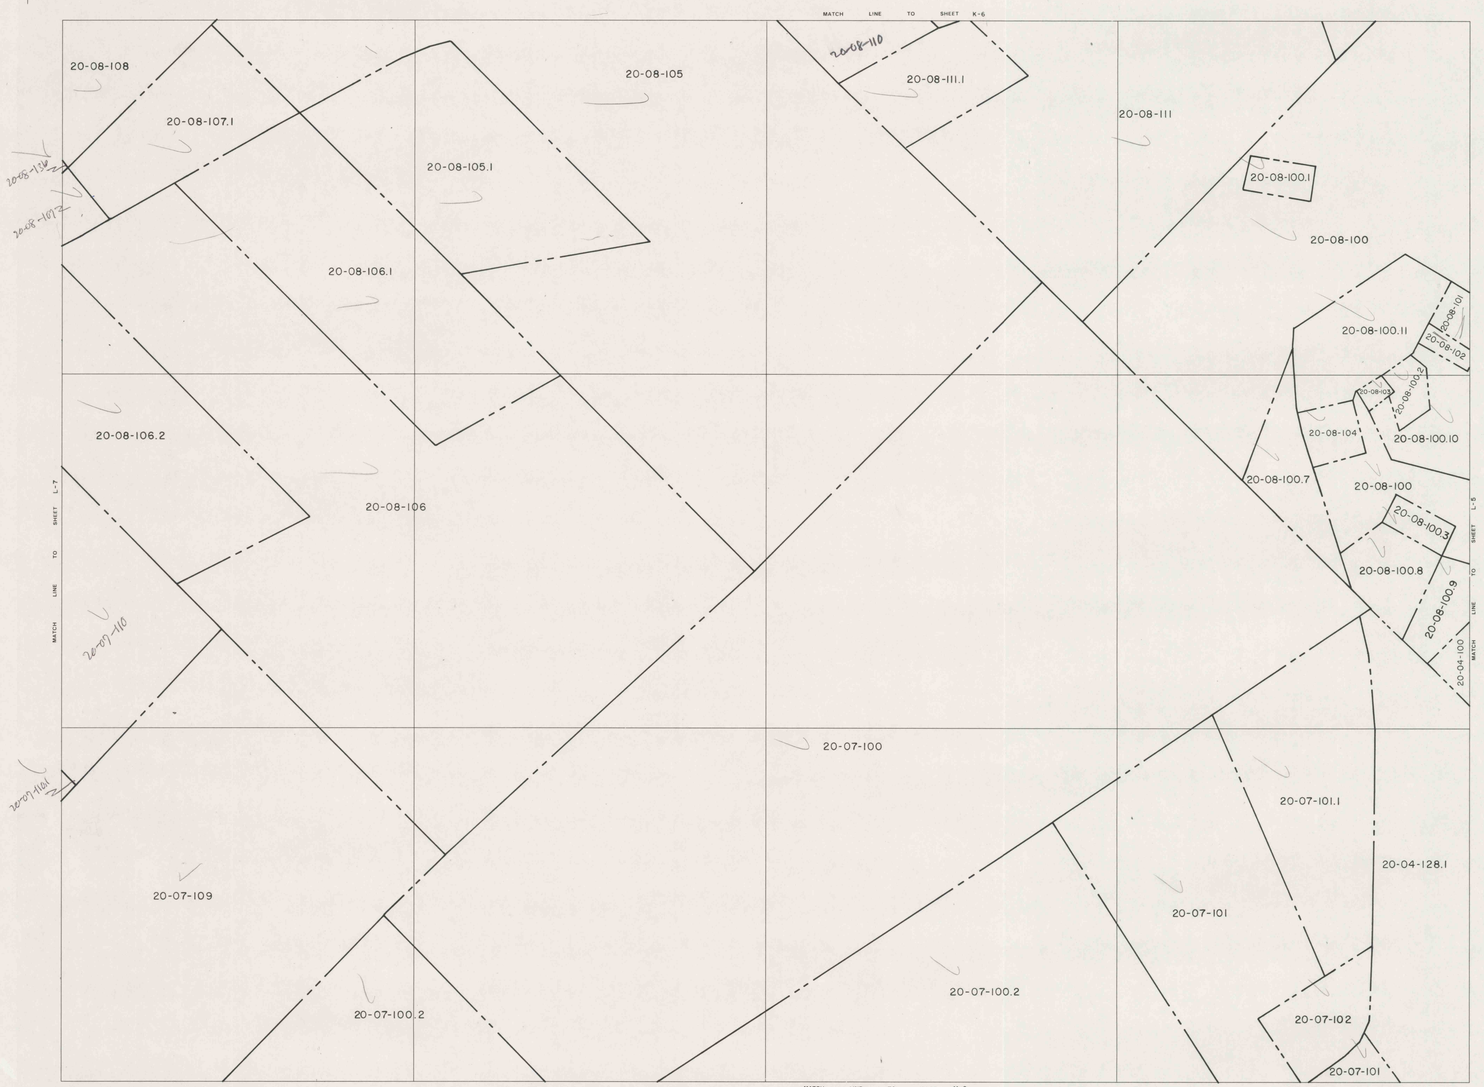

NOTE:
BOUNDARY LINES AND LOT DIMENSIONS WERE INTERPRETED FROM AERIAL PHOTOGRAPHS, COUNTY TAX MAPS, AND EXISTING COUNTY RECORDS. AT NO TIME WERE MEASUREMENTS VERIFIED BY FIELD SURVEYS.

DER COAL MINING ACTIVITY PERMIT NO. 3788/702

GREENWICH COLLIERIES
MINE NO. 1 U.S.B.M. No. 36-02405-0
MINE NO. 2 U.S.B.M. No. 36-02404-0
MAIN COMPLEX U.S.B.M. No. 36-05031
Location GREEN TWP., INDIANA CO., PA
Address Box 367 EBENSBURG, PA 15931

GREENWICH
SURFACE OWNERSHIP
SCALE 1" 200' SHEET L-6
INDIANA & CAMBRIA COUNTIES

RECEIVED
DIVISION OF MINE SUBSIDENCE REGULATION
DEC 13 1985
McMURRAY, PA